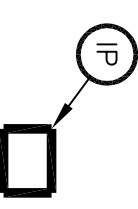

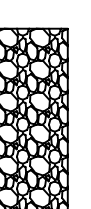
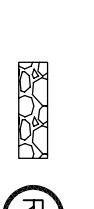
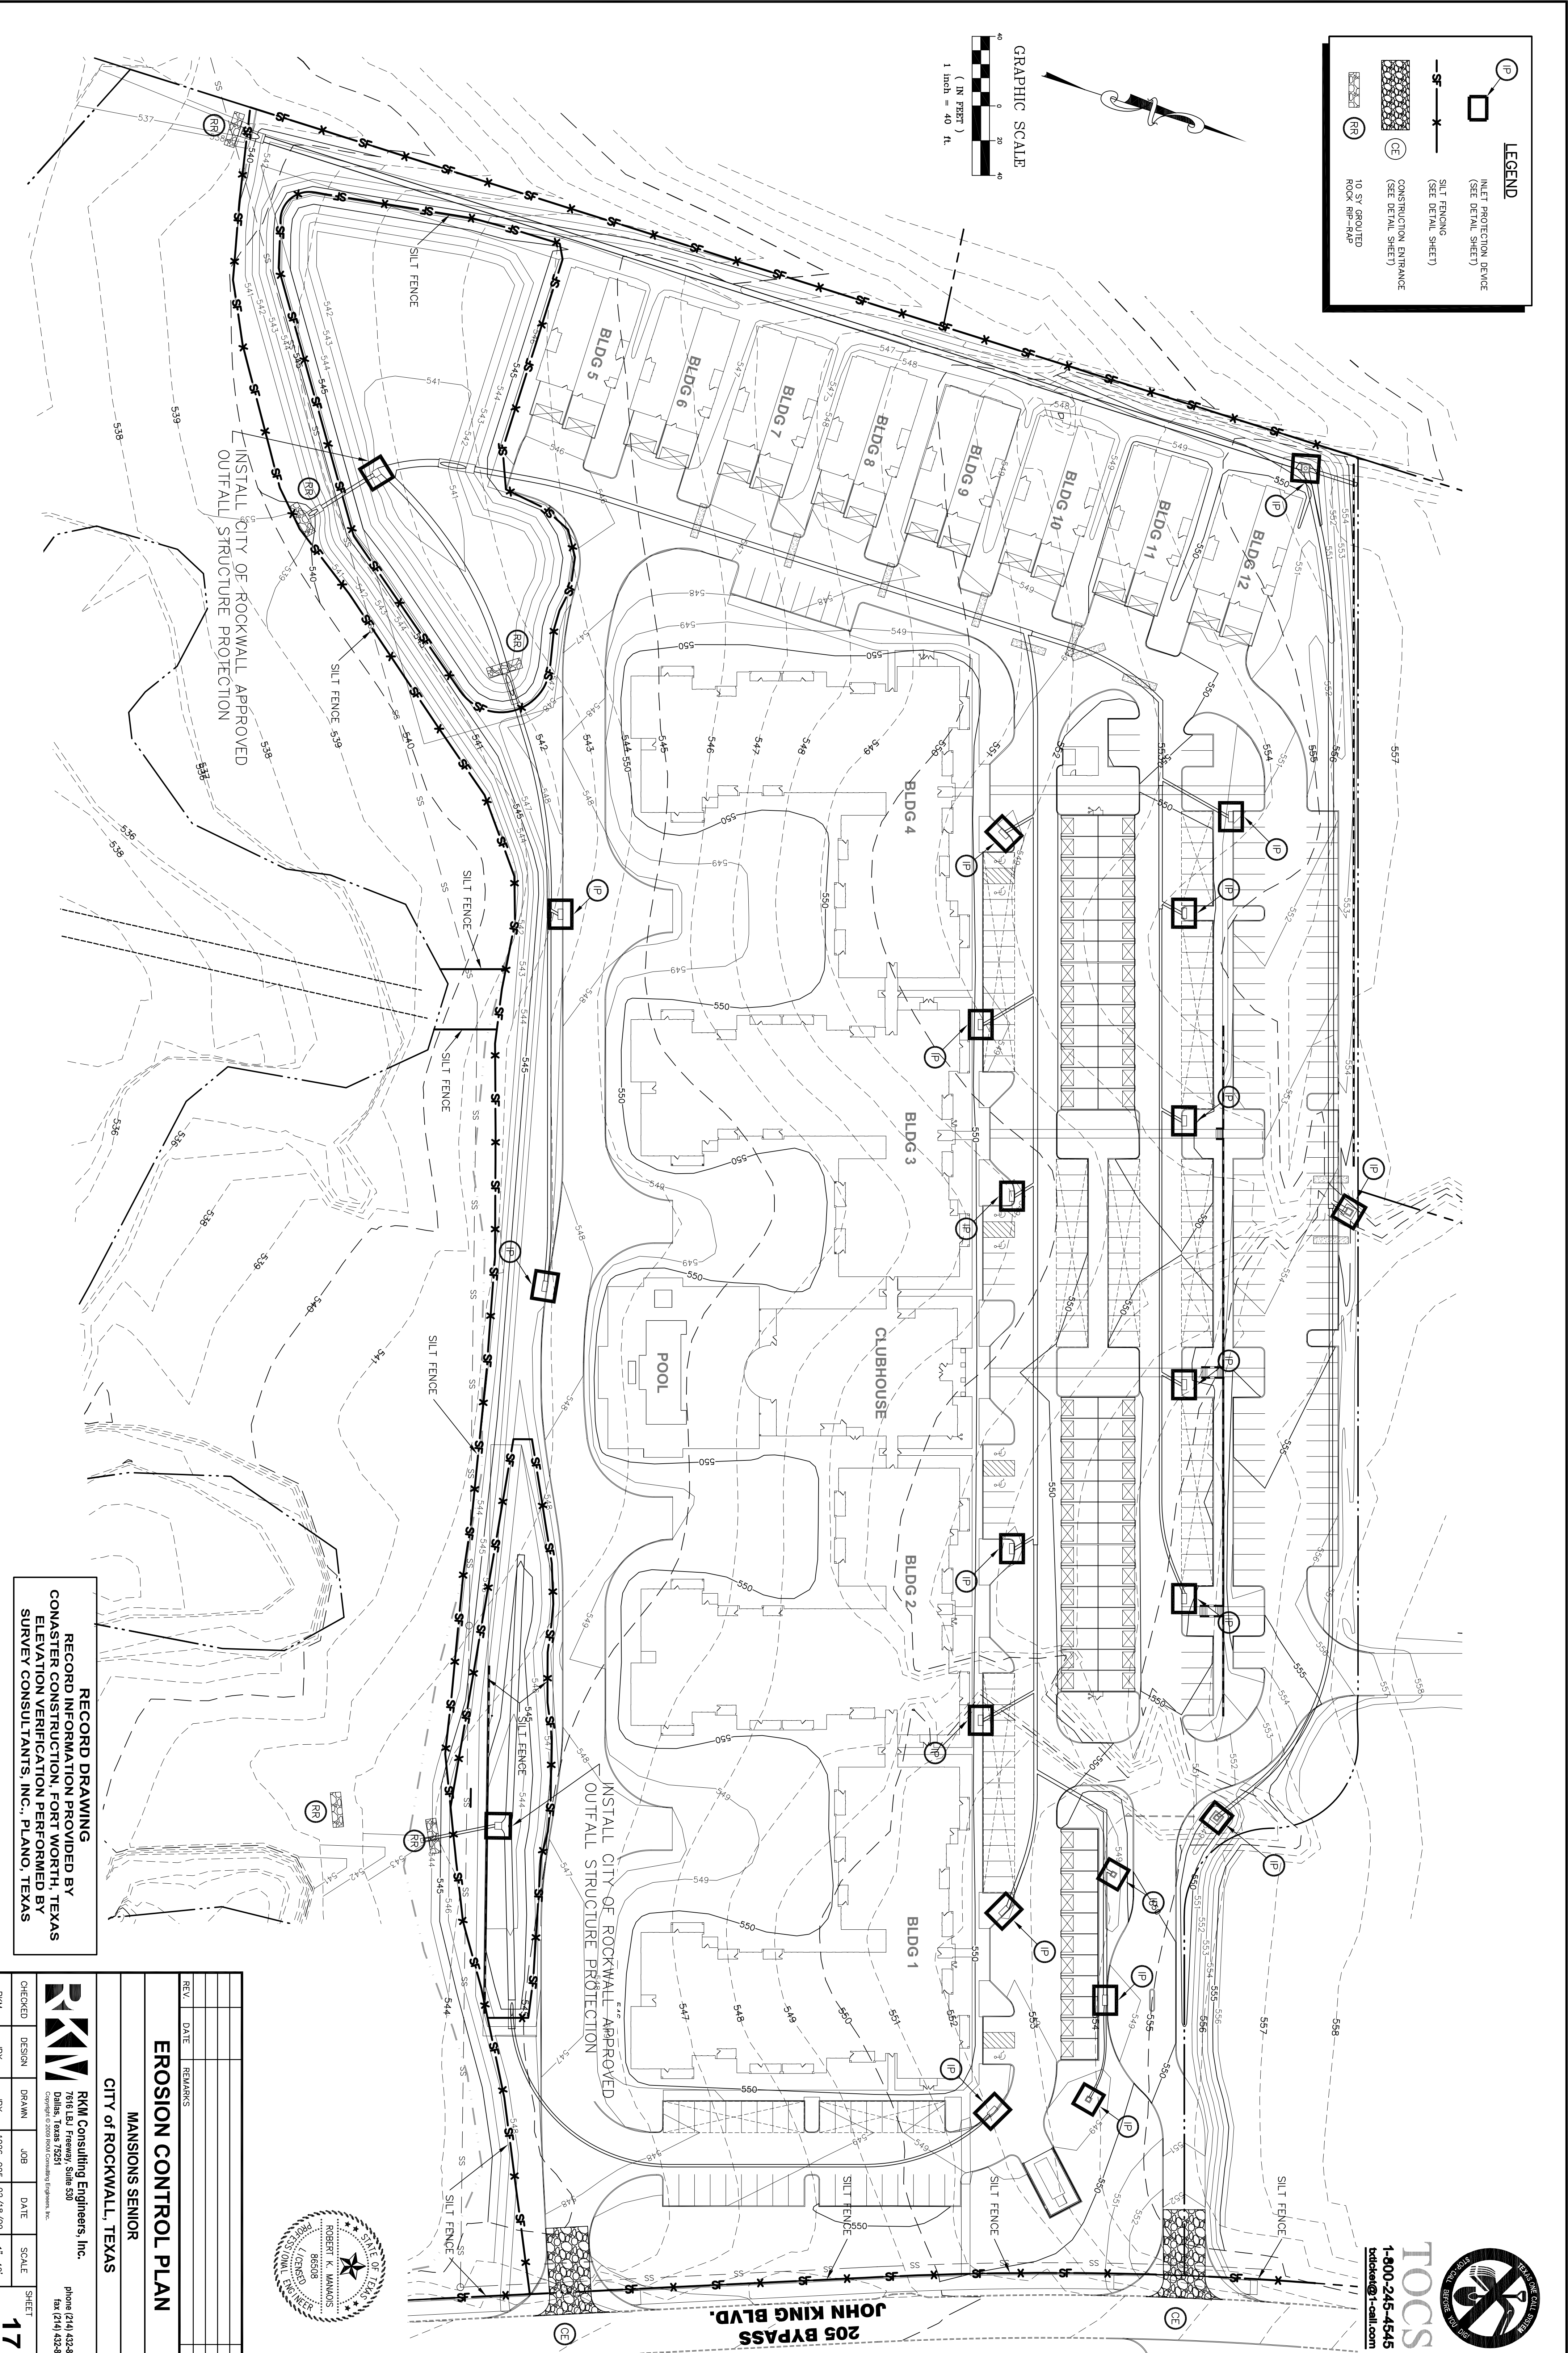
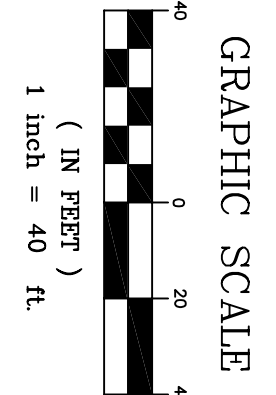
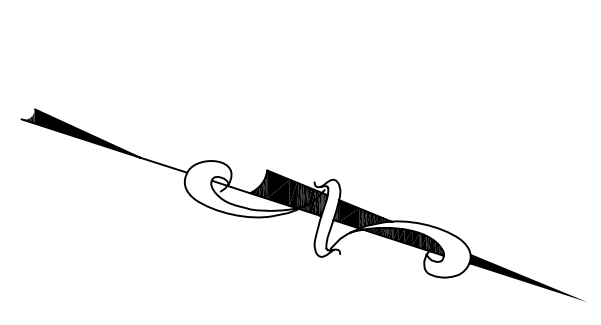


LEGEND

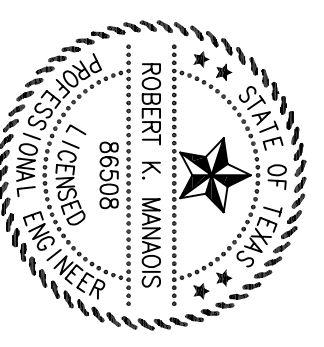
-  INLET PROTECTION DEVICE (SEE DETAIL SHEET)
-  SILT FENCE (SEE DETAIL SHEET)
-  CONSTRUCTION ENTRANCE (SEE DETAIL SHEET)
-  10 SY GROUTED ROCK RIP-RAP



INSTALL CITY OF ROCKWALL APPROVED
OUTFALL STRUCTURE PROTECTION

INSTALL CITY OF ROCKWALL APPROVED
OUTFALL STRUCTURE PROTECTION

RECORD DRAWING
RECORD INFORMATION PROVIDED BY
CONASTER CONSTRUCTION, FORT WORTH, TEXAS
ELEVATION VERIFICATION PERFORMED BY
SURVEY CONSULTANTS, INC., PLANO, TEXAS



TOCS
1-800-245-4545
tocs@tocs1-call.com

REV.	DATE	REMARKS	BY

EROSION CONTROL PLAN

MANSIONS SENIOR
CITY OF ROCKWALL, TEXAS

RKM Consulting Engineers, Inc.
7616 LBJ Freeway, Suite 500
Dallas, Texas 75247
phone (214) 432-8070
fax (214) 432-8069

CHECKED	DESIGN	DRAWN	JOB	DATE	SCALE	SHEET
RKM	JRY	JRY	1026-005	02/18/09	1"=40'	17 OF 20