


CONSTRUCTION PLANS for MARKET CENTER DRIVE

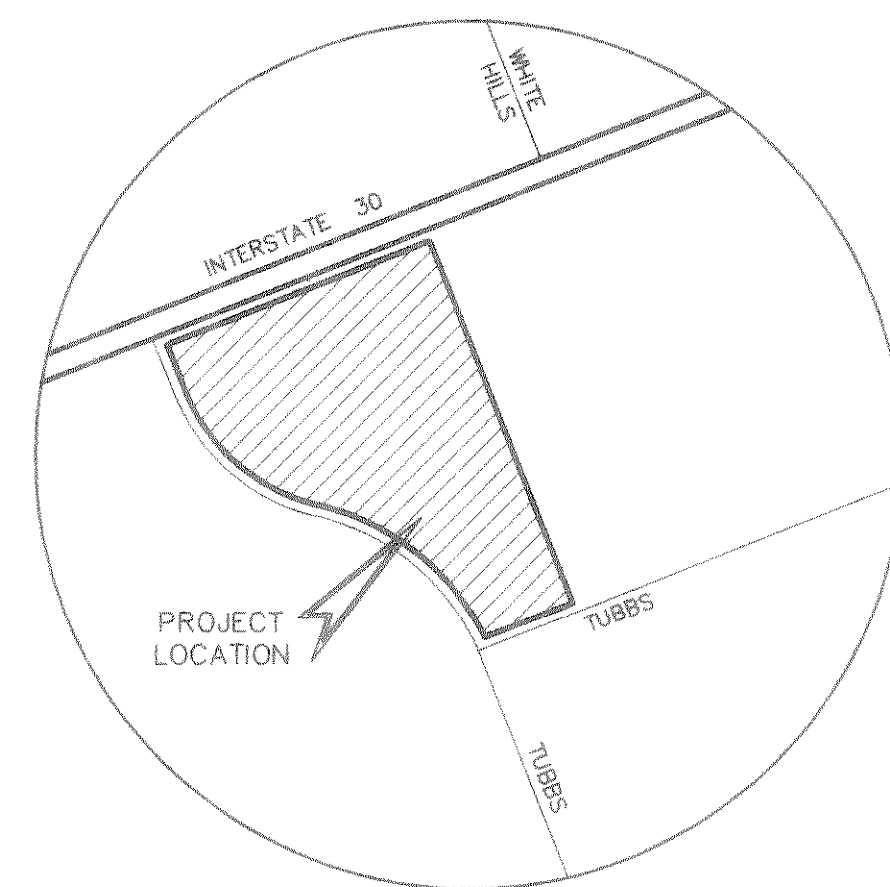

LOCATION MAP
MAPSCO PAGE 30C-G
LOCATION MAP
N.T.S.

PROJECT DIRECTORY

CITY OF ROCKWALL
205 W. RUSK
ROCKWALL, TEXAS 75087-3699
(972) 771-7700

CLIENT:
HOME DEPOT USA, INC.
2800 FOREST LANE
DALLAS, TEXAS 75229
(972) 402-3920 DAVE CASSMAN

T.U. ELECTRIC
RON JORDAN
124 WEST DAVIS
MESQUITE, TEXAS 75149
(972) 216-2810

LONE STAR GAS
DINAH WOOD
1310 HWY. 66
GARLAND, TEXAS 75040
(972) 573-3704

ARCHITECT:
JAMES A. SCHMITT
CASCO CORPORATION
10877 WATSON ROAD
ST. LOUIS, MISSOURI 63127
(314) 821-1100

SOUTHWESTEN BELL
DALE INGERSOLL
1255 TAVAROS #306
DALLAS, TEXAS 75218
(972) 402-3920 DAVE CASSMAN

IN ROCKWALL, TEXAS

INDEX

1	COVER SHEET
2-3	FINAL PLAT
4	GENERAL NOTES
C-1	ROADWAY PLAN & PROFILE & WATER PLAN
C-1A	PAVING PLAN- I.H.30 CONNECTION
C-2	ROADWAY PLAN & PROFILE & WATER PLAN
C-3	ROADWAY PLAN & PROFILE & WATER PLAN
C-4	STORM WATER POLLUTION PREVENTION PLAN
C-5	STORM WATER POLLUTION PREVENTION DETAILS
C-6	STORM SEWER PLAN
C-7	STORM SEWER PLAN
C-8	STORM SEWER PROFILES
C-9	STORM SEWER PROFILES
C-10	DRAINAGE AREA MAP
C-11	POND #3 & JUNCTION BOX DETAILS

ASBUILT

Winkelmann & Associates, Inc. hereby states that this plan, to the best of our knowledge is "As Built." Modifications from the originally approved construction documents have been made as per information provided by the contractor. Winkelmann & Associates, Inc. does not certify as to the correctness or quality of construction as no field inspection was performed.
Winkelmann & Associates, Inc. 5-13-98
DATE

Michael D. Clark
MICHAEL D. CLARK
63290
REGISTERED
SURVEYOR
9-1-97

Winkelmann & Associates, Inc.

CONSULTING CIVIL ENGINEERS ■ SURVEYORS
12800 HILLCREST ROAD, SUITE 200 (972) 490-7090
DALLAS, TEXAS 75230 FAX (972) 490-7099

MARKET CENTER DRIVE - ROCKWALL

10/18/97