
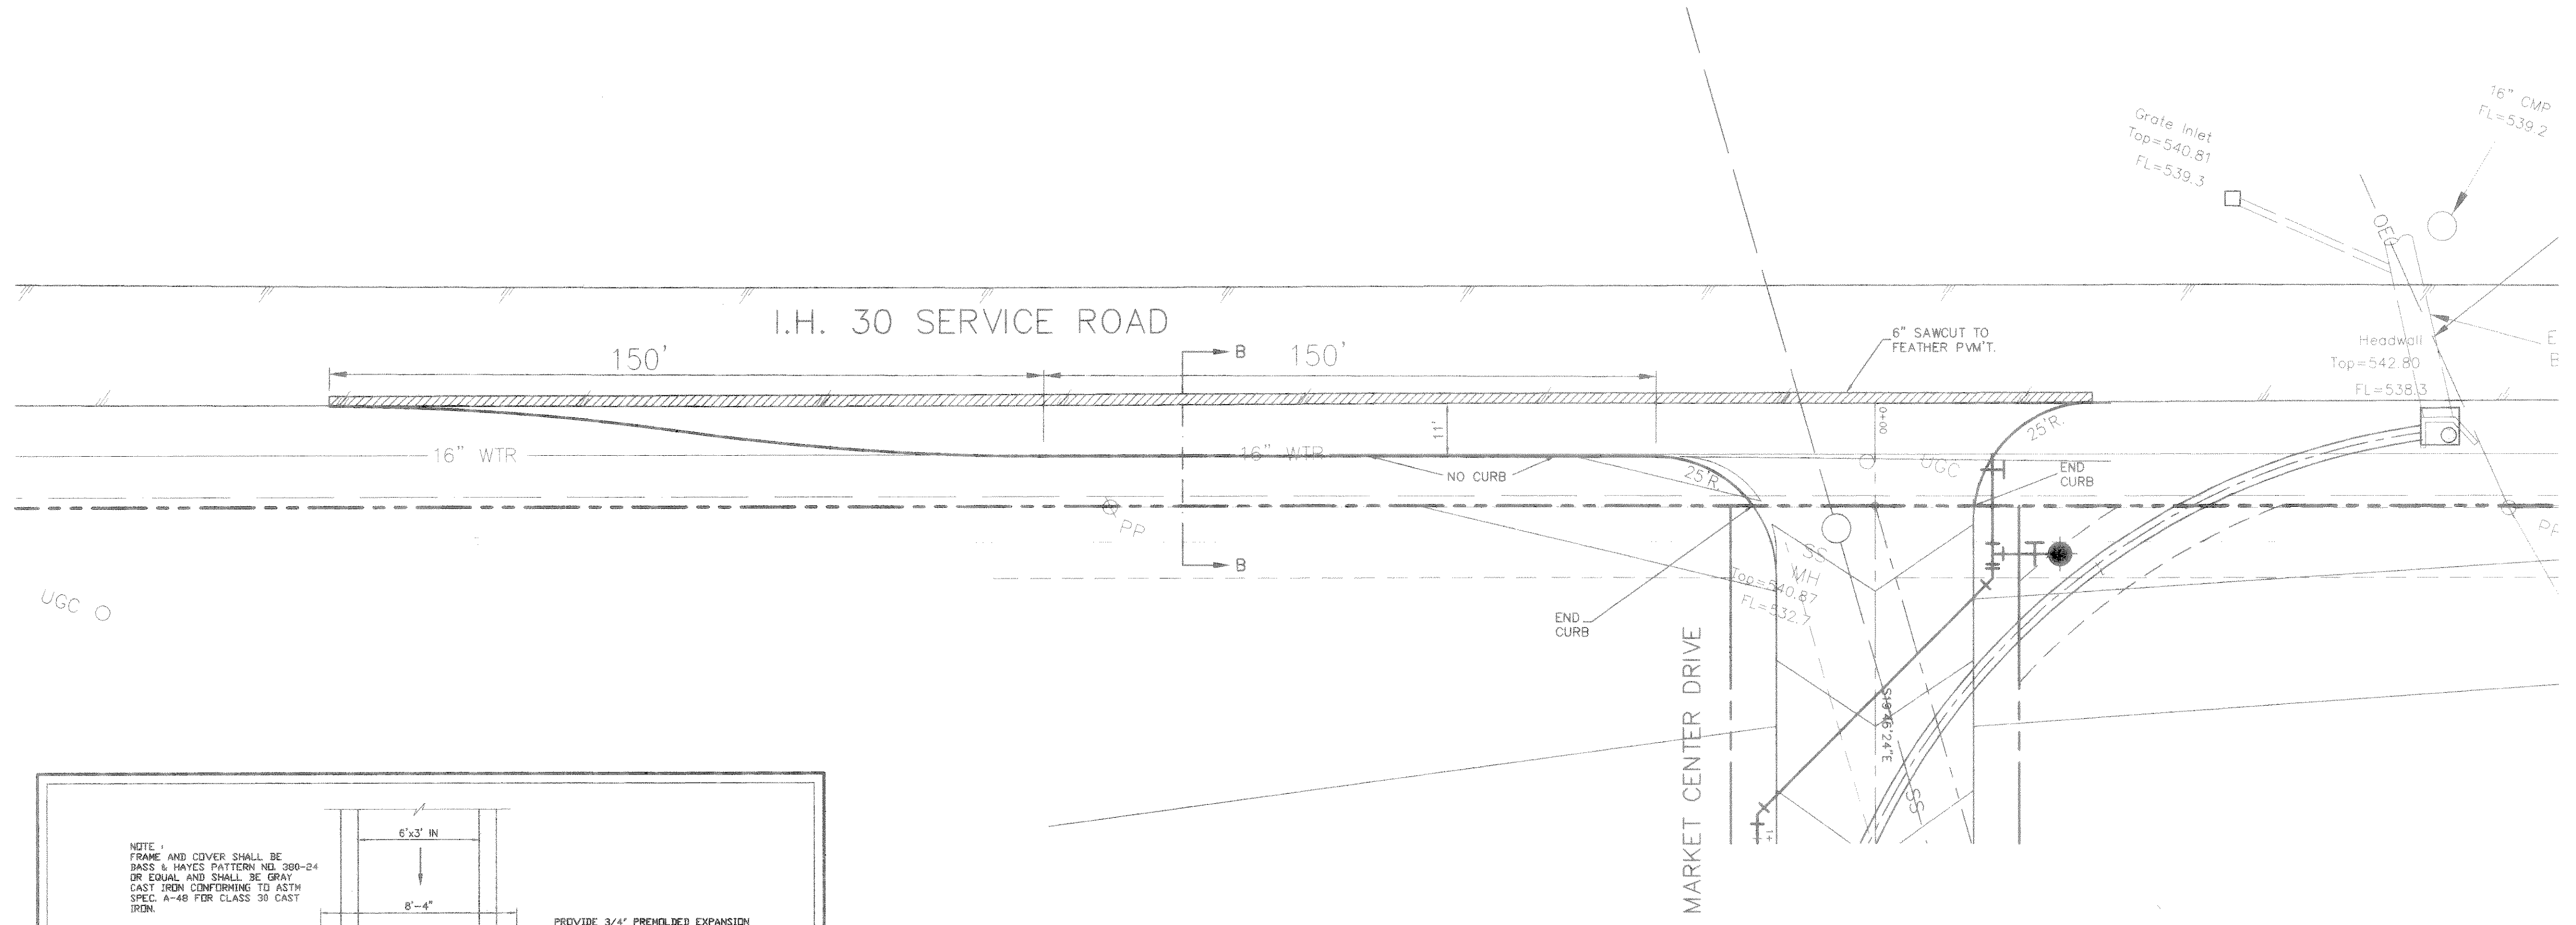


E.P. GAINES CIVIL SURVEY, ABST. No. 64
 CITY OF ROCKWALL, TEXAS
 HOME DEPOT, U.S.A., INC.
 2800 FOREST LANE
 DALLAS, TEXAS 75234

PAVING PLAN - I.H. 30 CONNECTION
 MARKET CENTER DRIVE

Scale: 1" = 20' Date: 9/11/97
 Designed By: M.D.C.
 Drawn By: R.D.L.
 Checked By: M.D.C.
 File: 07939DEC.DWG
 Project No.: 07939/01201

SHEET
C-1A
 OF
 16

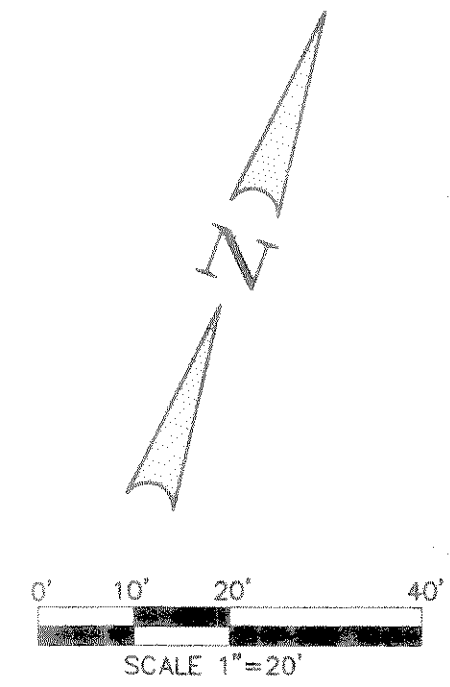

NOTE:
 REFER TO SHEET 4 FOR
 GENERAL NOTES.

LEGEND

PP	Power Pole
GW	Guy Wire
MH	Manhole
WV	Water Valve
TP	Telephone Pedestal
WM	Water Meter
FH	Fire Hydrant
LP	Light Pole
IV	Irrigation Valve
CO	Clean Out
AC	Air Conditioner
CB	Cable Box
SB	Signal Box
SP	Signal Pole
SN	Sign
MW	Monitor Well
GB	Bore Hole

BENCHMARK
 City of Rockwall GPS Monument # 7 located east of
 MIMS ROAD along the southerly side of INTERSTATE
 HIGHWAY NO. 30 (Elevation = 566.25)

ASBUILT
 Winkelmann & Associates, Inc. hereby states that this
 plan, to the best of our knowledge is "As Built."
 Modifications from the originally approved construction
 documents have been made as per information provided by
 the contractor. Winkelmann & Associates, Inc. does not
 certify as to the correctness or quality of construction as no
 field inspection was performed.
 [Signature] 5-12-98
 WINKELMANN & ASSOCIATES, INC. DATE

