


CONSTRUCTION PLANS for

MARKET CENTER DRIVE IN

ROCKWALL, TEXAS

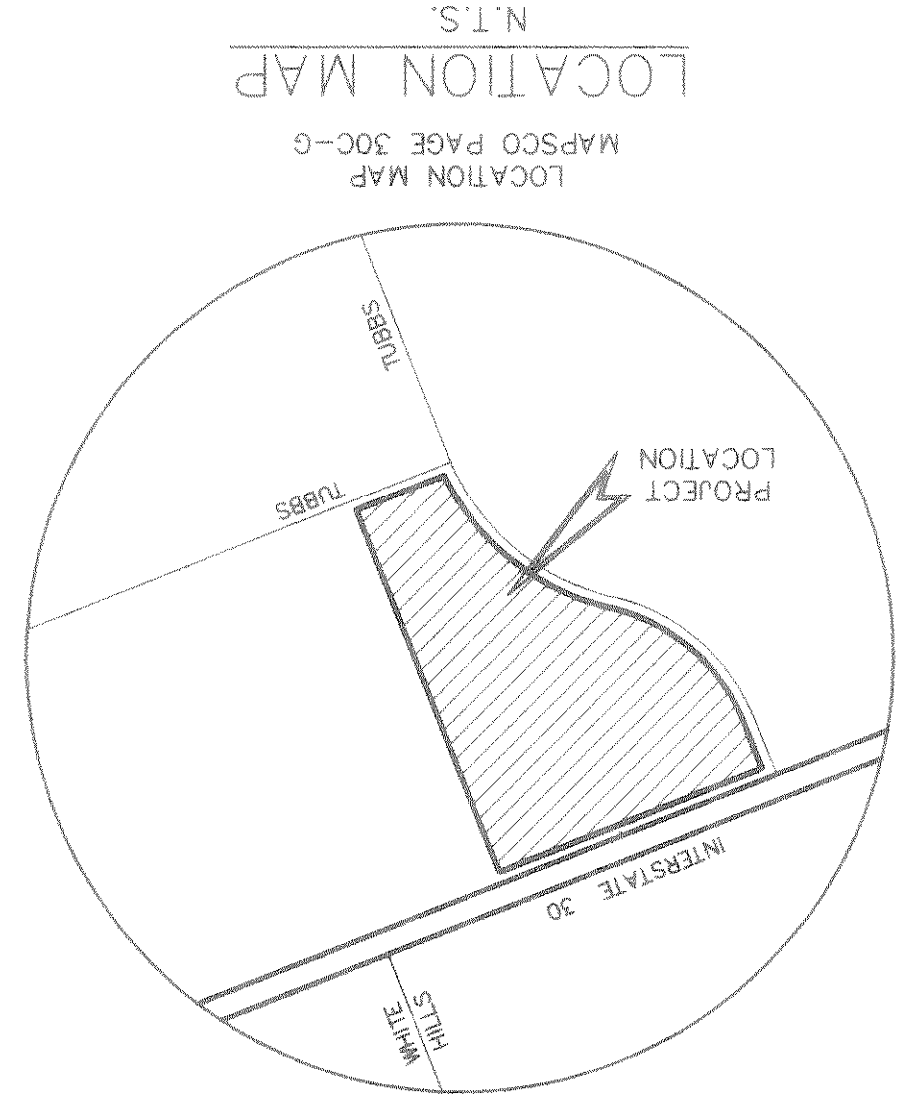

PROJECT DIRECTORY

CITY OF ROCKWALL
205 W. RUSK
ROCKWALL, TEXAS 75087-3699
(972) 771-7700

CLIENT:
HOME DEPOT USA, INC.
2800 FOREST LANE
DALLAS, TEXAS 75229
(972) 402-3920 DAVE CASSMAN

T.U. ELECTRIC
124 WEST DAVIS
MESQUITE, TEXAS 75149
(972) 216-2810

LONE STAR GAS
DINAH WOOD
1310 HWY. 66
GARLAND, TEXAS 75040
(972) 573-3704



ARCHITECT:
JAMES A. SCHMITT
CASCO CORPORATION
10877 WATSON ROAD
ST. LOUIS, MISSOURI 63127
(314) 821-1100

SOUTHWESTERN BELL
DALE INGERSOLL
1255 TAVAROS #306
DALLAS, TEXAS 75218
(972) 402-3920 DAVE CASSMAN

1	COVER SHEET
2-3	FINAL PLAN
4	GENERAL NOTES
C-1	ROADWAY PLAN & PROFILE & WATER PLAN
C-1A	PAVING PLAN-I.H.30 CONNECTION
C-2	ROADWAY PLAN & PROFILE & WATER PLAN
C-3	ROADWAY PLAN & PROFILE & WATER PLAN
C-4	STORM WATER POLLUTION PREVENTION PLAN
C-5	STORM WATER POLLUTION PREVENTION DETAILS
C-6	STORM SEWER PLAN
C-7	STORM SEWER PLAN
C-8	STORM SEWER PROFILES
C-9	STORM SEWER PROFILES
C-10	DRAINAGE AREA MAP
C-11	POND #3 & JUNCTION BOX DETAILS

INDEX

Winkelmann & Associates, Inc.
CONSULTING CIVIL ENGINEERS ■ SURVEYORS
12800 HILLCREST ROAD, SUITE 200
DALLAS, TEXAS 75230
FAX (972) 490-7090

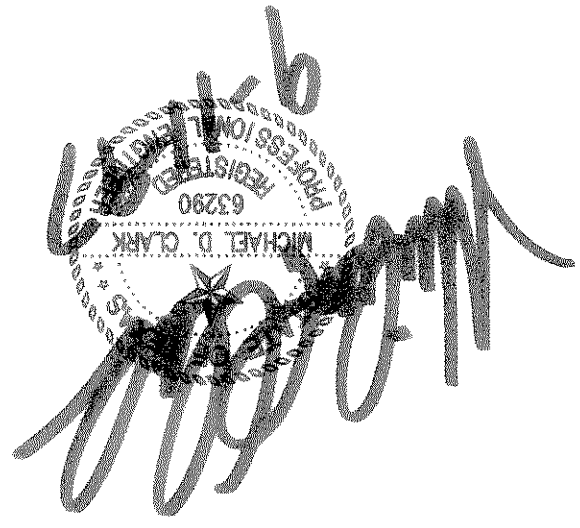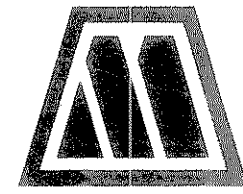

Winkelmann & Associates, Inc. hereby states that this plan, to the best of our knowledge as the Draft Engineer, has been prepared in accordance with the standards of professional practice and the requirements of the State of Texas. We warrant that the information provided by us is true and correct and that we are duly licensed and qualified to perform the services herein. We warrant that the information provided by us is true and correct and that we are duly licensed and qualified to perform the services herein.

DATE: 5-13-98

ASBUILT