


PAVING & CURVE TABLE

CH. LENGTH	CH. BRG.	TANGENT LENGTH	RADIUS	DELTA
640.74'	S22°02'46"E	527.92'	378.90'	64°32'43"
600.00'	S78.90°	675.92'	527.92'	64°32'43"

NOTE: SEE DRAINAGE PLANS FOR STORM SEWER DATA.

CAUTION: THE CONTRACTOR SHALL CONTACT MR. JOE STANKIEWICZ, ENGINEERING OFFICER, AT (972) 442-5405, AT LEAST 48 HRS. PRIOR TO PERFORMING ANY WORK IN THE VICINITY OF NIMWD. INSPECTION SHALL BE MADE BEFORE AND AFTER CONSTRUCTION BY THE OWNER. NIMWD SHALL BE NOTIFIED PRIOR TO EACH TV INSPECTION. NIMWD SHALL BE FURNISHED WITH A COPY OF THE VIDEO TAPE IN VHS FORMAT. ANY COST FOR REPAIR OF DAMAGE TO THE NIMWD PIPELINE RESULTING FROM CONSTRUCTION ACTIVITIES WILL BE THE RESPONSIBILITY OF THE OWNER.

- LEGEND
- PP Power Pole
 - GW Guy Wire
 - WH Manhole
 - WM Water Valve
 - TP Telephone Pedestal
 - MM Water Meter
 - TH Tree Hight
 - LI Light Pole
 - IV Irrigation Valve
 - AC Air Conditioner
 - CB Cable Box
 - SB Signal Box
 - SN Sign
 - MW Monitor Well
 - GB Bore Hole

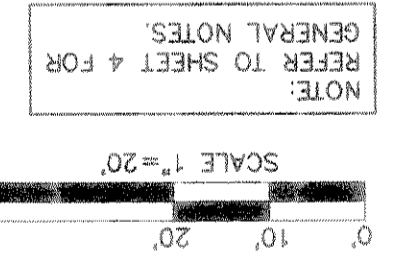

NOTE: REFER TO SHEET 4 FOR GENERAL NOTES.

SCALE 1"=20'


NO.	DATE	REVISION	APPROV.
1	12-11-97	WATER LINE CHANGES	M.D.C.
2	01-20-98	ROAD GRADE CHANGE	M.D.C.

Scale: 1"=20'
 Date: 9/09/97
 Designed By: M.D.C.
 Drawn By: R.D.L.
 Checked By: M.D.C.
 File: 07939PFS.DWG
 Project No.: 07939.01(20)

PAVING PLAN & PROFILE & WATER PLAN
 MARKET CENTER DRIVE

E.P. GAINES CHISUM SURVEY, ABST. NO. 64
 CITY OF ROCKWALL, TEXAS
 HOME DEPOT U.S.A., INC.
 2800 FOREST LANE
 DALLAS, TEXAS 75234

NOTE: REFER TO SHEET 4 FOR GENERAL NOTES.

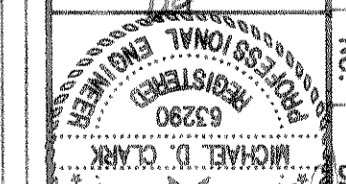

Winkelmann & Associates, Inc.
 CONSULTING CIVIL ENGINEERS & SURVEYORS
 12000 Westheimer Road, Suite 200
 Houston, Texas 77040
 (713) 466-0289 fax

Winkelmann & Associates, Inc. hereby states that the plan, to the best of our knowledge, is the true and correct representation of the field conditions. We warrant that the information provided herein is true and correct to the best of our knowledge and belief. We warrant that the information provided herein is true and correct to the best of our knowledge and belief. We warrant that the information provided herein is true and correct to the best of our knowledge and belief.

BENCHMARK
 City of Rockwall GPS Monument # 7 located east of MIMS ROAD along the southern side of INTERSTATE HIGHWAY NO. 30 (Elevation = 566.25')