

BENCHMARK
City of Rockwall GPS Monument #7 located east of
MIMS ROAD along the southern side of INTERSTATE
HIGHWAY NO. 30 (Elevation = 566.25)

LEGEND

PP	Power Pole
WP	Water Valve
WH	Manhole
GW	Guy Wire
TP	Telephone Pedestal
WM	Water Meter
FH	Fire Hydrant
LP	Light Pole
IV	Irrigation Valve
CO	Clean Out
AC	Air Conditioner
TV	Television
SB	Sign Box
SP	Sign Pole
SN	Sign
MW	Monitor Well
SB	Bore Hole

NOTE:
REFER TO SHEET 4 FOR
GENERAL NOTES.

Winkelmann & Associates, Inc. hereby states that this plan, to the best of our knowledge is "As Built," and indicates from the originally approved construction documents have been made as per information provided by the contractor. Winkelmann & Associates, Inc. does not certify as to the correctness or quality of construction as no field inspection was performed.


WINKELMANN & ASSOCIATES, INC.
DATE: 5-17-98



16 OF 17 SHEETS
Scale: 1" = 20'
Date: 9/14/97
Designed By: M.D.C.
Drawn By: R.D.L.
Checked By: M.D.C.
File: 07939DEC.DWG
Project No.: 07939 0120

PAVING PLAN - I.H. 30 CONNECTION
MARKET CENTER DRIVE

E.P. GAINES CONSULTING SERVICES, A881 No. 64
ROCKWALL COUNTY, TEXAS
HOME DEPOT, U.S.A., INC.
2800 FOREST LANE
DALLAS, TEXAS 75234

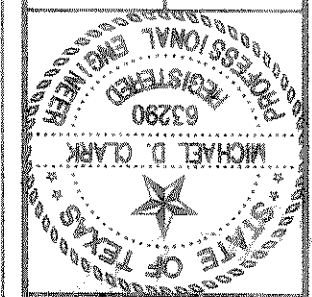

Winkelman & Associates, Inc.
CONSULTING CIVIL ENGINEERS & SURVEYORS
13000 Highway 100, Suite 200
Dallas, Texas 75240
(214) 342-7000 FAX