
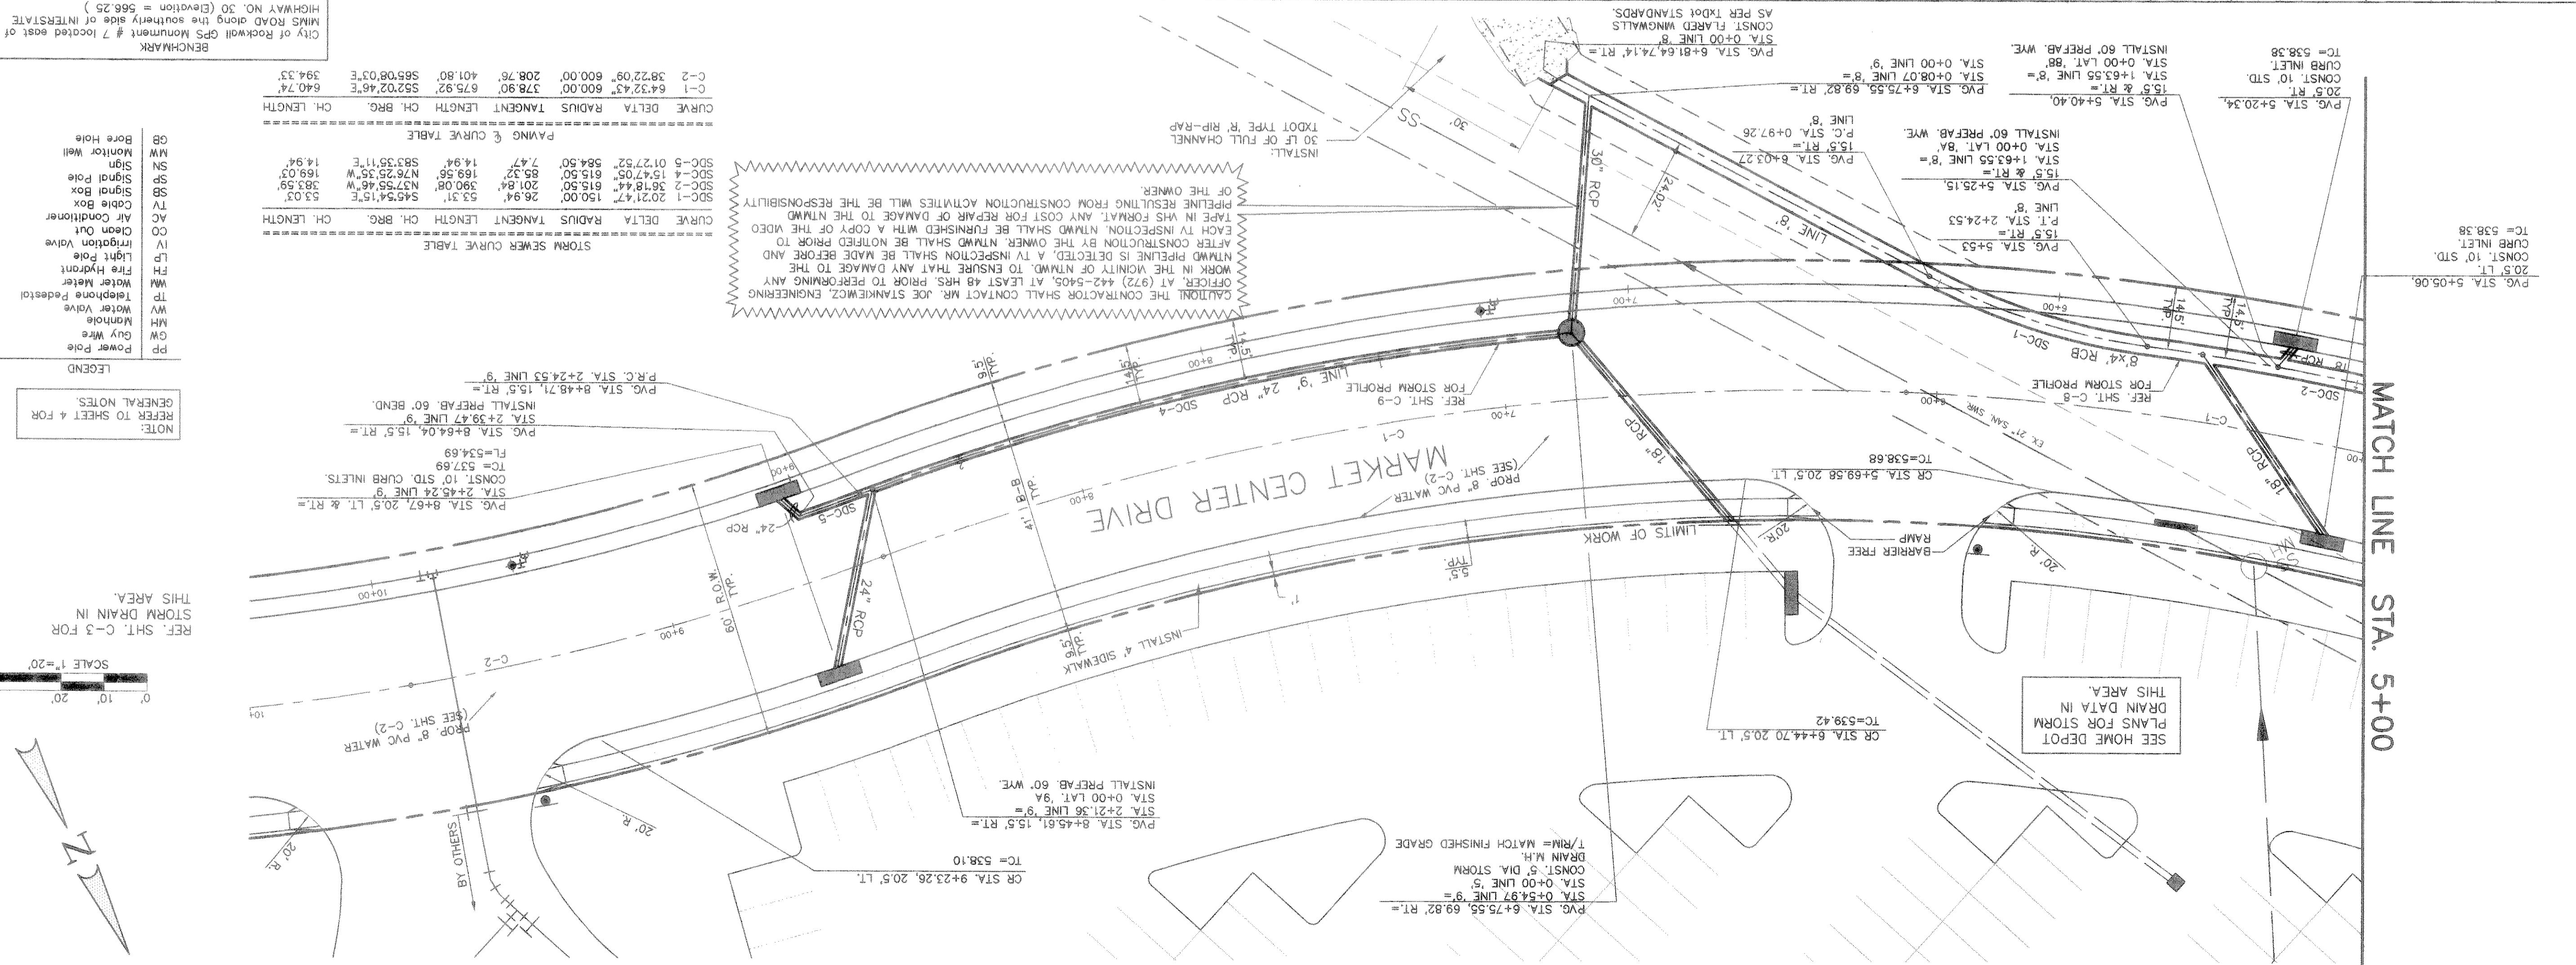


REFERENCE SHEET C-8 & C-9 FOR STORM SEWER PROFILES

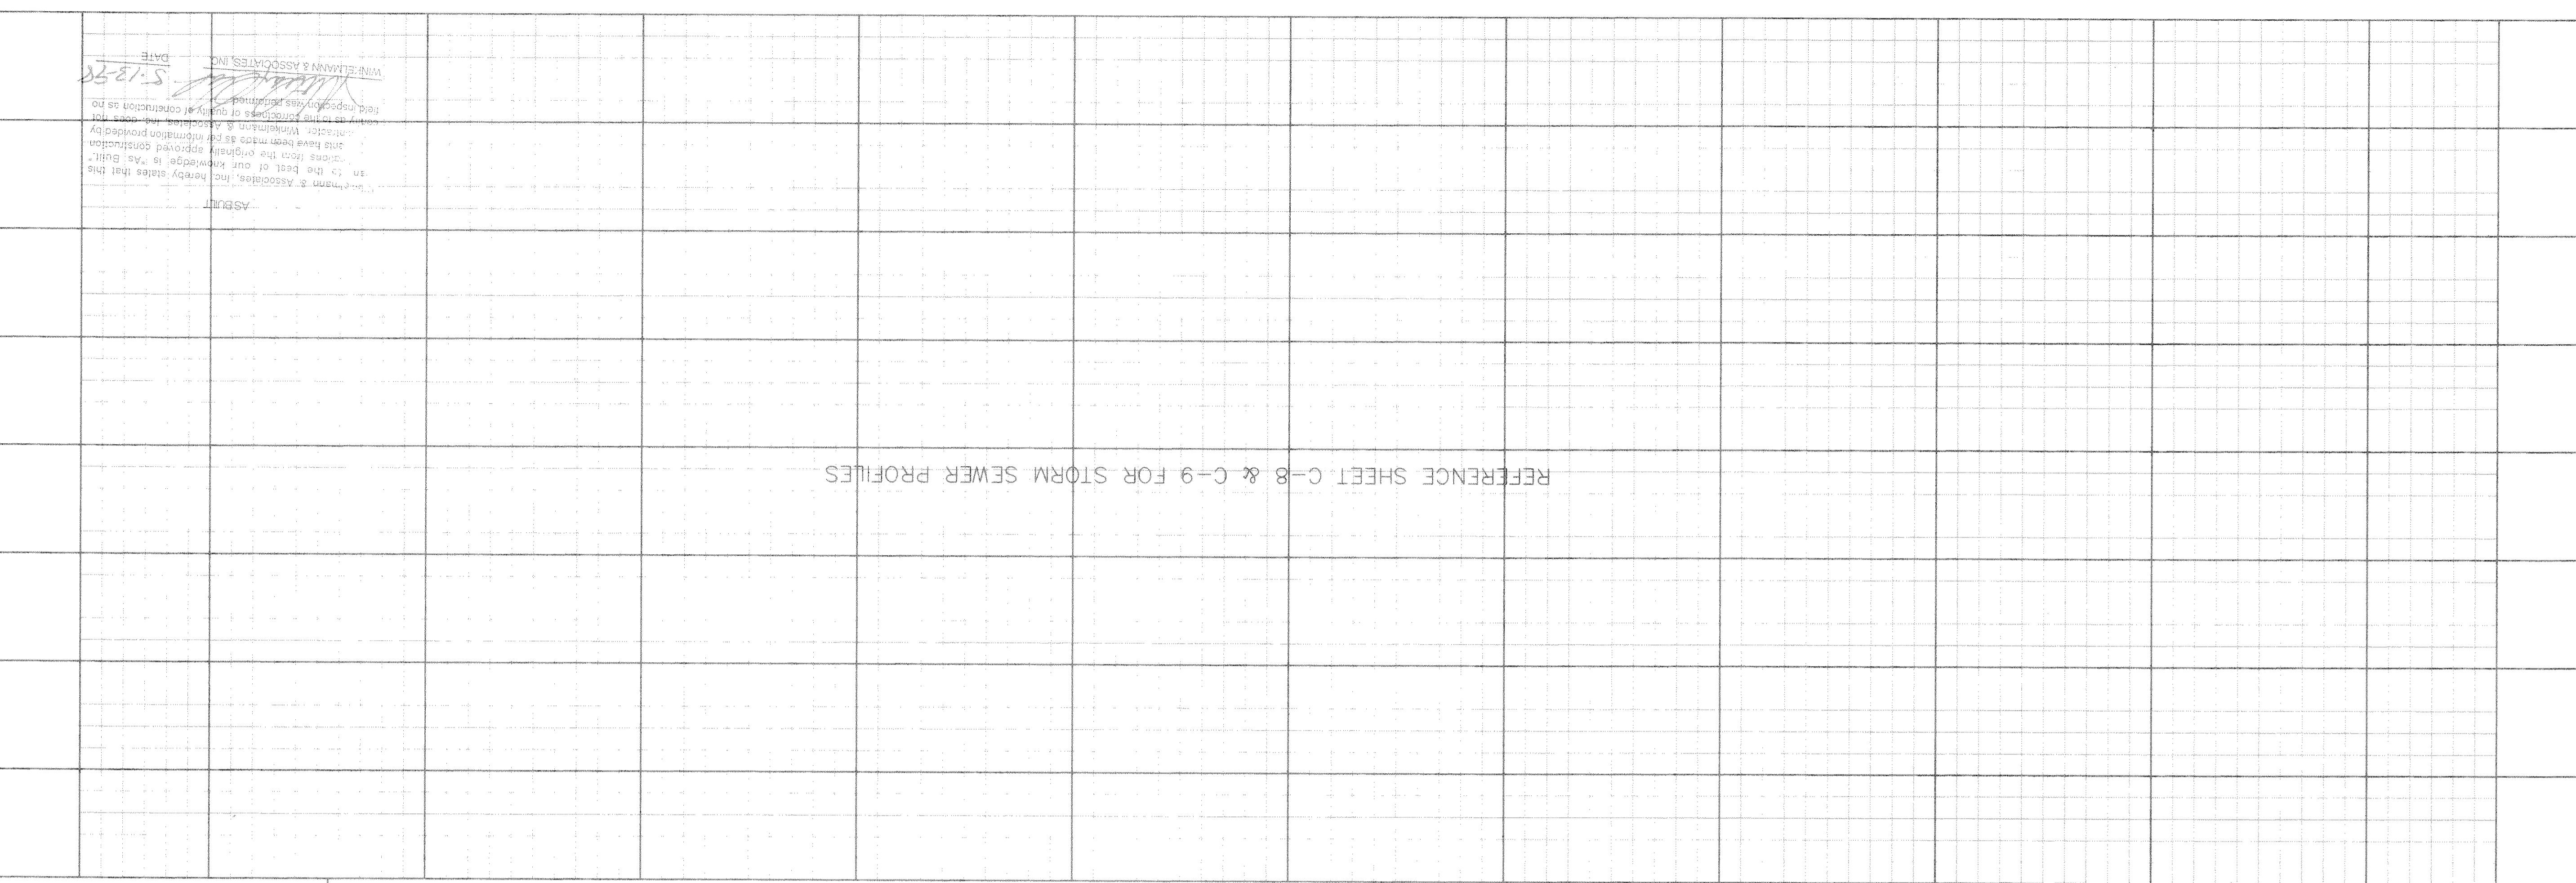

PAVING & CURVE TABLE

CH. LENGTH	CH. BRG.	TANGENT LENGTH	RADIUS	DELTA	CURVE
640.74	552.02	401.80	378.90	64.22	C-2
394.33	365.08	401.80	378.90	64.22	C-1

STORM SEWER CURVE TABLE

CH. LENGTH	CH. BRG.	TANGENT LENGTH	RADIUS	DELTA	CURVE
53.03	545.54	26.94	201.84	20.21	SDC-1
168.03	75.46	300.08	169.58	36.18	SDC-2
14.94	583.35	7.47	14.94	0.17	SDC-5

LEGEND

- PP Power Pole
- GW Guy Wire
- MH Manhole
- WV Water Valve
- TP Telephone Pedestal
- WM Water Meter
- TH Fire Hydrant
- LP Light Pole
- IV Irrigation Valve
- CO Clean Out
- AC Air Conditioner
- TV Cable Box
- SB Signal Box
- SN Signal Pole
- SN Sign
- MW Monitor Well
- GB Bore Hole

NOTE: REFER TO SHEET 4 FOR GENERAL NOTES

SEE HOME DEPOT PLANS FOR STORM DRAIN DATA IN THIS AREA.

SCALE 1"=20'

REF. SHT. C-3 FOR STORM DRAIN IN THIS AREA.


CITY OF ROCKWALL GPS Monument # 7 located east of HIGHWAY NO. 30 (Elevation = 566.25)

BENCHMARK

Scale: 1"=20' Date: 12/29/97  
 Drawn By: MJC  
 Checked By: MJC  
 Title: 0793951P.DWG  
 Project No.: 07939(0120)

STORM SEWER PLAN  
 MARKET CENTER DRIVE

E.P. GAMES CHISUM SURVEY, ABST. No. 64  
 CITY OF ROCKWALL  
 ROCKWALL COUNTY, TEXAS  
 HOME DEPOT U.S.A., INC.  
 2800 FOREST LANE  
 DALLAS, TEXAS 75234

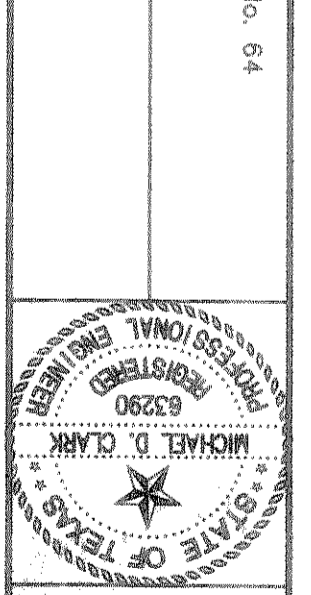

**Winkelman & Associates, Inc.**  
 CONSULTING CIVIL ENGINEERS & SURVEYORS  
 17000 Inwood Road, Suite 200  
 Dallas, Texas 75240  
 (972) 402-7099 FAX