



**1** **DIMENSION CONTROL PLAN**  
SCALE: 1"=20'

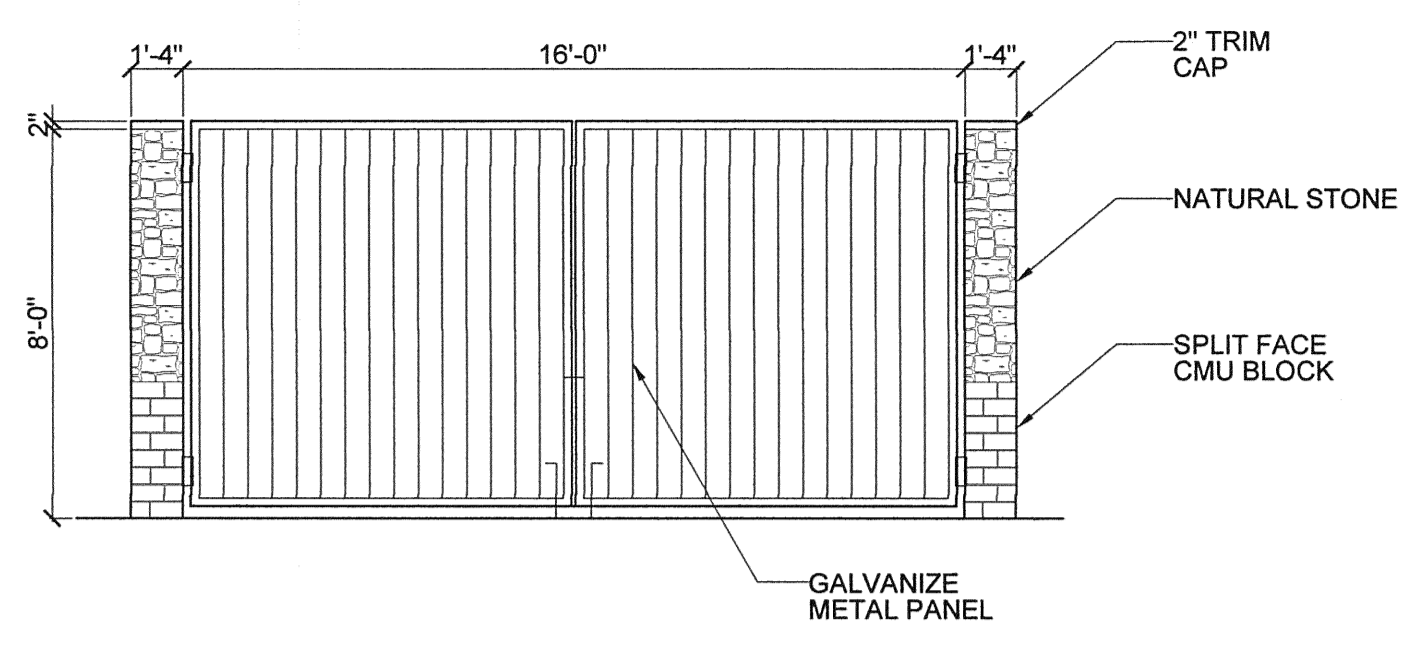

**2** **TRASH FRONT ELEVATION**  
N.T.S.

**AS BUILT**

Email: spham@spob.net  
 Tel. 972-241-4016  
 Fax. 972-241-4018  
**SPDesign & Build Inc.**  
 Consultant Engineers  
 11500 N. Stemmons Freeway, Suite 138 Dallas, TX 75229

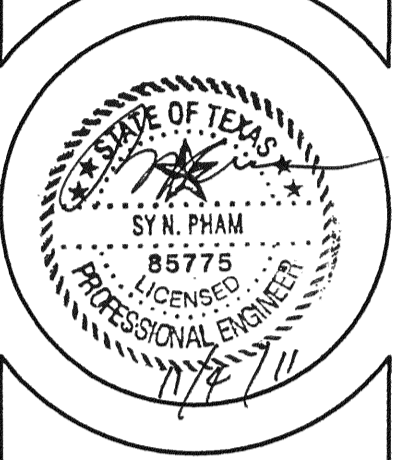

**205 PLAZA**  
 2309-2319 S. GOLIAD  
 ROCKWALL, TEXAS 75087

**DIMENSION CONTROL PLAN**

REVISIONS:

1	07-27-10	PER CITY & RACETRAC COOR.
2	08-02-10	PER CITY COMMENTS
3	09-29-11	AS BUILT

SHEET: **C1**

JOB NO. 0710