



Bench Mark 1
A Standard U.S.C.&G.S. Disk Stamped 'M 929 1946'
Approx. 1.9 miles southeast along State Hwy. 205 from Courthouse at Rockwall to bridge at Buffalo Creek, at the northwest corner of the concrete bridge in the top of the concrete guardrail base approx. 17 feet southwest of the centerline of the highway, and approx. 3 feet southeast of the northwest end of the guardrail base.
Elevation = 524.65

Bench Mark 2
Top of Concrete ROW Marker, approx. 1.6 miles southeast along State Hwy. 205 and then approx. 0.6 miles east along FM 276 to intersection of paved road, at fence corner at southwest quadrant of intersection.
Elevation = 543.10

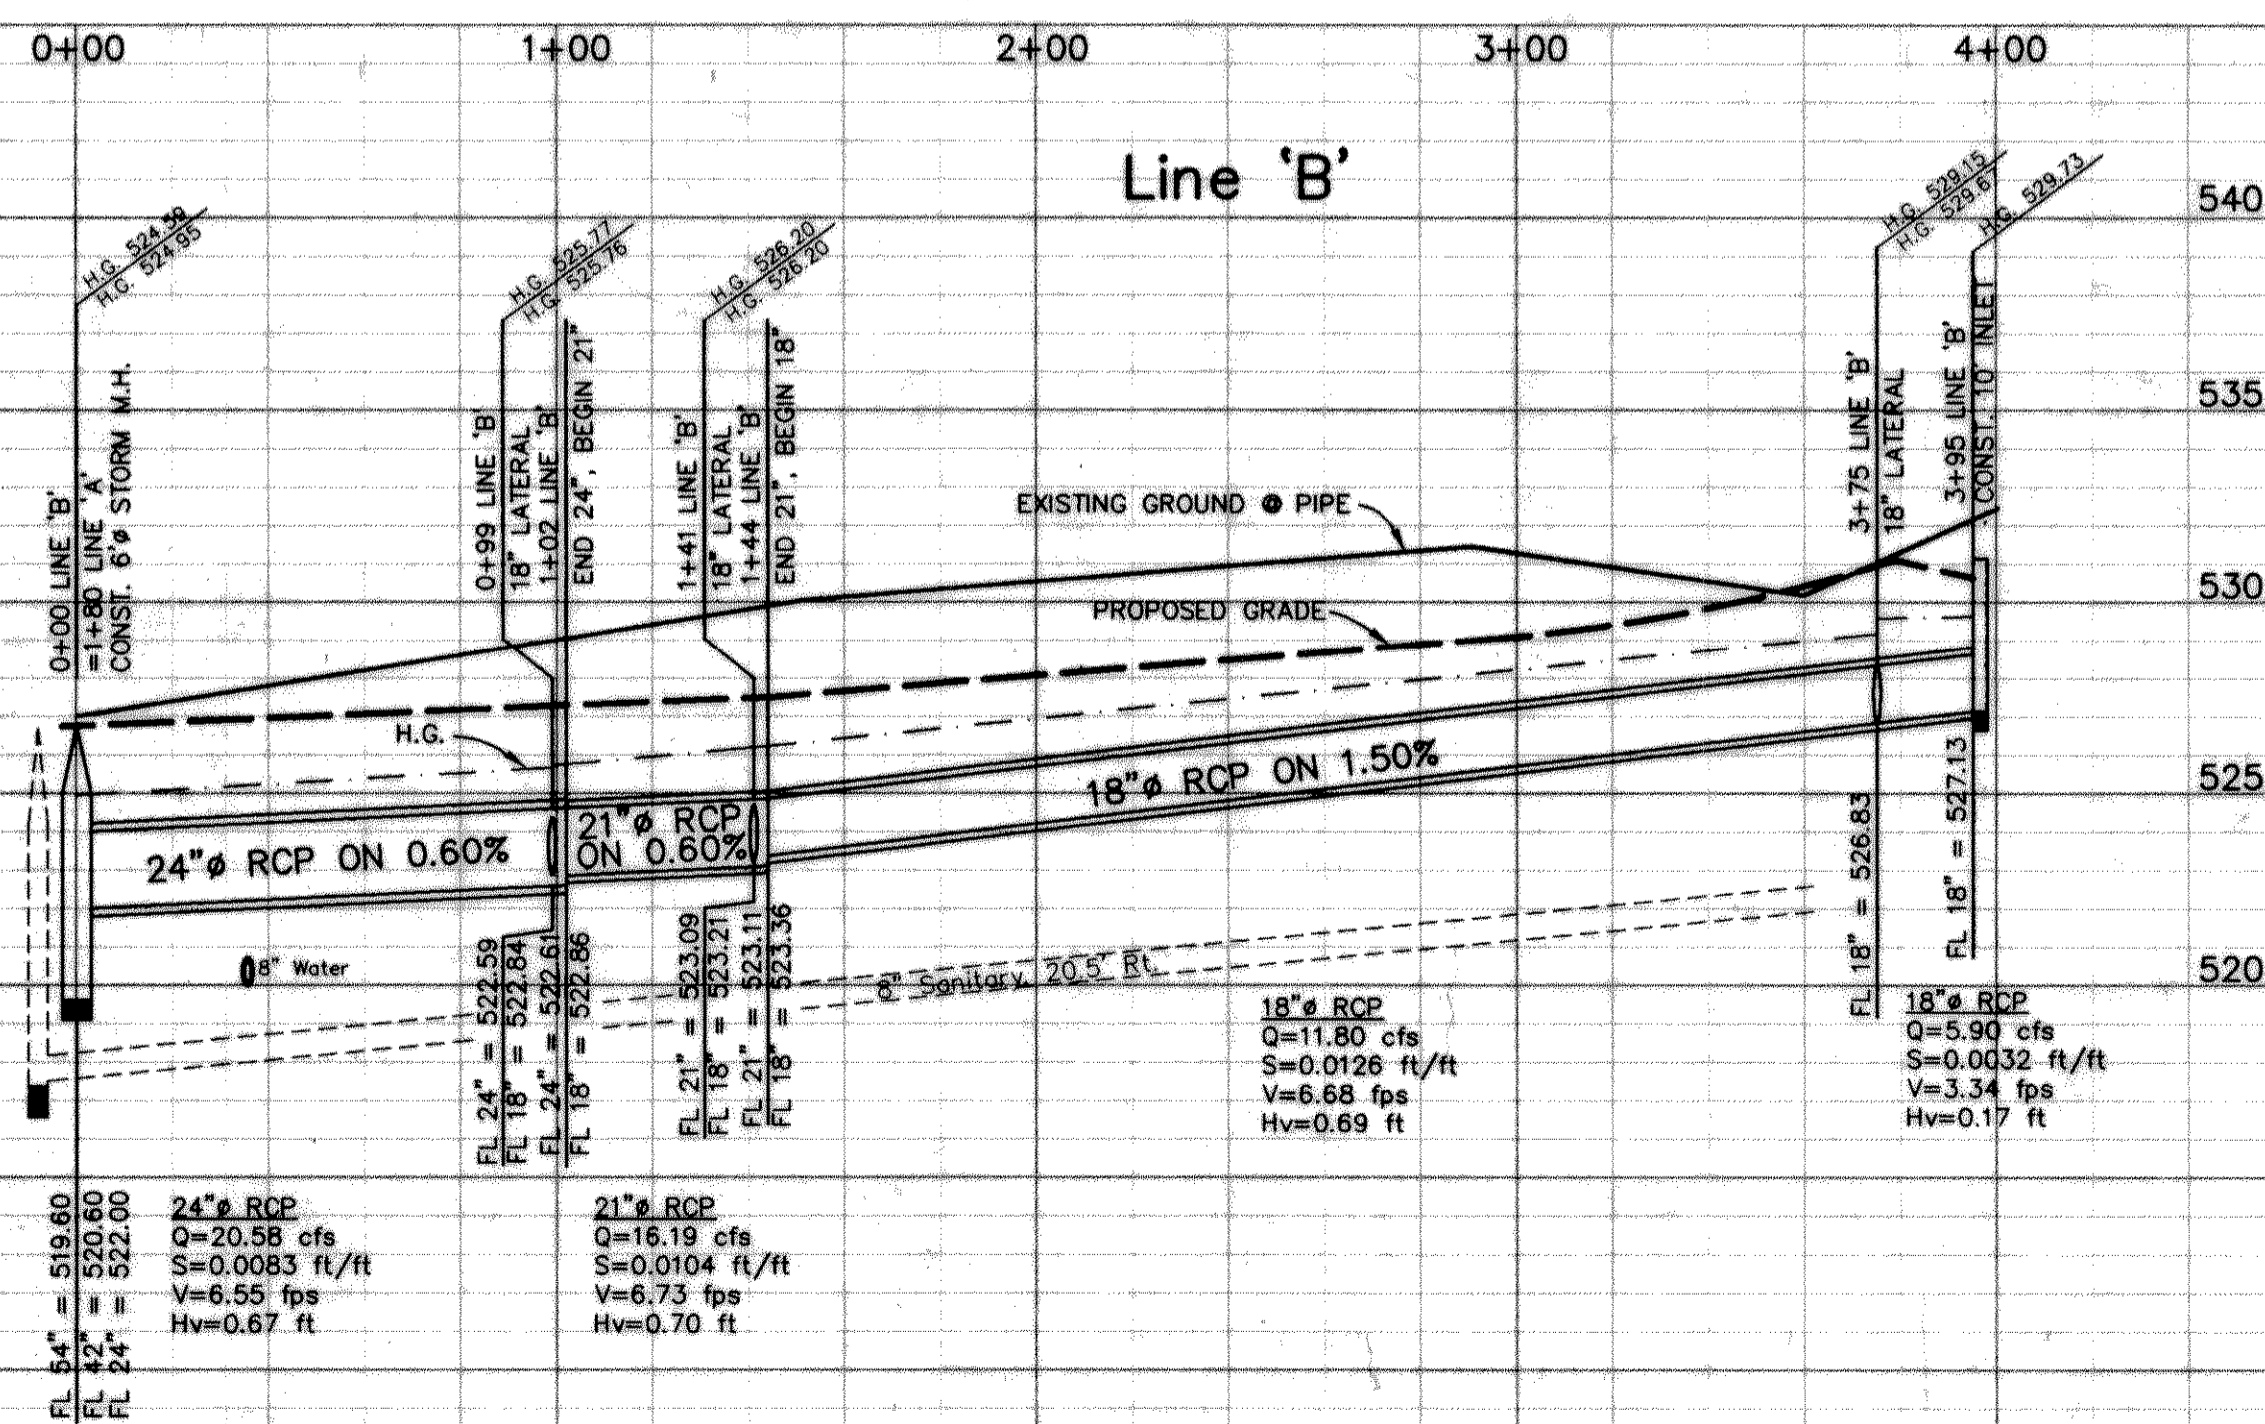

AS BUILT PLANS
08/03/99

The alignment and grade were set on the ground for construction per the plans. The engineer did not verify alignment or grades after construction. We are not aware of any changes or revisions to these plans during construction except as noted.

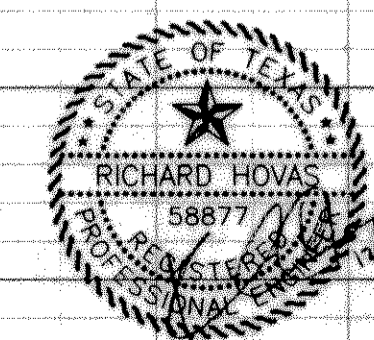

The seal appearing on this document was authorized by Richard Hovas, P.E. 93677

Line 'B'

STORM SEWER PLAN	
MEADOWCREEK ESTATES I	
City Of Rockwall, Texas	
TIPTON ENGINEERING, INC.	
6330 Broadway Blvd. ~ Suite C ~ Garland, Texas 75043	
DESIGN	ND.
DRAWN	FILE
DATE	NOTES
SCALE	1"=40'H 1"=5'V
T.E. Inc.	18