



NO.	FILE	NOTES	SCALE	DATE	DRAWN	DATE	T.E. INC.	T.E. INC.
22	4174		1"=5' H	11-98			1-7-99	4174STM6

6330 Broadway Blvd. ~ Suite C ~ Garland, Texas 75043  
**TIPTON ENGINEERING, INC.**  
 City of Rockwall, Texas  
 MEADOWCREEK ESTATES I  
**STORM SEWER PLAN**

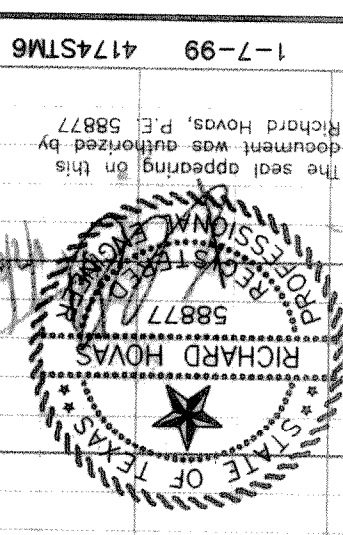

Line 'N'  
 AS BUILT PLANS  
 08/03/99  
 The alignment and grade were set on the ground for construction per the plans. The engineer did not verify alignment or grades after construction. We are not aware of any changes or revisions to these plans during construction except as noted.

545	540	535	530	525	520
-----	-----	-----	-----	-----	-----

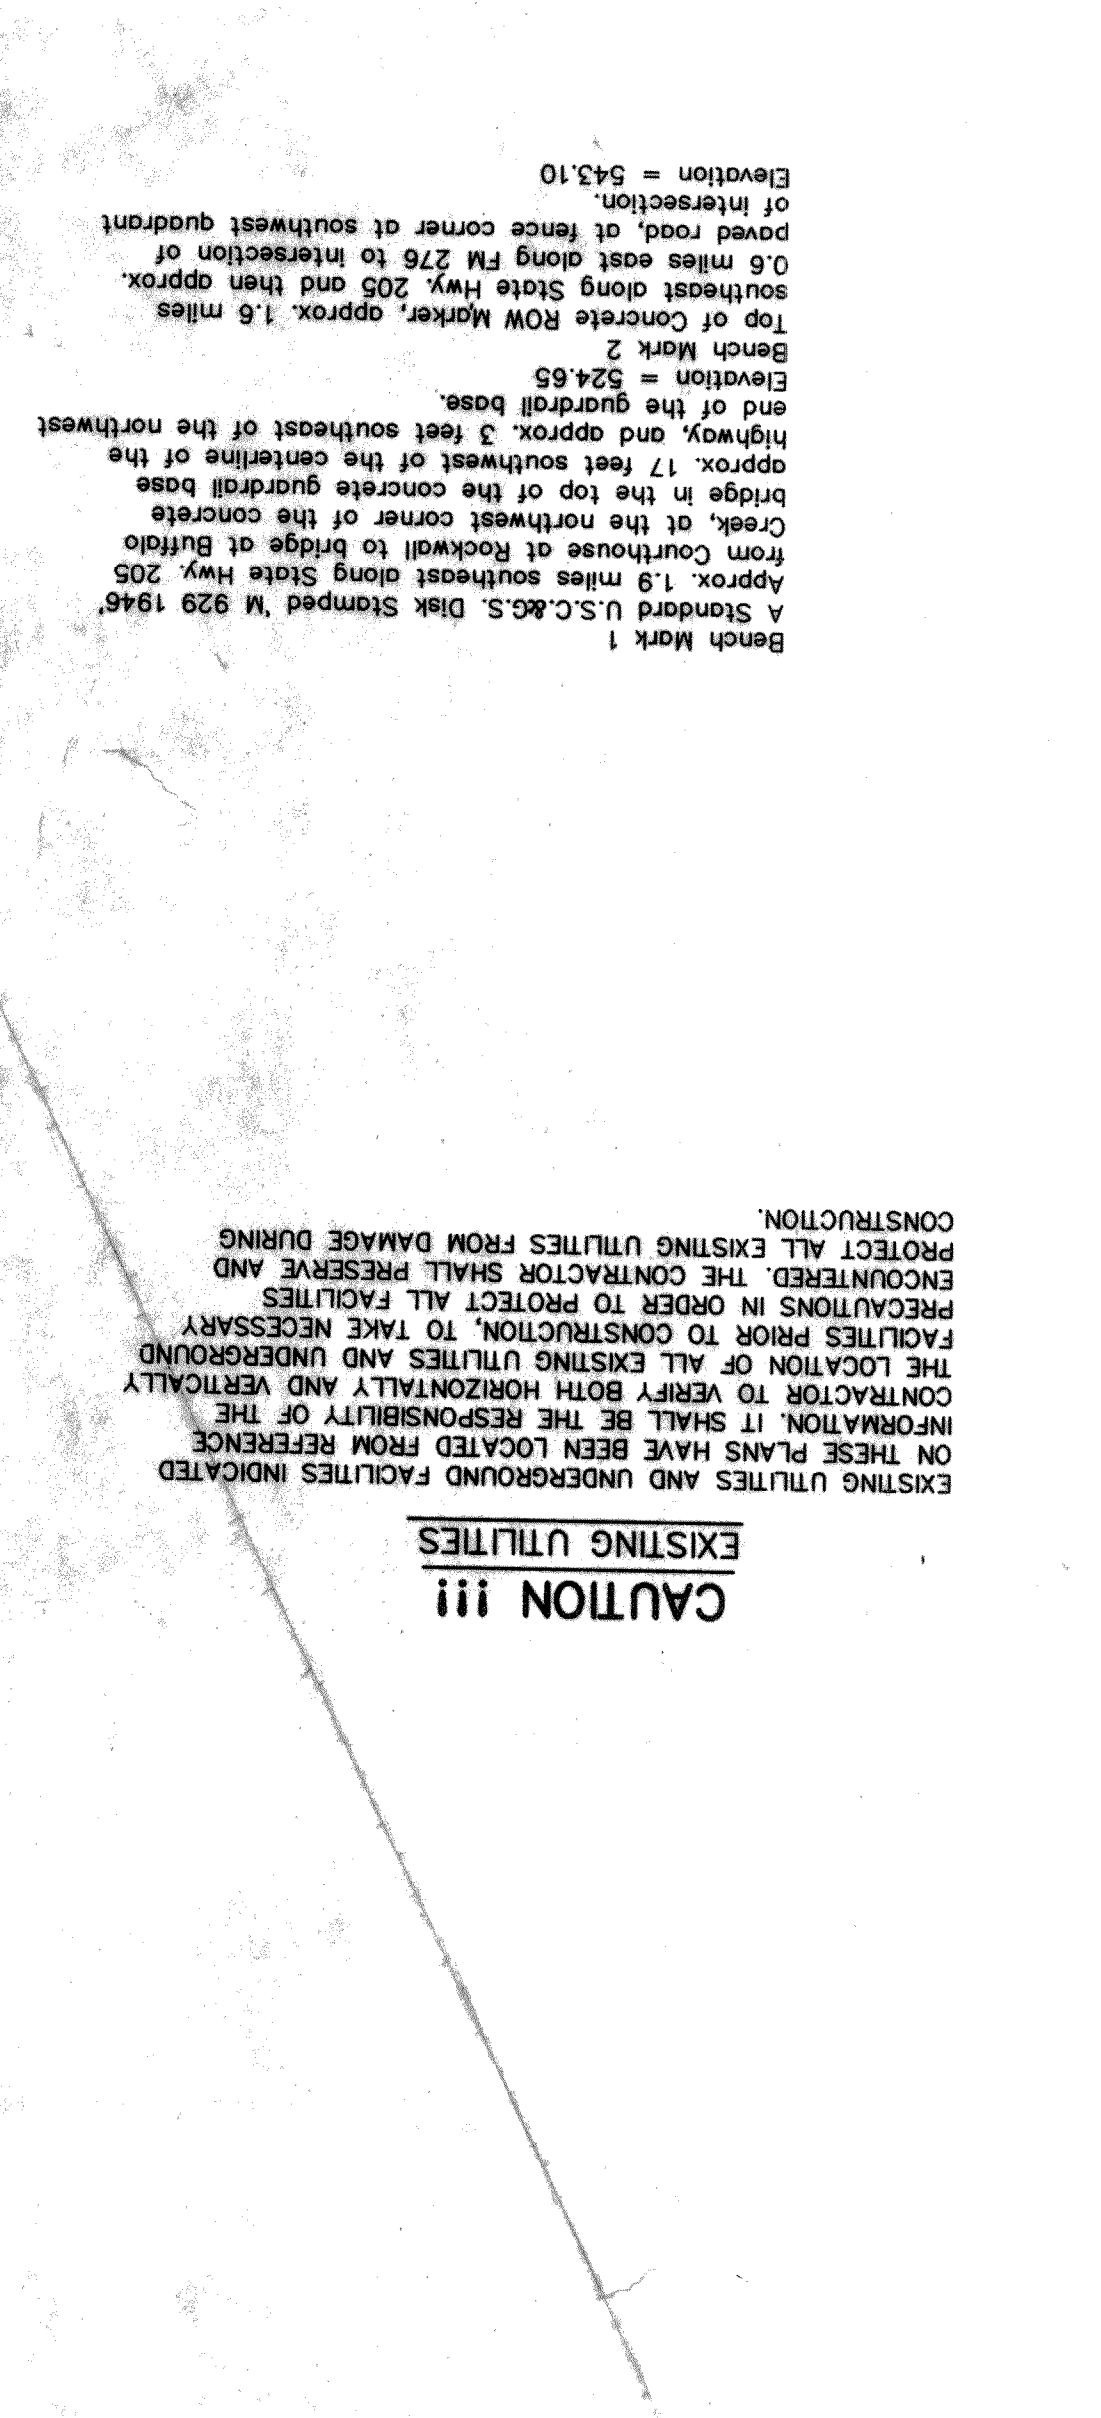

CONTRACTOR TO MEET WITH DESIGN ENGINEER ON SITE TO DETERMINE THE LOCATION OF STORM SEWER OUTFALL.

545	540	535	530	525	520
-----	-----	-----	-----	-----	-----



SEE SHEETS 30A & 30B FOR ADDITIONAL NOTES

Bench Mark 1  
 Standard U.S.C.&G.S. Disk Stamped M 929 1946  
 Approx. 1.9 miles southwest along State Hwy. 205 from Courthouse at Rockwall to bridge at Burdick Creek, at the northwest corner of the concrete bridge in the top of the concrete guardrail base approx. 17 feet southeast of the centerline of the end of the guardrail base.  
 Elevation = 524.65  
 Bench Mark 2  
 Top of Concrete ROW Marker, approx. 1.5 miles southwest along State Hwy. 205 and then approx. 0.6 miles east along FM 276 to intersection of paved road, at fence corner at southwest quadrant of intersection.  
 Elevation = 543.10

EXISTING UTILITIES AND UNDERGROUND FACILITIES INDICATED ON THESE PLANS HAVE BEEN LOCATED FROM REFERENCE INFORMATION. IT SHALL BE THE RESPONSIBILITY OF THE CONTRACTOR TO VERIFY BOTH HORIZONTALLY AND VERTICALLY THE LOCATION OF ALL EXISTING UTILITIES AND UNDERGROUND FACILITIES PRIOR TO CONSTRUCTION. TO TAKE NECESSARY PRECAUTIONS IN ORDER TO PROTECT ALL FACILITIES ENCOUNTERED. THE CONTRACTOR SHALL PRESERVE AND PROTECT ALL EXISTING UTILITIES FROM DAMAGE DURING CONSTRUCTION.

**CAUTION !!!**  
 EXISTING UTILITIES