


**CAUTION !!!
EXISTING UTILITIES**


EXISTING UTILITIES AND UNDERGROUND FACILITIES INDICATED ON THESE PLANS HAVE BEEN LOCATED FROM REFERENCE INFORMATION. IT SHALL BE THE RESPONSIBILITY OF THE CONTRACTOR TO VERIFY BOTH HORIZONTALLY AND VERTICALLY THE LOCATION OF ALL EXISTING UTILITIES AND UNDERGROUND FACILITIES PRIOR TO CONSTRUCTION. TO TAKE NECESSARY PRECAUTIONS IN ORDER TO PROTECT ALL FACILITIES ENCOUNTERED. THE CONTRACTOR SHALL PRESERVE AND PROTECT ALL EXISTING UTILITIES FROM DAMAGE DURING CONSTRUCTION.

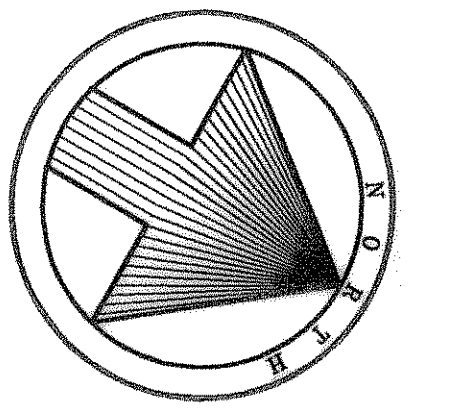

0+92.24 Alley Sta. ~ Construct 10' Curb Inlet w/10' Of Curb On Each Side Of Inlet, Inv.=546.43 TC=547.11, Lip=546.28, FL=542.61 Warp Invert To Drain Into Inlet

Const. 4 Ft. Concrete Overflow Flume


Lot 12 / Lot 13 ~ Construct Std. 10 Ft. Curb Inlet TC=545.90, FL=541.90

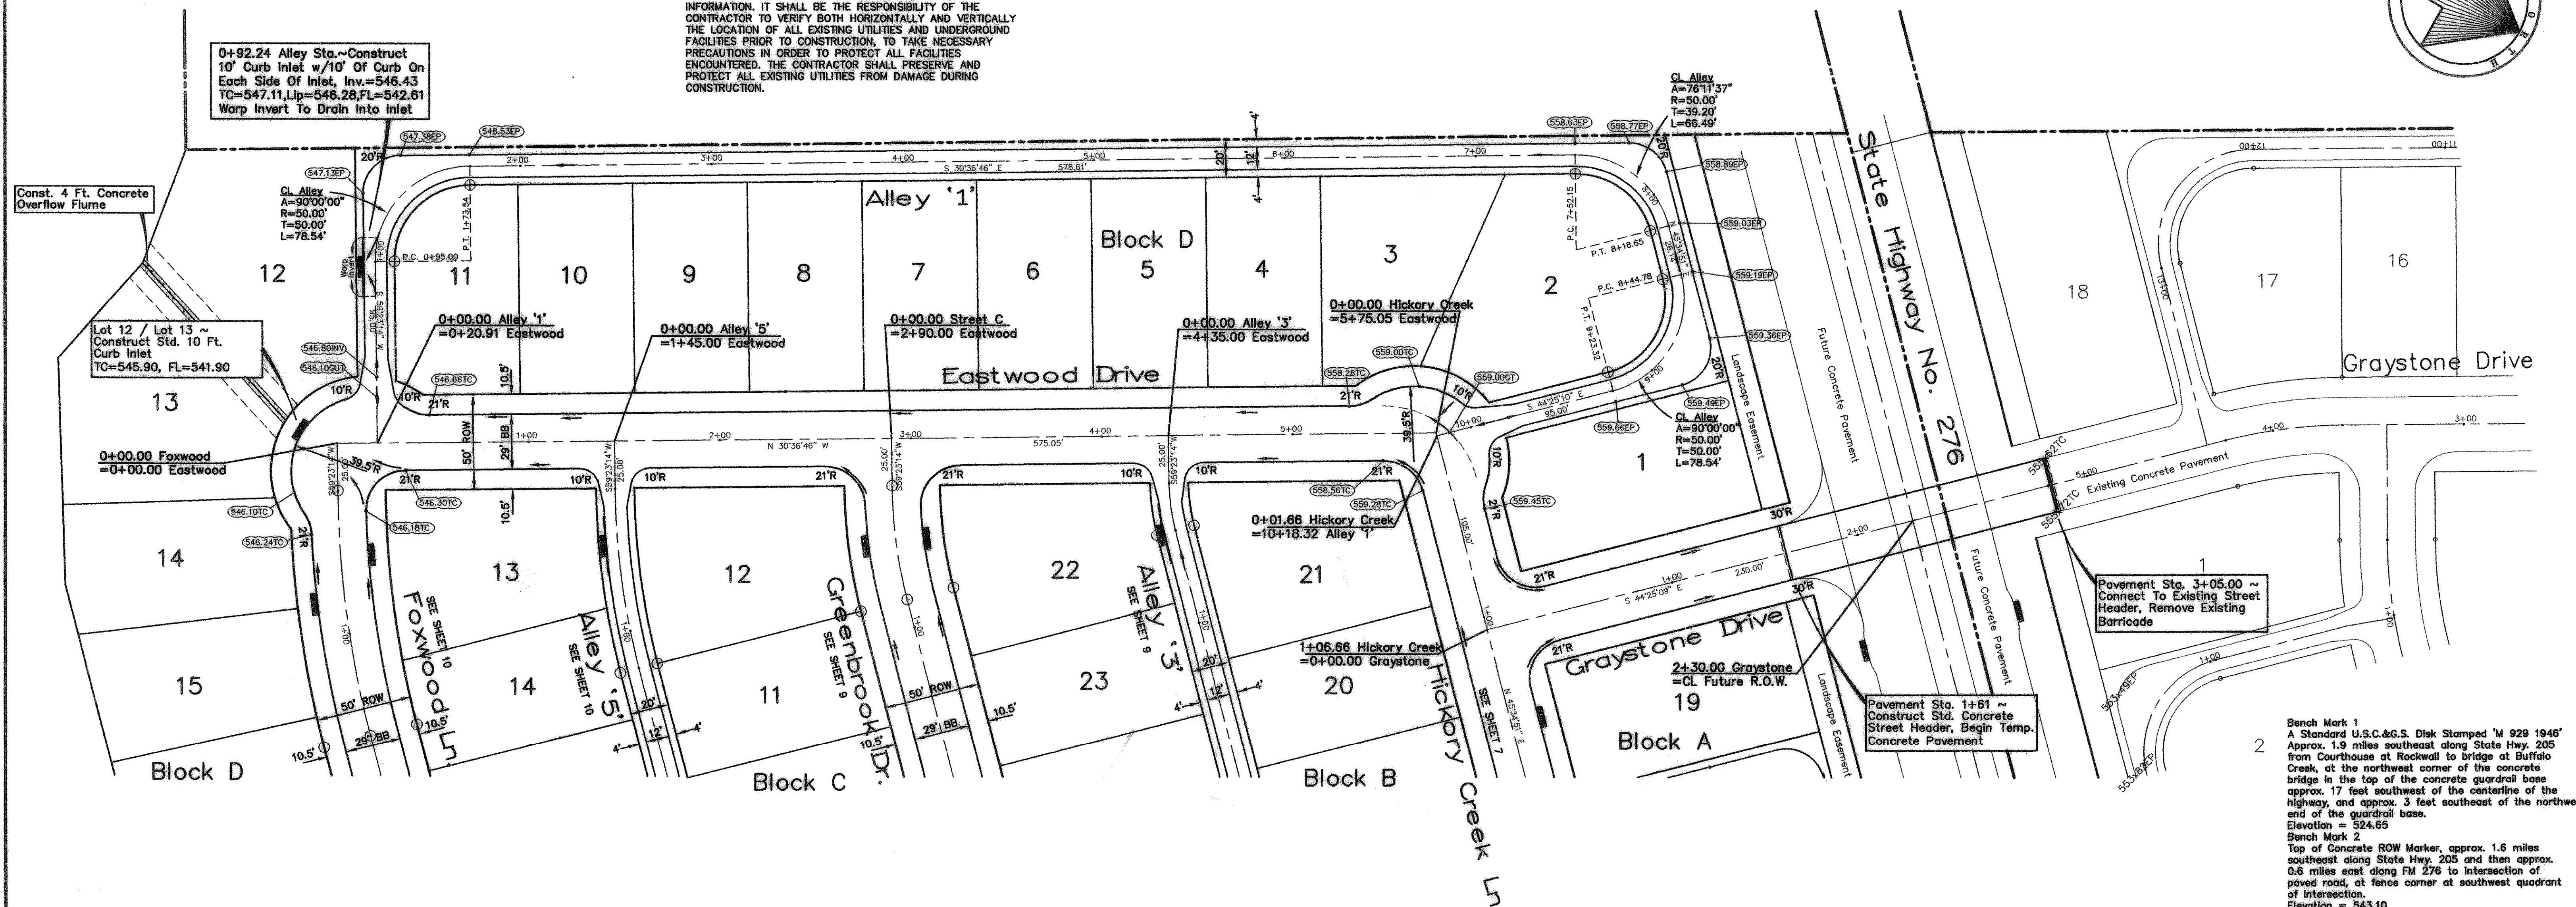

Pavement Sta. 3+05.00 ~ Connect To Existing Street Header, Remove Existing Barricade


Pavement Sta. 1+61 ~ Construct Std. Concrete Street Header, Begin Temp. Concrete Pavement

Bench Mark 1
A Standard U.S.C.&G.S. Disk Stamped 'M 929 1946' Approx. 1.9 miles southeast along State Hwy. 205 from Courthouse at Rockwall to bridge at Buffalo Creek, at the northwest corner of the concrete bridge in the top of the concrete guardrail base approx. 17 feet southwest of the centerline of the highway, and approx. 3 feet southeast of the northwest end of the guardrail base.
Elevation = 524.65
Bench Mark 2
Top of Concrete ROW Marker, approx. 1.6 miles southeast along State Hwy. 205 and then approx. 0.6 miles east along FM 276 to intersection of paved road, at fence corner at southwest quadrant of intersection.
Elevation = 543.10

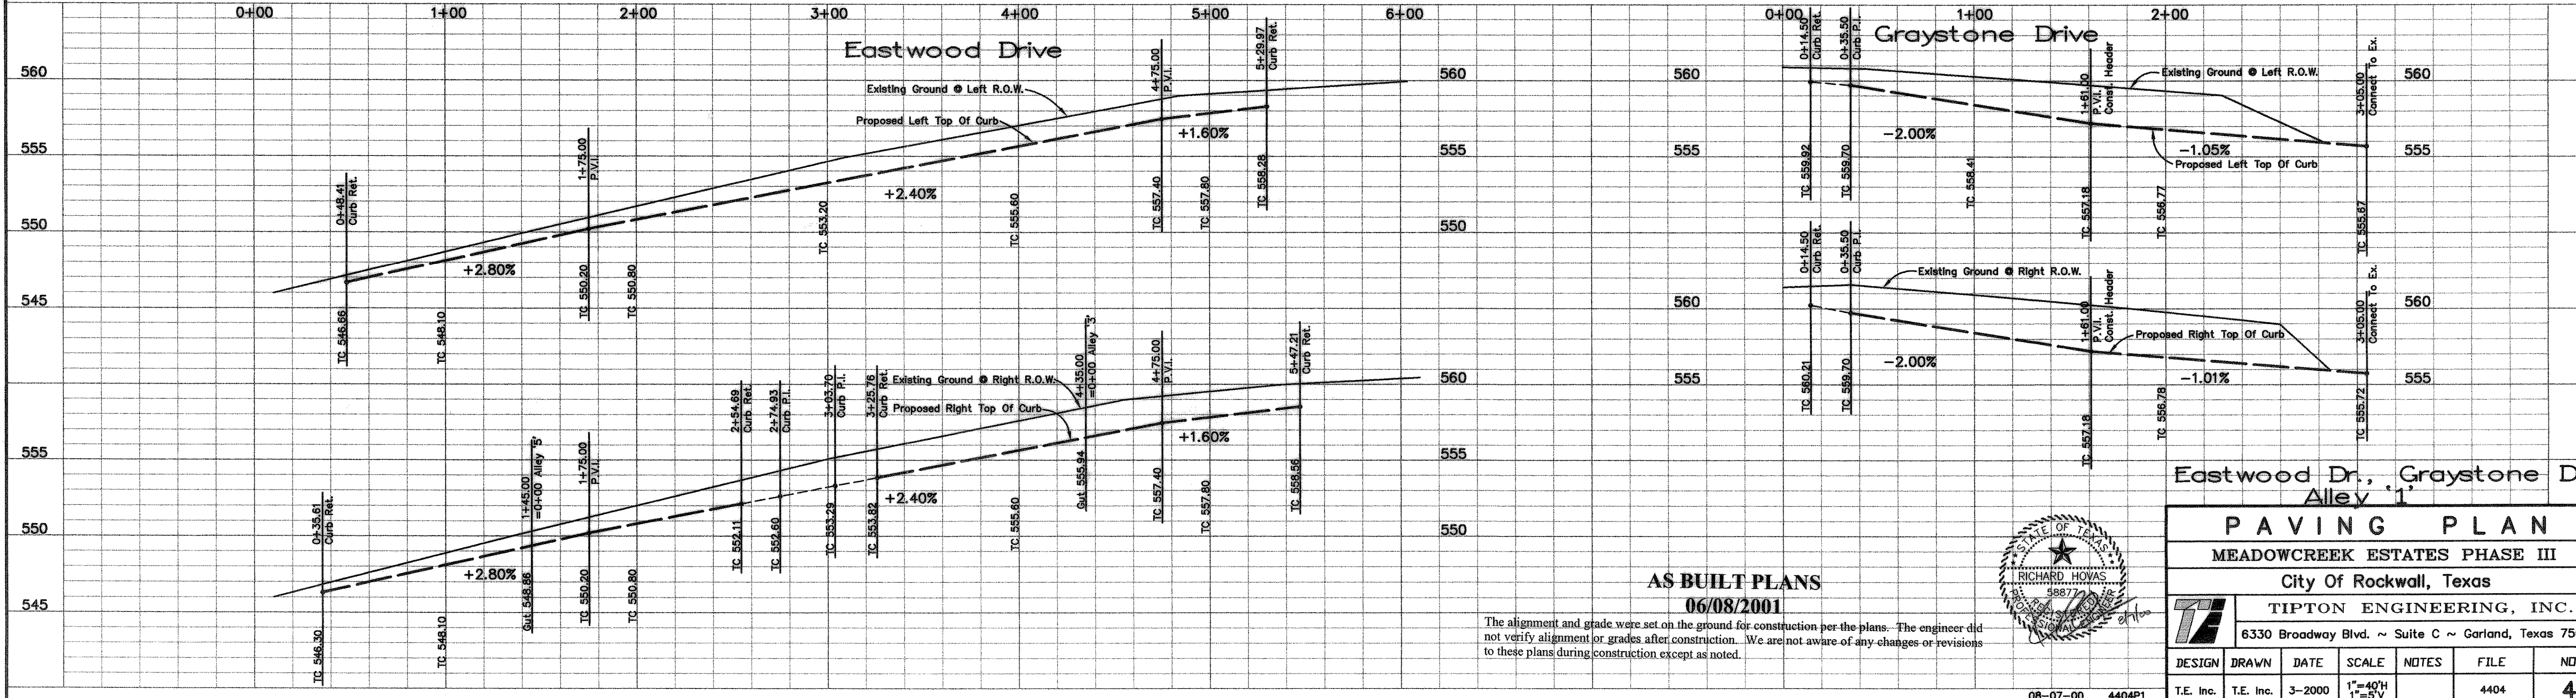

**AS BUILT PLANS
06/08/2001**

The alignment and grade were set on the ground for construction per the plans. The engineer did not verify alignment or grades after construction. We are not aware of any changes or revisions to these plans during construction except as noted.

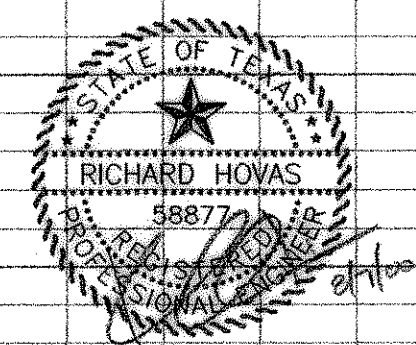

Eastwood Dr., Graystone Dr.
Alley '1'

PAVING PLAN
MEADOWCREEK ESTATES PHASE III
City Of Rockwall, Texas

TIPTON ENGINEERING, INC.
6330 Broadway Blvd. ~ Suite C ~ Garland, Texas 75043

DESIGN	DRAWN	DATE	SCALE	NOTES	FILE	NO.
T.E. Inc.	T.E. Inc.	3-2000	1"=40'H 1"=5'V		4404	4

08-07-00 4404P1