

CONSTRUCTION PLANS FOR **MI COCINA REDEVELOPMENT** **ROCKWALL CROSSING** **971 INTERSTATE HIGHWAY 30**

1.410 ACRES
CITY OF ROCKWALL, ROCKWALL COUNTY, TEXAS
AUGUST 2010

FOR
Mi Cocina
at Rockwall Crossing

971 EAST INTERSTATE 30
ROCKWALL, TEXAS 75087

ARCHITECT


DRA
DROESE RANEY ARCHITECTURE

3906 LEMMON AVENUE SUITE 101
DALLAS, TEXAS 75219 USA


PREPARED BY

Pacheco Koch
DALLAS ■ FORT WORTH ■ HOUSTON

8350 N. CENTRAL EXPWY., SUITE 1000 PH. 972.235.3031
DALLAS, TEXAS 75206 FAX 972.235.9544
TX REG. ENGINEERING FIRM F-469
TX REG. SURVEYING FIRM LS-100080-00

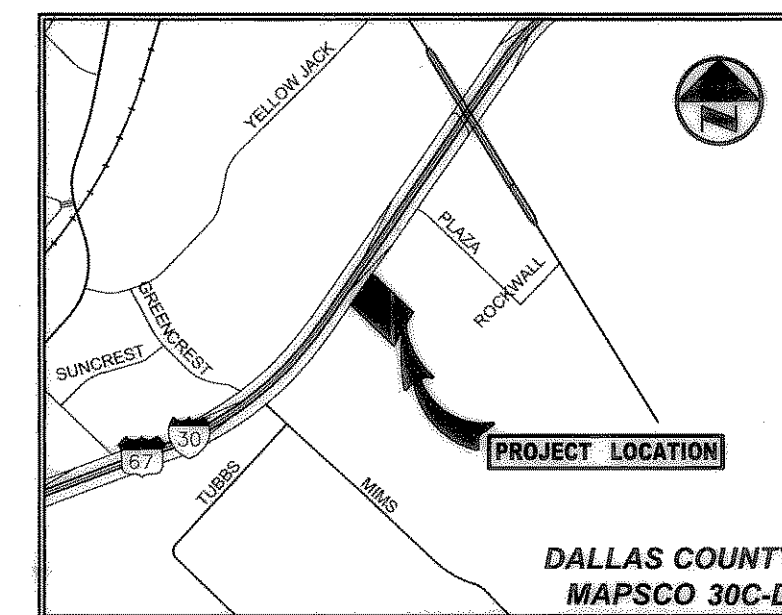

VICINITY MAP
(NOT TO SCALE)

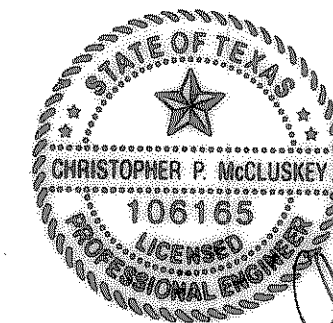

RECORD DRAWING
THIS DRAWING HAS BEEN REVISED TO REFLECT CONSTRUCTION RECORDS MAINTAINED AND PROVIDED BY THE CONTRACTOR FOR THIS PROJECT. VISUAL REVIEW AND SURVEY WORK CONDUCTED AT THE SITE.
CONTRACTOR: VISTA GENERAL CONTRACTORS, INC.
DATE REVISED: 03/03/2010

DRAWING SHEET INDEX

<u>SHEET</u>	<u>DESCRIPTION</u>
C0.0	COVER SHEET
C0.1	REPLAT
C1.1	DEMOLITION PLAN
C2.1	DIMENSIONAL CONTROL PLAN
C3.1	GRADING PLAN
C4.1	DRAINAGE AREA MAP
C4.2	STORM SEWER PLAN
C4.3	STORM SEWER PROFILE
C5.1	PAVING PLAN & DETAIL
C6.1	EROSION CONTROL PLAN & DETAILS