


# CIVIL SITE DEVELOPMENT PLANS FOR ROCKWALL CENTRE CORNERS ADDITION MIDSOUTH BANK LOT 9, BLOCK 1 ROCKWALL COUNTY, TEXAS

**PLANS SUBMITTAL/REVIEW LOG**

- 1st CITY SUBMITTAL 01/25/2013
- 2nd CITY SUBMITTAL / BID SET 02/22/2013
- CONSTRUCTION SET 04/08/2013

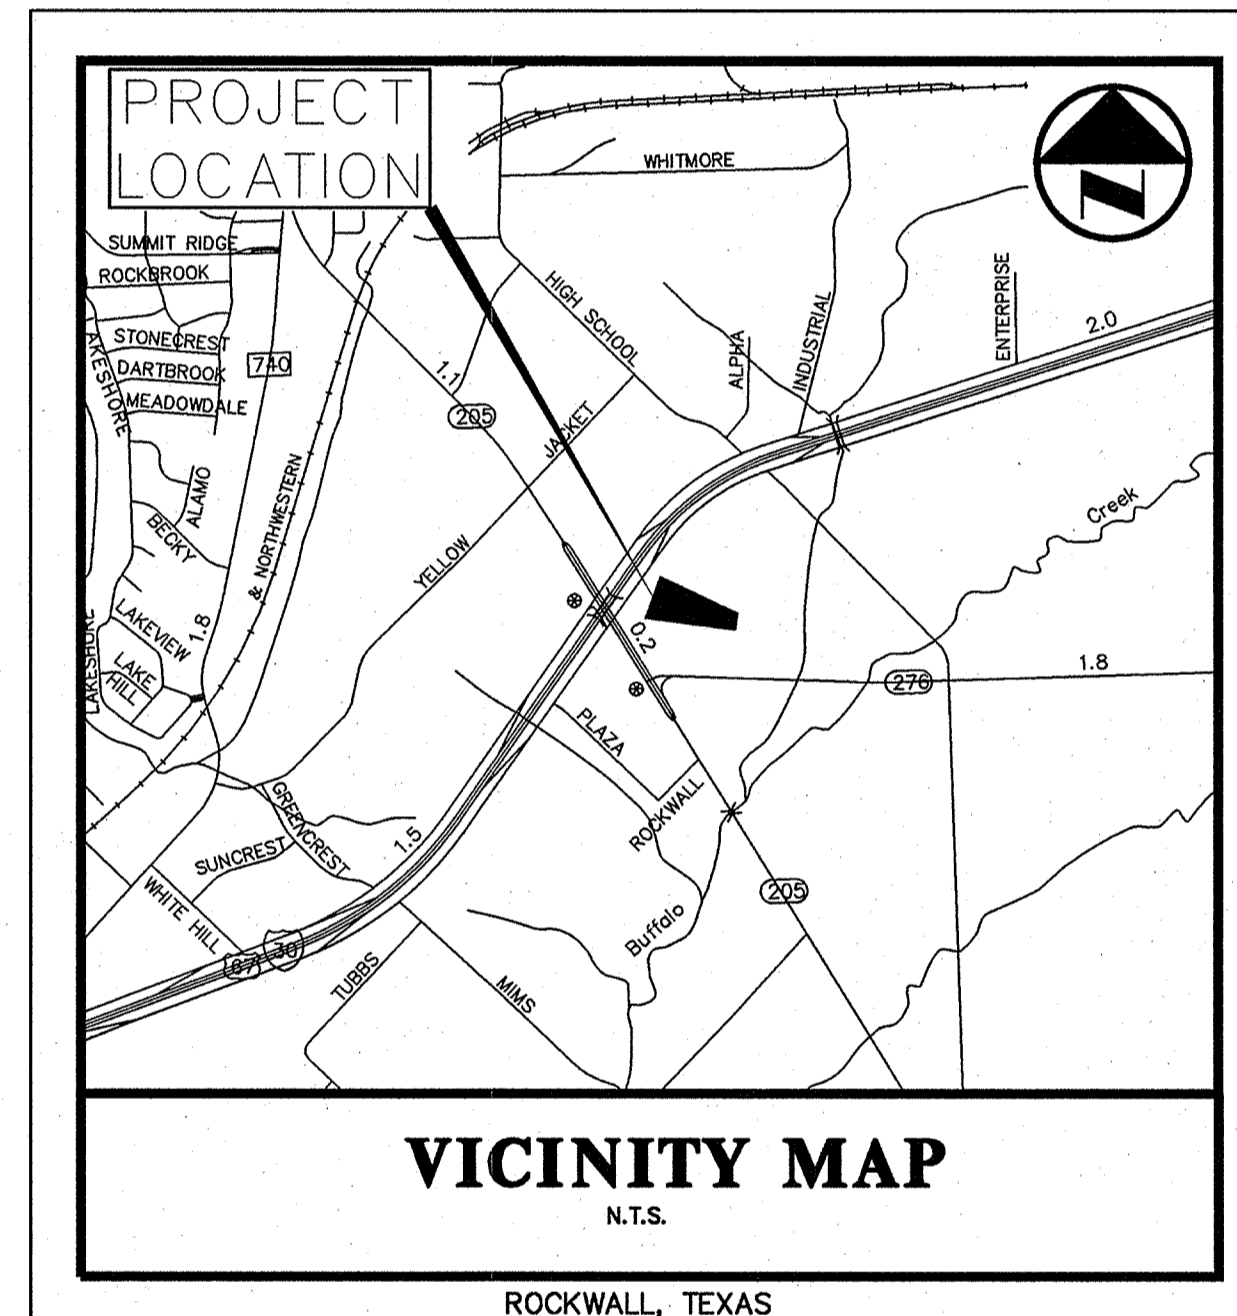

INDEX OF SHEETS		
SHEET NO.	DESCRIPTION	DATE
C0.0	COVER SHEET	
C0.1	BOUNDARY & TOPOGRAPHIC SURVEY	
C0.2	FLAT	
C0.3	APPROVED SITE PLAN	
C1.0	GENERAL NOTES	
C2.0	EROSION CONTROL PLAN	
C2.1	EROSION CONTROL DETAILS	
C3.0	DIMENSION CONTROL PLAN	
C4.0	GRADING PLAN	
C4.1	DRAINAGE AREA MAP	
C5.0	STORM SEWER PLAN	
C5.1	STORM SEWER PROFILE	
C6.0	UTILITY PLAN	
L1.0	LANDSCAPE PLAN	
L2.0	LANDSCAPE DETAILS	
L3.0	LANDSCAPE IMAGES	
IR1.0	IRRIGATION PLAN & DETAILS	

PLAN REVISION LOG		
NO.	DATE	DESCRIPTION

**OWNER:**  
MIDSOUTH BANK  
1214 ST. CHARLES STREET  
HOUMA, LA 70360  
PHONE NO 13371 693-3021

**SURVEYOR:**  
KIMLEY-HORN AND ASSOCIATES, INC.  
12750 MERIT DRIVE, SUITE 1000  
DALLAS, TEXAS 75251  
PHONE NO 19721 770-1300

**ARCHITECT:**  
McCLEARY GERMAN ARCHITECTS  
14900 ST. MARY'S LANE, SUITE 120  
HOUSTON, TEXAS 77079  
PHONE NO 17131 652-0707

**PREPARED BY:**



**Kimley-Horn  
and Associates, Inc.**

12012 Wickchester Lane, Suite 500  
Houston, Texas 77079  
Certificate of Authorization F-928  
CONTACT: Mark Kirkland

Tel. No. (281) 597-9300  
Fax No. (281) 597-8032  
Email: Mark.Kirkland@kimley-horn.com

**WARNING!**  
ALL CONTRACTORS MUST KNOW EXACT LOCATION OF, AND AVOID, ALL UNDERGROUND UTILITIES PRIOR TO COMMENCING WORK. CALL UTILITY LOCATOR SERVICE AT LEAST 48 HOURS PRIOR TO COMMENCING WORK.

ALL RESPONSIBILITY FOR ADEQUACY OF DESIGN REMAINS WITH THE DESIGN ENGINEER. THE CITY OF ROCKWALL, IN REVIEWING AND RELEASING PLANS FOR CONSTRUCTION, ASSUMES NO RESPONSIBILITY FOR ADEQUACY OR ACCURACY OF DESIGN.



**RECORD DRAWING**  
THIS RECORD DRAWING HEREIN REFLECTS TO THE BEST OF THE DESIGN ENGINEER'S KNOWLEDGE, THE APPROXIMATE LOCATION OF THE CONSTRUCTED WORK, USING INFORMATION AS PROVIDED BY THE CONTRACTORS AND SURVEYED GRADES.  
*Mark Kirkland 7/20/13*