


FLOOD PLAIN CERTIFICATION
 This is to certify that no portion of the subject property lies within a 100 year floodway or in an identified Flood Prone Area as defined by the National Flood Insurance Program, U.S. Department of Housing and Urban Development, or Federal Insurance Administration.

The plat hereon is a true, correct, and accurate representation of the property as determined by survey, the lines and dimensions of said property being as indicated by the plat; the size, location, and type of buildings and improvements are as shown, all improvements being within the boundaries of the property, set back from property lines the distances indicated.
 There are no encroachments, conflicts, or protrusions except as shown.

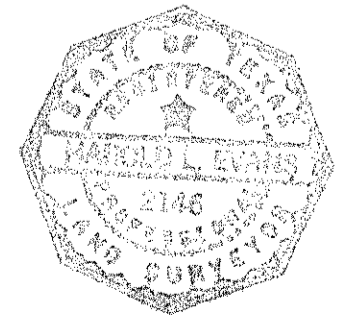

Harold L. Evans
 Harold L. Evans, P.E., Registered Professional Land Surveyor No. 2146

AS BUILT

LOT 3 MILLER ADDITION
 A REPLAT OF LOT 1, BLOCK A
 OF THE TRIBBEY ADDITION
 AS RECORDED IN CABINET D, SLIDE 1 & 2

REVISION DESCRIPTION		DATE	SCALE	DESIGN	DRAWN	SHEET NO.
		4-18-2000	1" = 20'	H.L.E.	JMA	
HAROLD L. EVANS CONSULTING ENGINEER P.O. BOX 28955 2331 GUS THOMASSON ROAD, SUITE 102 DALLAS, TEXAS 75228, (214) 328-8133						AS BUILT SURVEY LOT 3 MILLER ADDITION J. SMITH SURVEY, ABST. No. 200 CITY OF ROCKWALL, ROCKWALL CO., TX.
JOB NO. 9848						