


NOTE:
SEE SHEET 3/6 FOR
EROSION CONTROL PLAN

AS BUILT

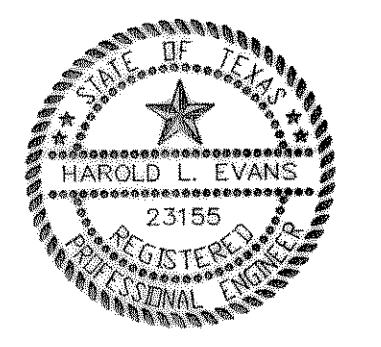

REVISION DESCRIPTION <small>38480RD</small>		DATE 5/14/98	SCALE 1" = 20'	DESIGN H.L.E.	DRAWN	SHEET NO. 4 6
REV. PER 2nd. CITY REVIEW 7/28/98		HAROLD L. EVANS CONSULTING ENGINEER P.O. BOX 28355 2331 CUS THOMASSON ROAD, SUITE 102 DALLAS, TEXAS 75228. (214) 328-8133		GRADING AND PAVING PLAN LOT 3 MILLER ADDITION CITY OF ROCKWALL		JOB NO. 9848
REV. PER 1st. CITY REVIEW 7/10/98						