


SCALE FEET

GENERAL NOTES

1. The locations of the existing utilities shown on this plan are based on the interpretation of the best available information and are warranted by the Engineer.
2. It will be the contractor's responsibility to verify and locate the various locations of pertinent utilities prior to or during construction. Any additional or unforeseen cost to the contractor caused by any reason will not be paid for directly but considered subsidiary to the various bid items.
3. The proposed 8" sanitary sewer will be constructed in accordance with the City of Rockwall Construction Standards and Specifications.

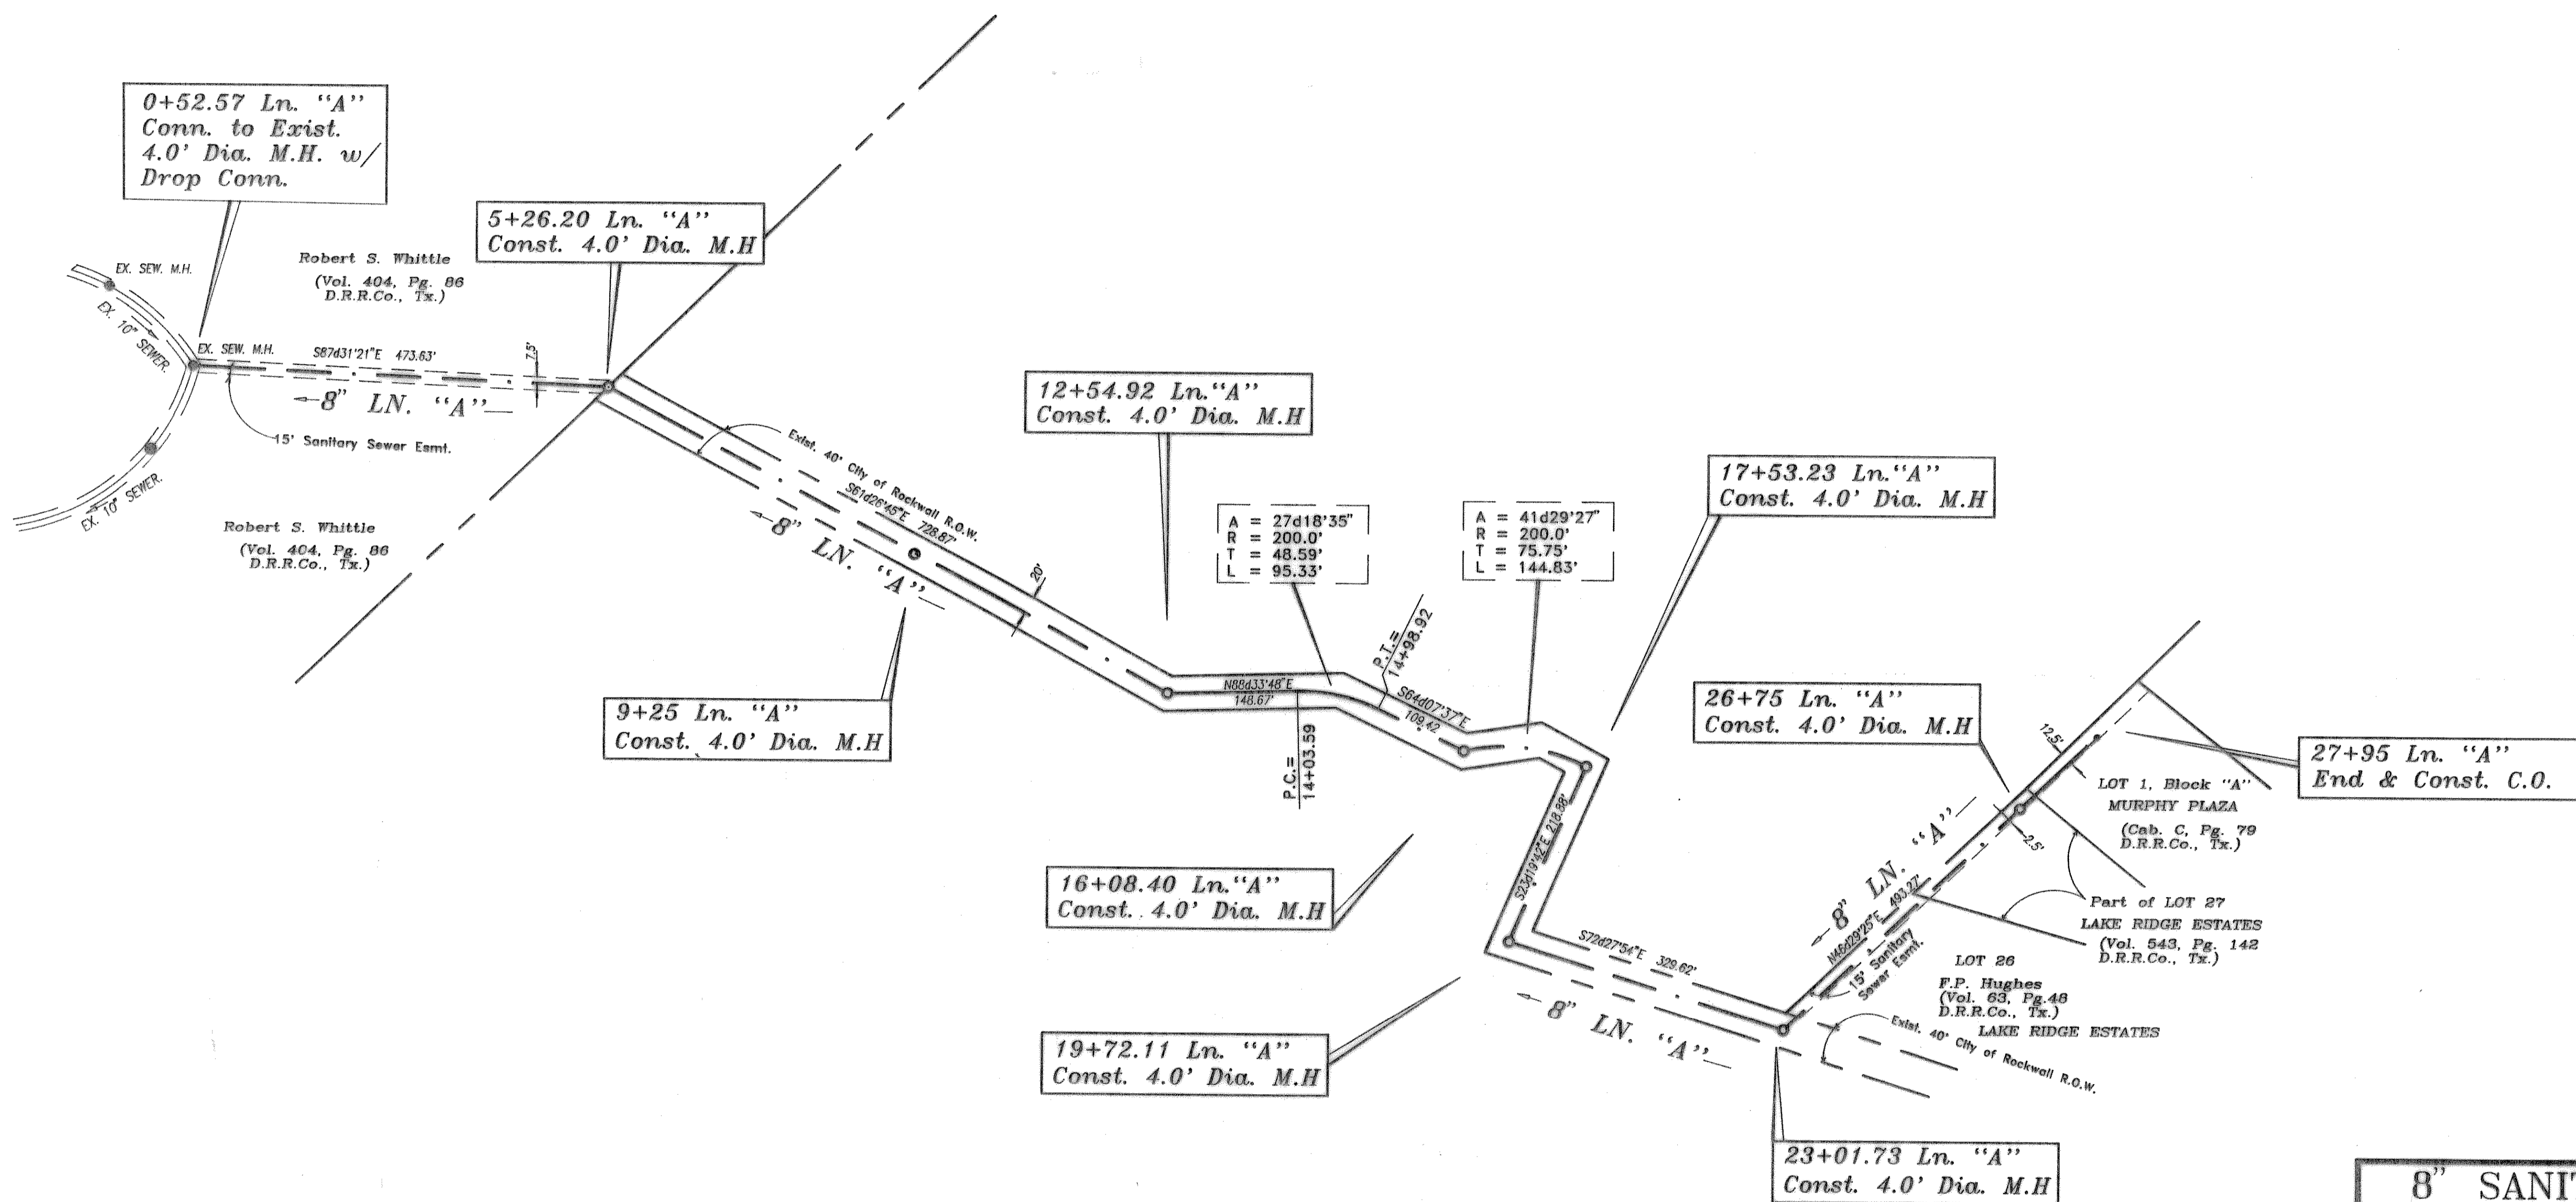

8" SANITARY SEWER
MURPHY PLAZA
ROCKWALL, TEXAS
CITY OF ROCKWALL
 "THE NEW HORIZON"

REVISION NO.	REMARKS	DATE
①	Change Beginning M.H. Sta. from 0+00 to 0+52.57 & alignment of sewer line to Sta. 5+26.20	8/1/90

DESIGNED:	B.W.H.	SCALE:	1"=100'
DRAWN:	B.W.H.	APPROVED:	<i>W. Douglas</i>
JOB NO.		DATE:	6/90
		SHEET NO.	2 OF 3

