


DRAINAGE TABLE

DRAINAGE AREA NO.	ACRES	T.C.	C	I 100 YR.	Q 100 YR.	SUM Q 100 YR.
1	1.39	1.0 MIN	0.5	9.8	6.81	14.06
2	1.48	"	"	"	7.25	19.26
3	1.06	"	"	"	5.19	30.67
4	2.33	"	"	"	11.42	34.06
5	.69	"	"	"	3.38	39.98
6	1.21	"	"	"	5.93	34.06
7	2.19	"	"	"	10.73	39.98
8	1.13	"	"	"	5.54	

B.M. SQUARE CUT @ CONC. BASE OF CIVIL DEFENCE SIREN NEAR THE WEST CORNER OF LOT 1 BLOCK A. ELEVATION = 520.33	B.M. TOP OF MANHOLE @ NEAR THE WEST CORNER OF LOT 44 CHANDLERS LANDING PHASE 2D ELEVATION = 518.72
--	--

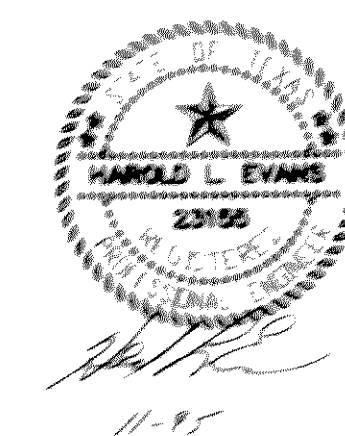

REV. PER CITY REVIEW	DATE 10.25.95	HAROLD L. EVANS CONSULTING ENGINEER P. O. BOX 28051 2331 GOS THOMASSON ROAD SUITE 140 DALLAS TEXAS 75228 214.328-8101	DRAINAGE AREA MAP NEWPORT PLACE CITY OF ROCKWALL	SHEET NO. 7	
REVISION DESCRIPTION	DATE 7-4-95			SCALE 1" = 40'	DESIGN H.L.E.