


CURVE	RADIUS	LENGTH	TANGENT	CHORD	BEARING	DELTA
C1	100.00'	89.28'	47.86'	86.35'	S 17°49'48" W	51°09'18"
C2	100.00'	90.93'	48.88'	87.83'	N 18°18'03" E	52°05'49"
C3	100.00'	98.79'	53.84'	94.82'	S 16°02'57" W	56°36'01"
C4	100.00'	37.86'	19.16'	37.64'	N 01°24'13" W	21°41'40"
C5	128.39'	76.41'	39.37'	75.28'	N 26°29'27" E	34°05'51"



B.M. SQUARE CUT @ CONC. BASE OF CIVIL DEFENCE SIREN NEAR THE WEST CORNER OF LOT 1 BLOCK A. ELEVATION = 520.33	B.M. TOP OF MANHOLE @ NEAR THE WEST CORNER OF LOT 44 CHANDLERS LANDING PHASE 2D BLOCK A. ELEVATION = 518.72
--	--

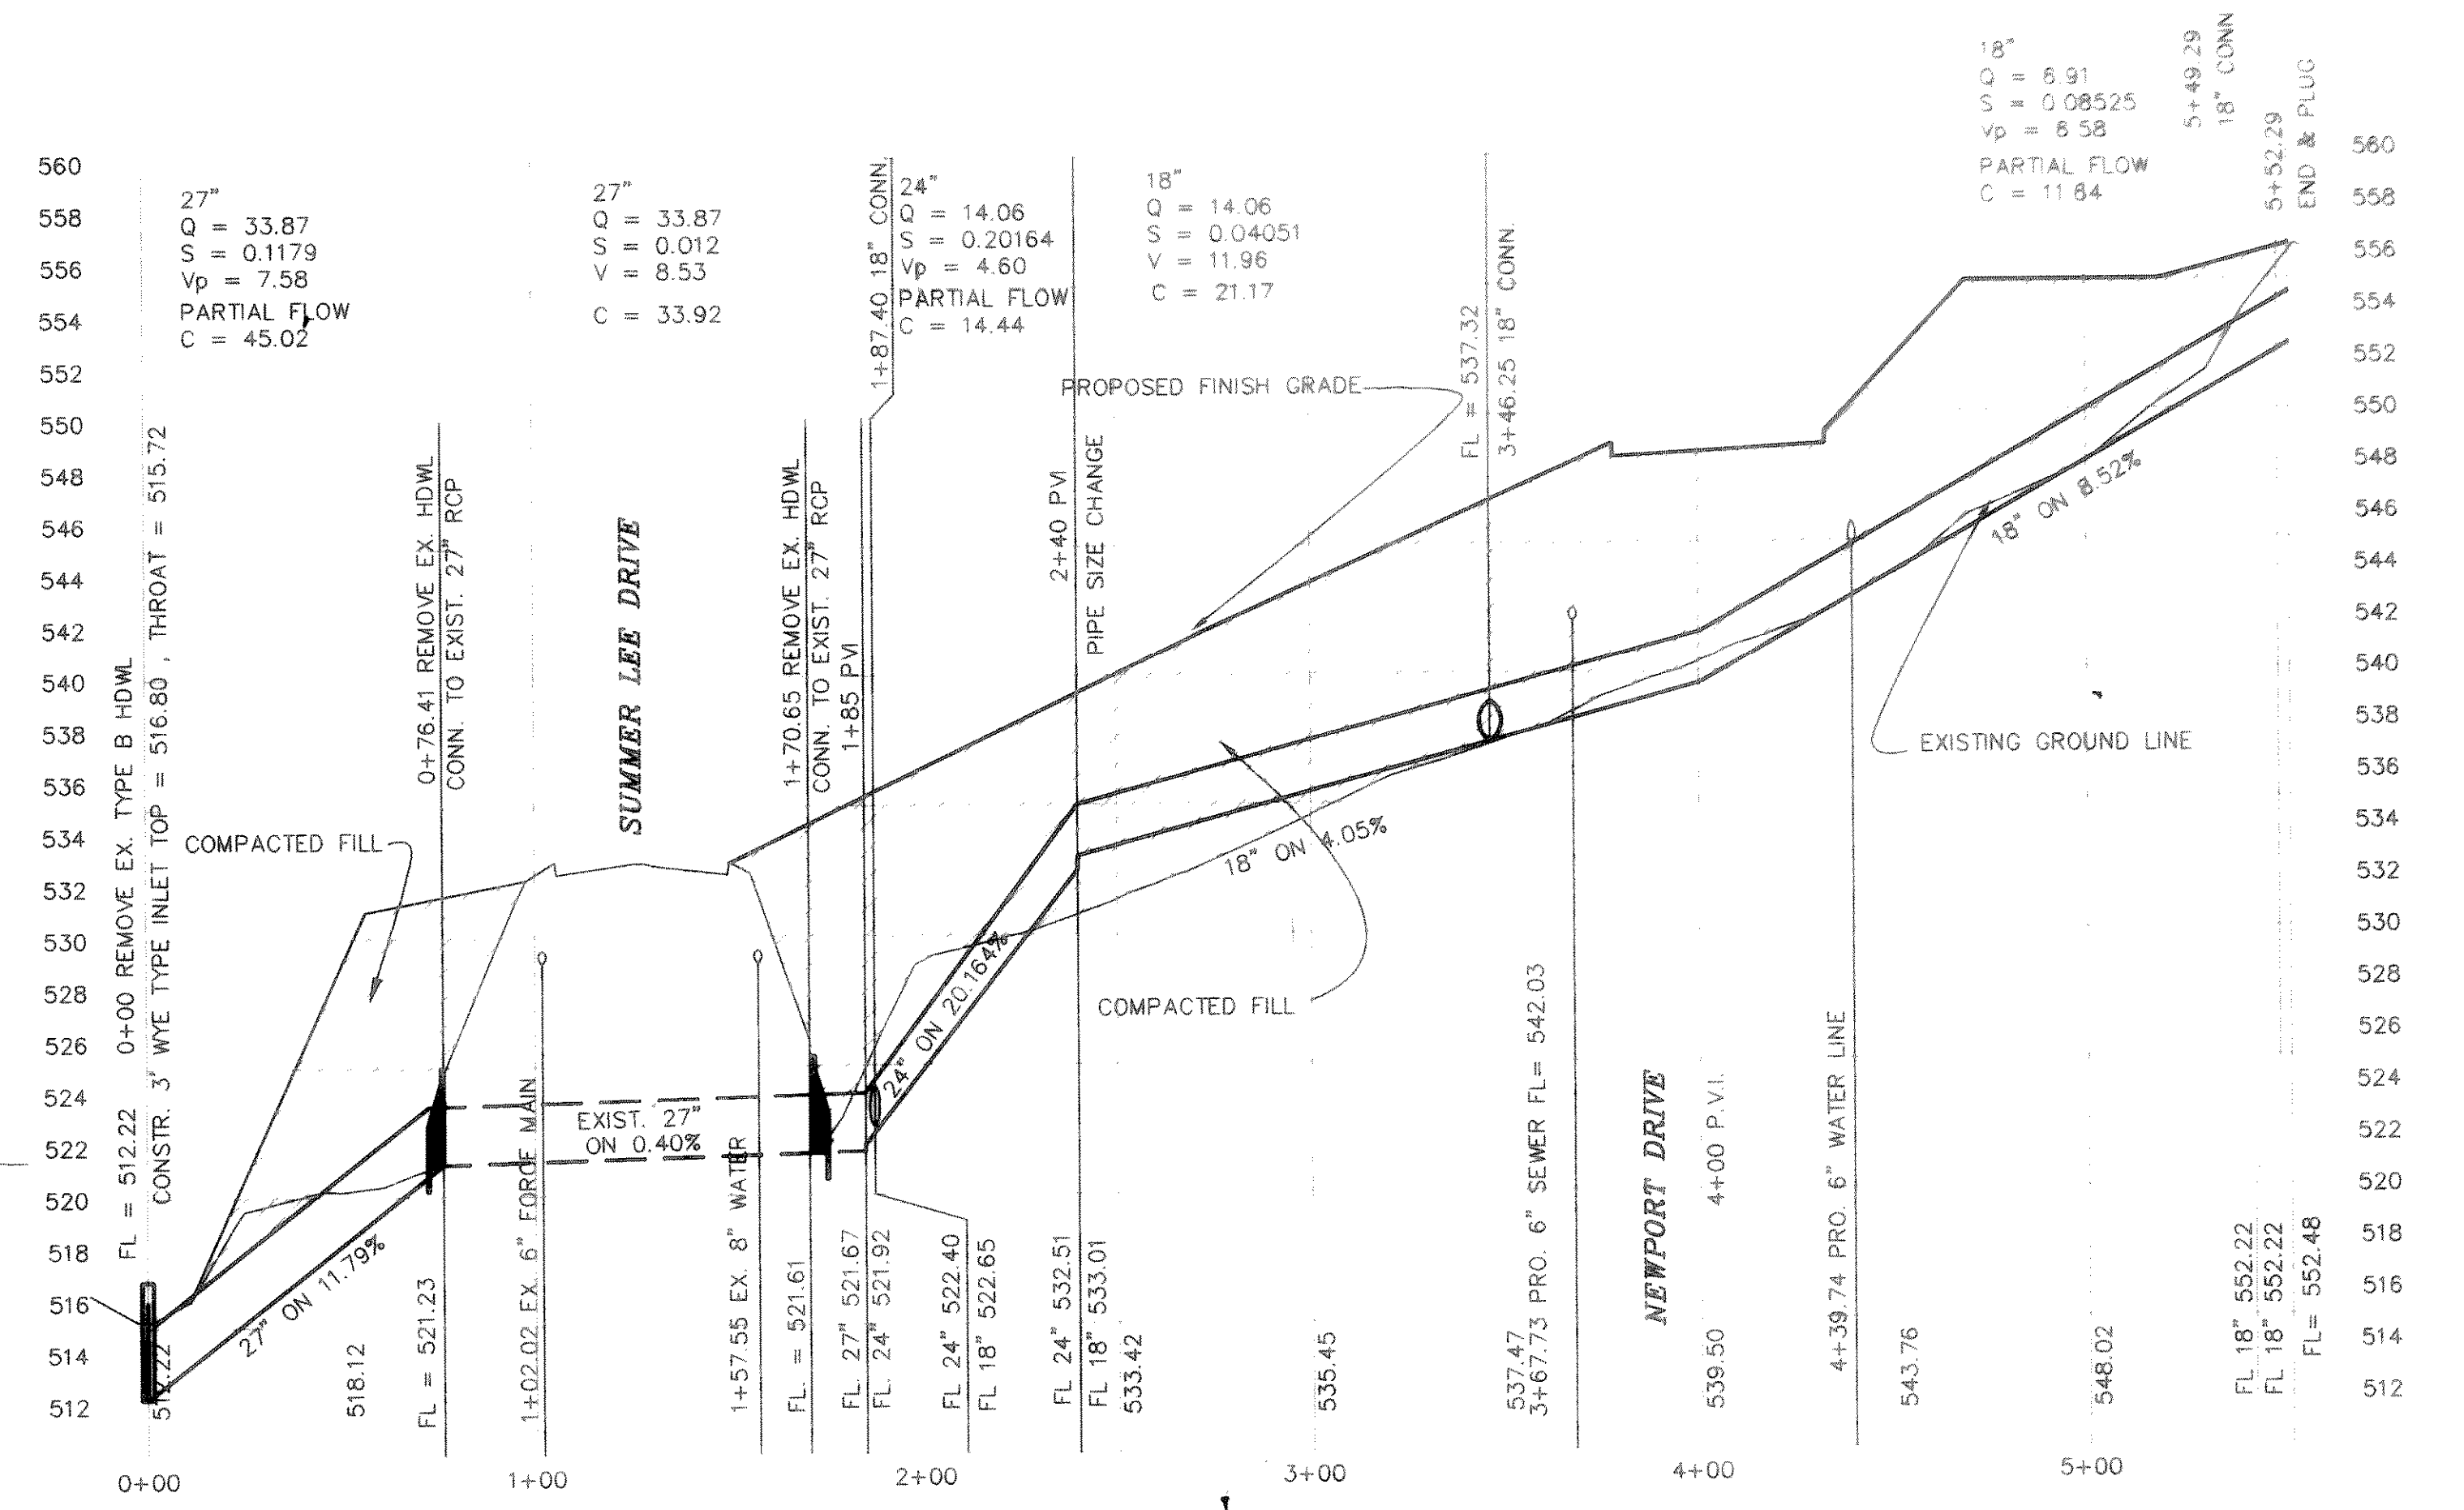

HAROLD L. EVANS CONSULTING ENGINEER P.O. BOX 28355 2331 CUS THOMASSON ROAD, SUITE 102 DALLAS, TEXAS 75228 (214) 328-8133		STORM SEWER PLAN NEWPORT PLACE CITY OF ROCKWALL		SHEET NO. B 10		
REVISION DESCRIPTION MIVED INLET TO SAG - END LINE 11/7/96 REV PER 2nd CITY REVIEW 3/12/96 REV PER CITY REVIEW 8/21/95		DATE 7/14/95	SCALE 1" = 40' 1" = 6'	DESIGN H.L.E.	DRAWN K.E.B.	JOB NO. 9551