


CONSTRUCT 479 L.F.  
OF SILTATION FENCE

CONSTRUCT 1110 L.F.  
OF SILTATION FENCE

TOP "Y" INLET 516.80  
THROAT 515.72  
CONSTRUCT 369 L.F.  
OF SILTATION FENCE

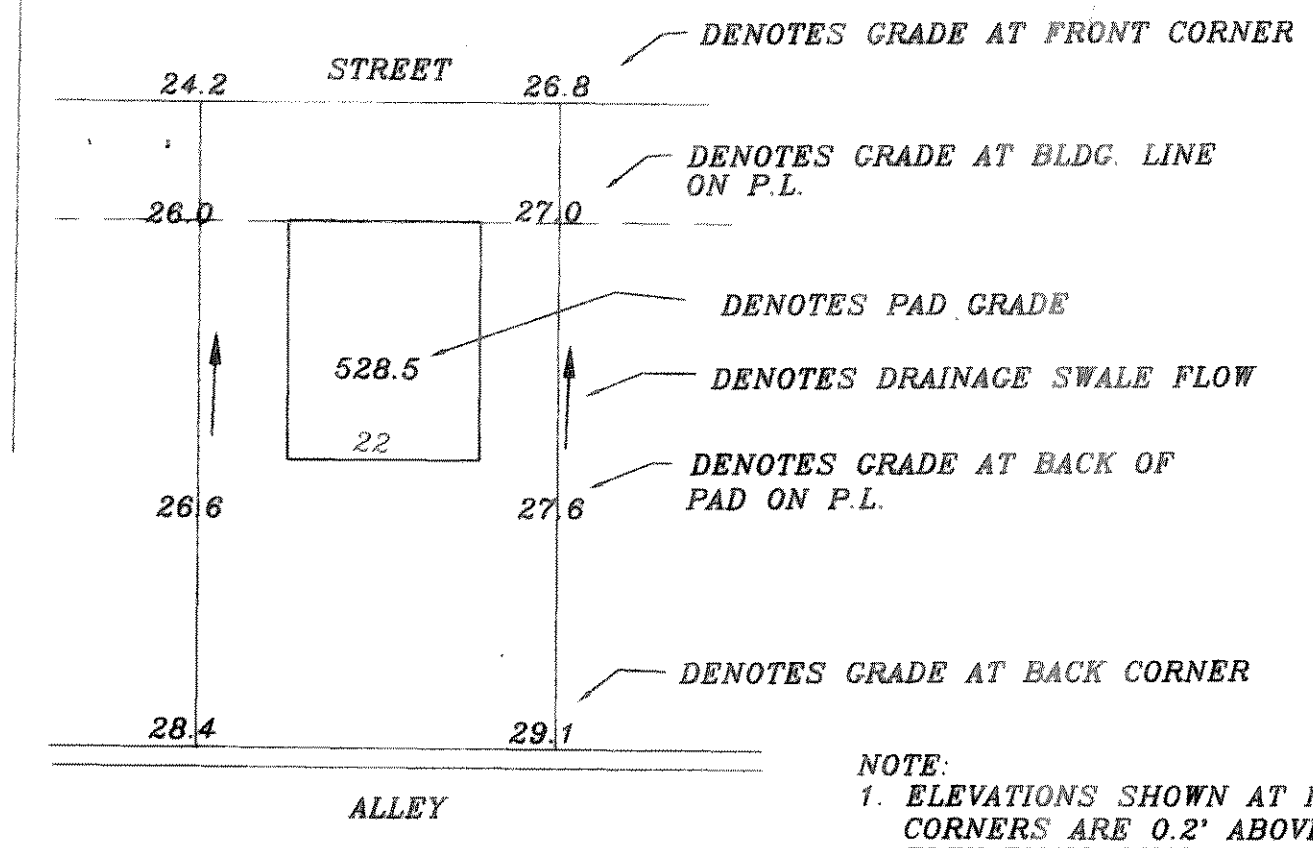

NOTE:  
1. ELEVATIONS SHOWN AT FRONT LOT CORNERS ARE 0.2' ABOVE T.C. GRADE. ELEVATIONS SHOWN AT BACK LOT CORNERS ARE 0.55' ABOVE ALLEY INVERT GRADE.  
2. NO PADS ARE TO BE BUILT ON LOTS 1 & 2, BLOCK D. ARCHITECTS WILL SUBMIT PLANS FOR APPROVAL.

B.M. SQUARE CUT @ CONC. BASE OF CIVIL DEFENCE SIREN NEAR THE WEST CORNER OF LOT 1 - BLOCK A. ELEVATION = 520.33  
B.M. TOP OF MANHOLE @ NEAR THE WEST CORNER OF LOT 44 CHANDLERS LANDING PHASE 2D ELEVATION = 518.72

REV	DATE	DESCRIPTION
1	11/27/96	0651 GRD
2	6/12/96	
3	3/20/96	REV PER 3rd CITY REVIEW
4	3/12/96	REV PER 2nd CITY REVIEW
5	8/21/95	REV PER CITY REVIEW

HAROLD L. EVANS  
CONSULTING ENGINEER  
2331 GUS THOMASSON ROAD, SUITE 102  
DALLAS, TEXAS 75228. (214) 328-8133

REVISION DESCRIPTION	DATE	SCALE	DESIGN	DRAWN
	7/9/96	1" = 40'	H.L.E.	K.E.B.

**GRADING PLAN**  
**LOT GRADING PLAN**  
**NEWPORT PLACE**  
**CITY OF ROCKWALL**

SHEET NO.	9
JOB NO.	9551