



NORTH COLIAD (STATE HWY. 205)

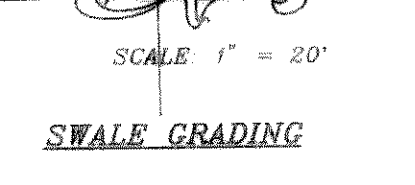

SECTION A-A

203 CODY PLACE  
LOT 3, BLOCK A

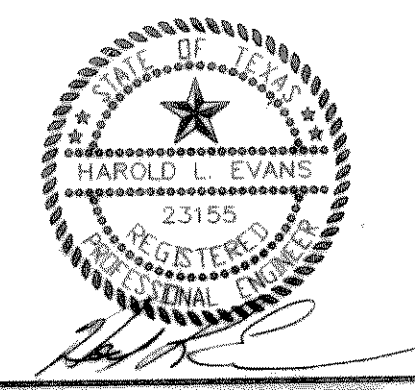

B.M. TOP EXIST SAN SEW M.H. 7.5' EAST AND 30' SOUTH OF THE N.E. CORNER OF PROJECT ELEV. 504.46

B.M. TOP EXIST SAN SEW M.H. 9' EAST AND 124' NORTH OF THE N.E. CORNER OF PROJECT ELEV. 506.86

REVISION DESCRIPTION	DATE
REV INLET AT EAST P.L.	10/31/98
ADDED SWALE, AS-BUILT PAD CRDS.	10/12/98
REV PER CITY STAFF PRECONST COMMENTS	5/26/98
REV PER 3rd CITY REVIEW	5/19/98
REV PER CITY LETTER	5/7/98
REV PER CITY REVIEW	4/3/98

**HAROLD L. EVANS**  
CONSULTING ENGINEER  
P.O. BOX 28955  
2331 CUS THOMASSON ROAD, SUITE 102  
DALLAS, TEXAS 75228 (214) 328-8133

**LOT GRADING PLAN**

**TOWNE NORTH ADDITION**  
CITY OF ROCKWALL

SHEET NO. 8

JOB NO. 97127