


NOTE:
 WATER SERVICES FOR LOTS H-10
 THRU H-14 TO BE RELOCATED TO
 CENTER OF LOTS BY TAPPING MAIN.
 OLD SERVICES TO BE ABANDONED
 FROM THE CORPORATION STOR

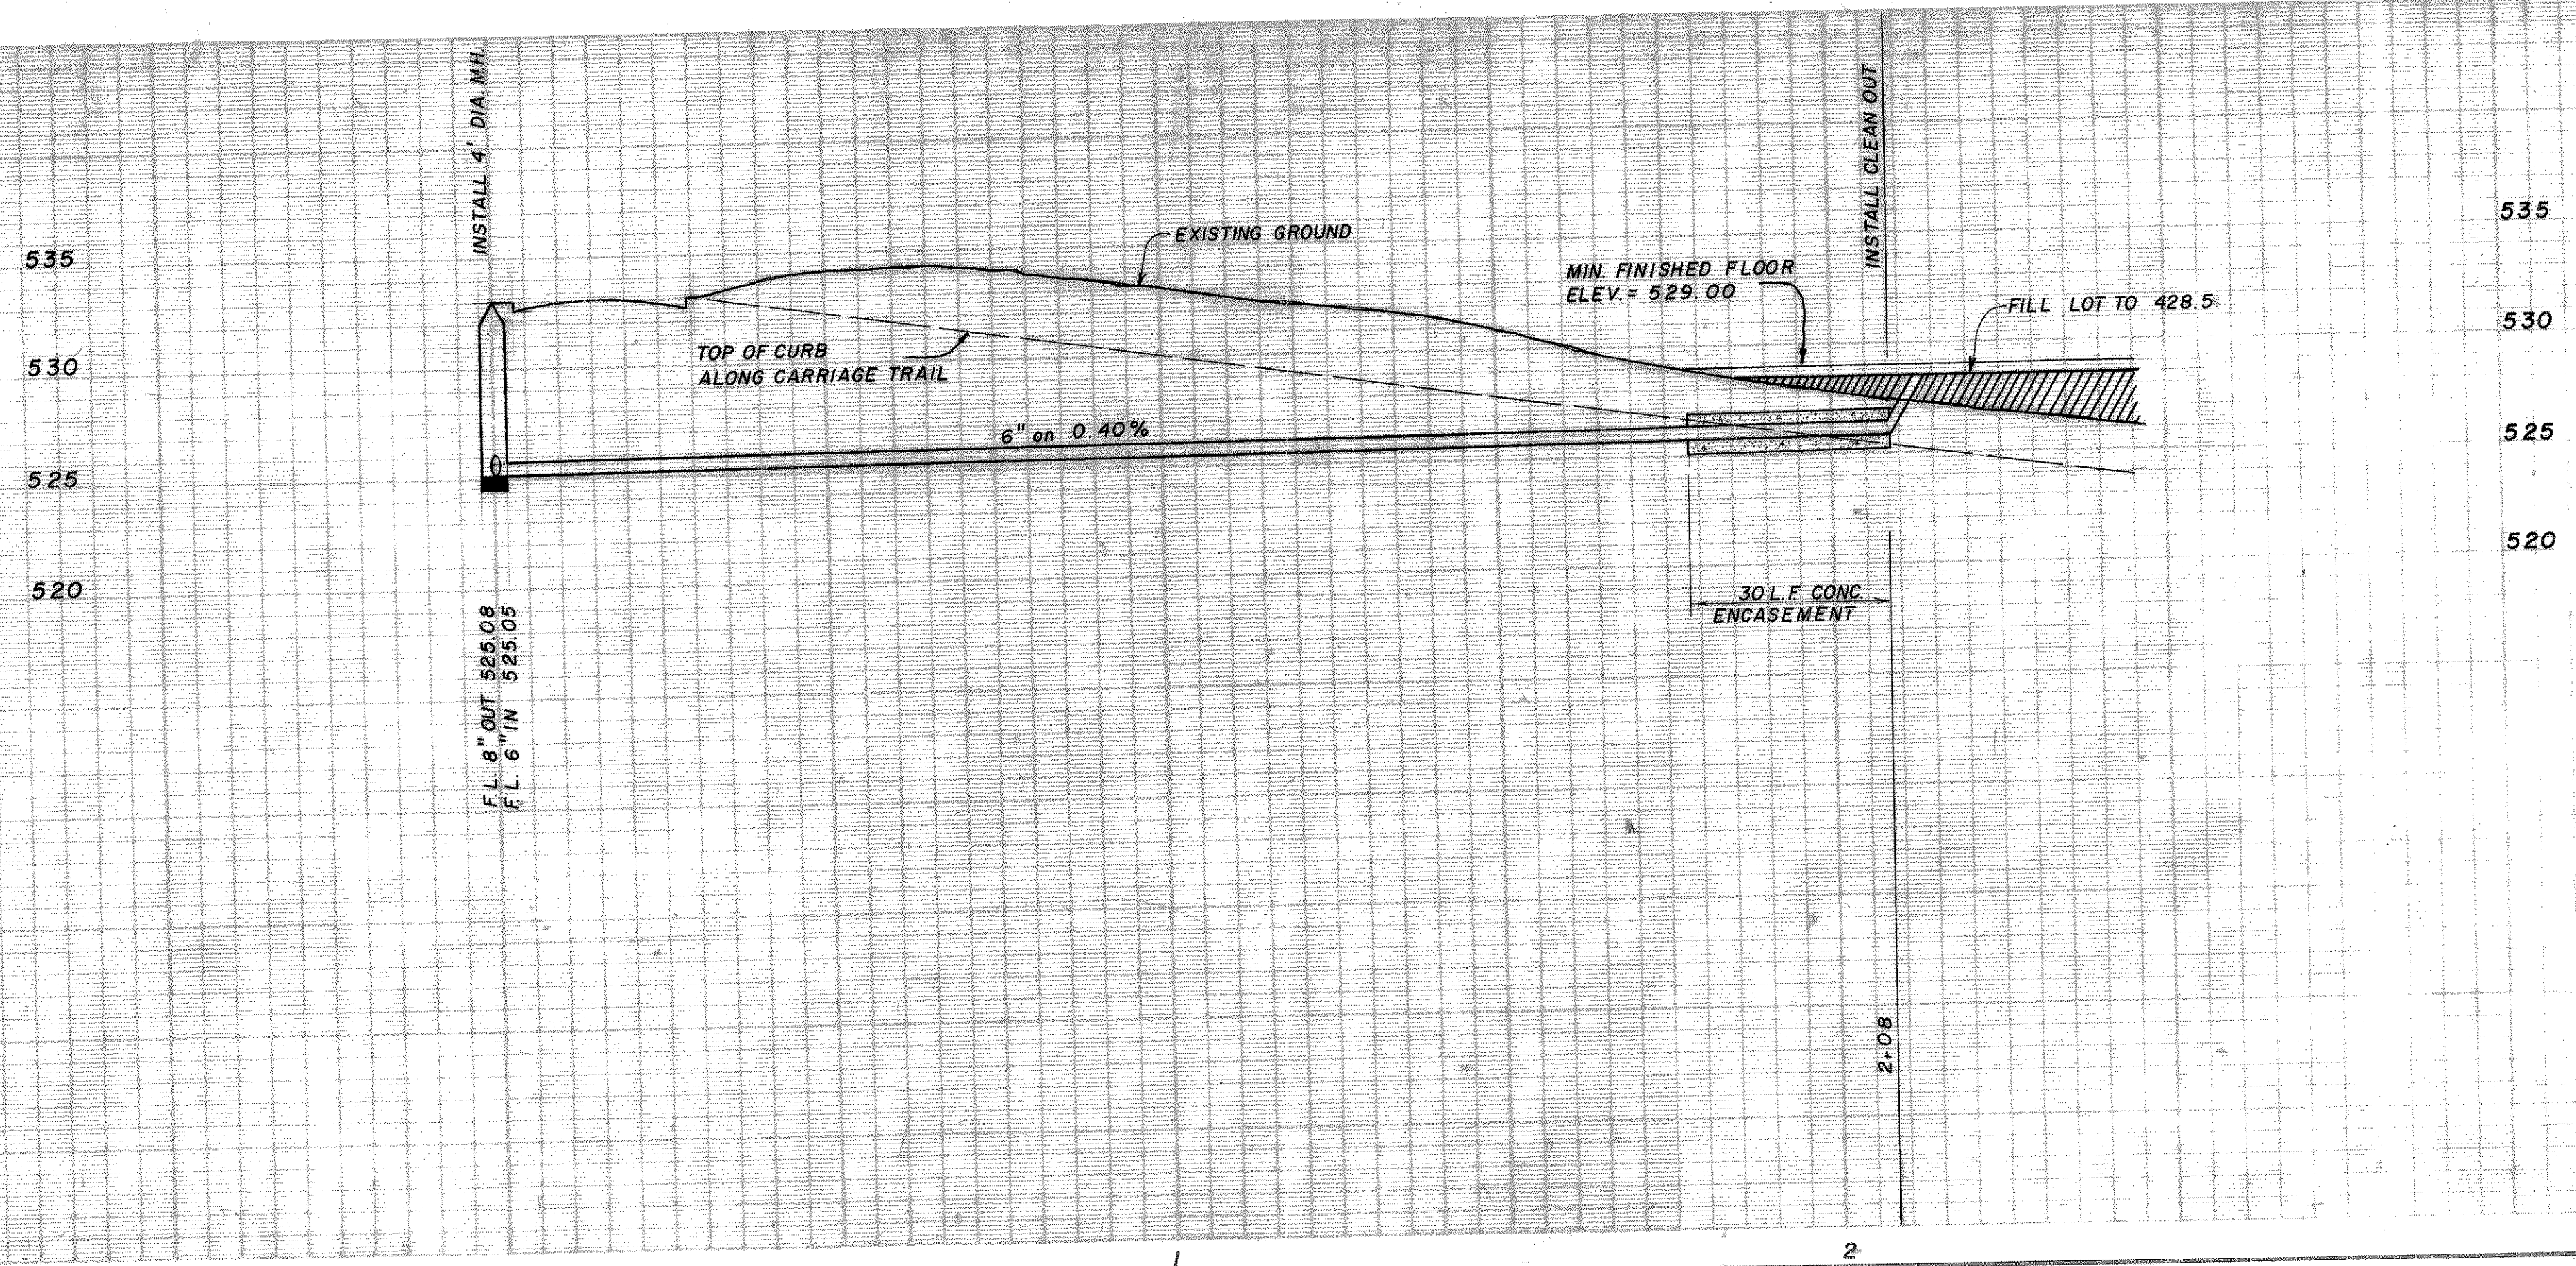

AS BUILT

NORTHSHORE						
PHASE I						
PROPOSED UTILITY REVISIONS						
ROCKWALL, TEXAS						
HAROLD L. EVANS & CONSULTING ENGINEER						
DESIGN	DRAWN	DATE	SCALE	NOTES	FILE	NO.
H. L. E.	J. R. P.	3/6/74	Hor. 1"=20' Vert. 1"=5'			72140