


NOTE;
 UTILITIES SHOWN ARE FOR CONTRACTORS
 CONVENIENCE. IT IS CONTRACTORS RESPONSIBILITY
 TO LOCATE ALL UTILITIES IN THE FIELD.

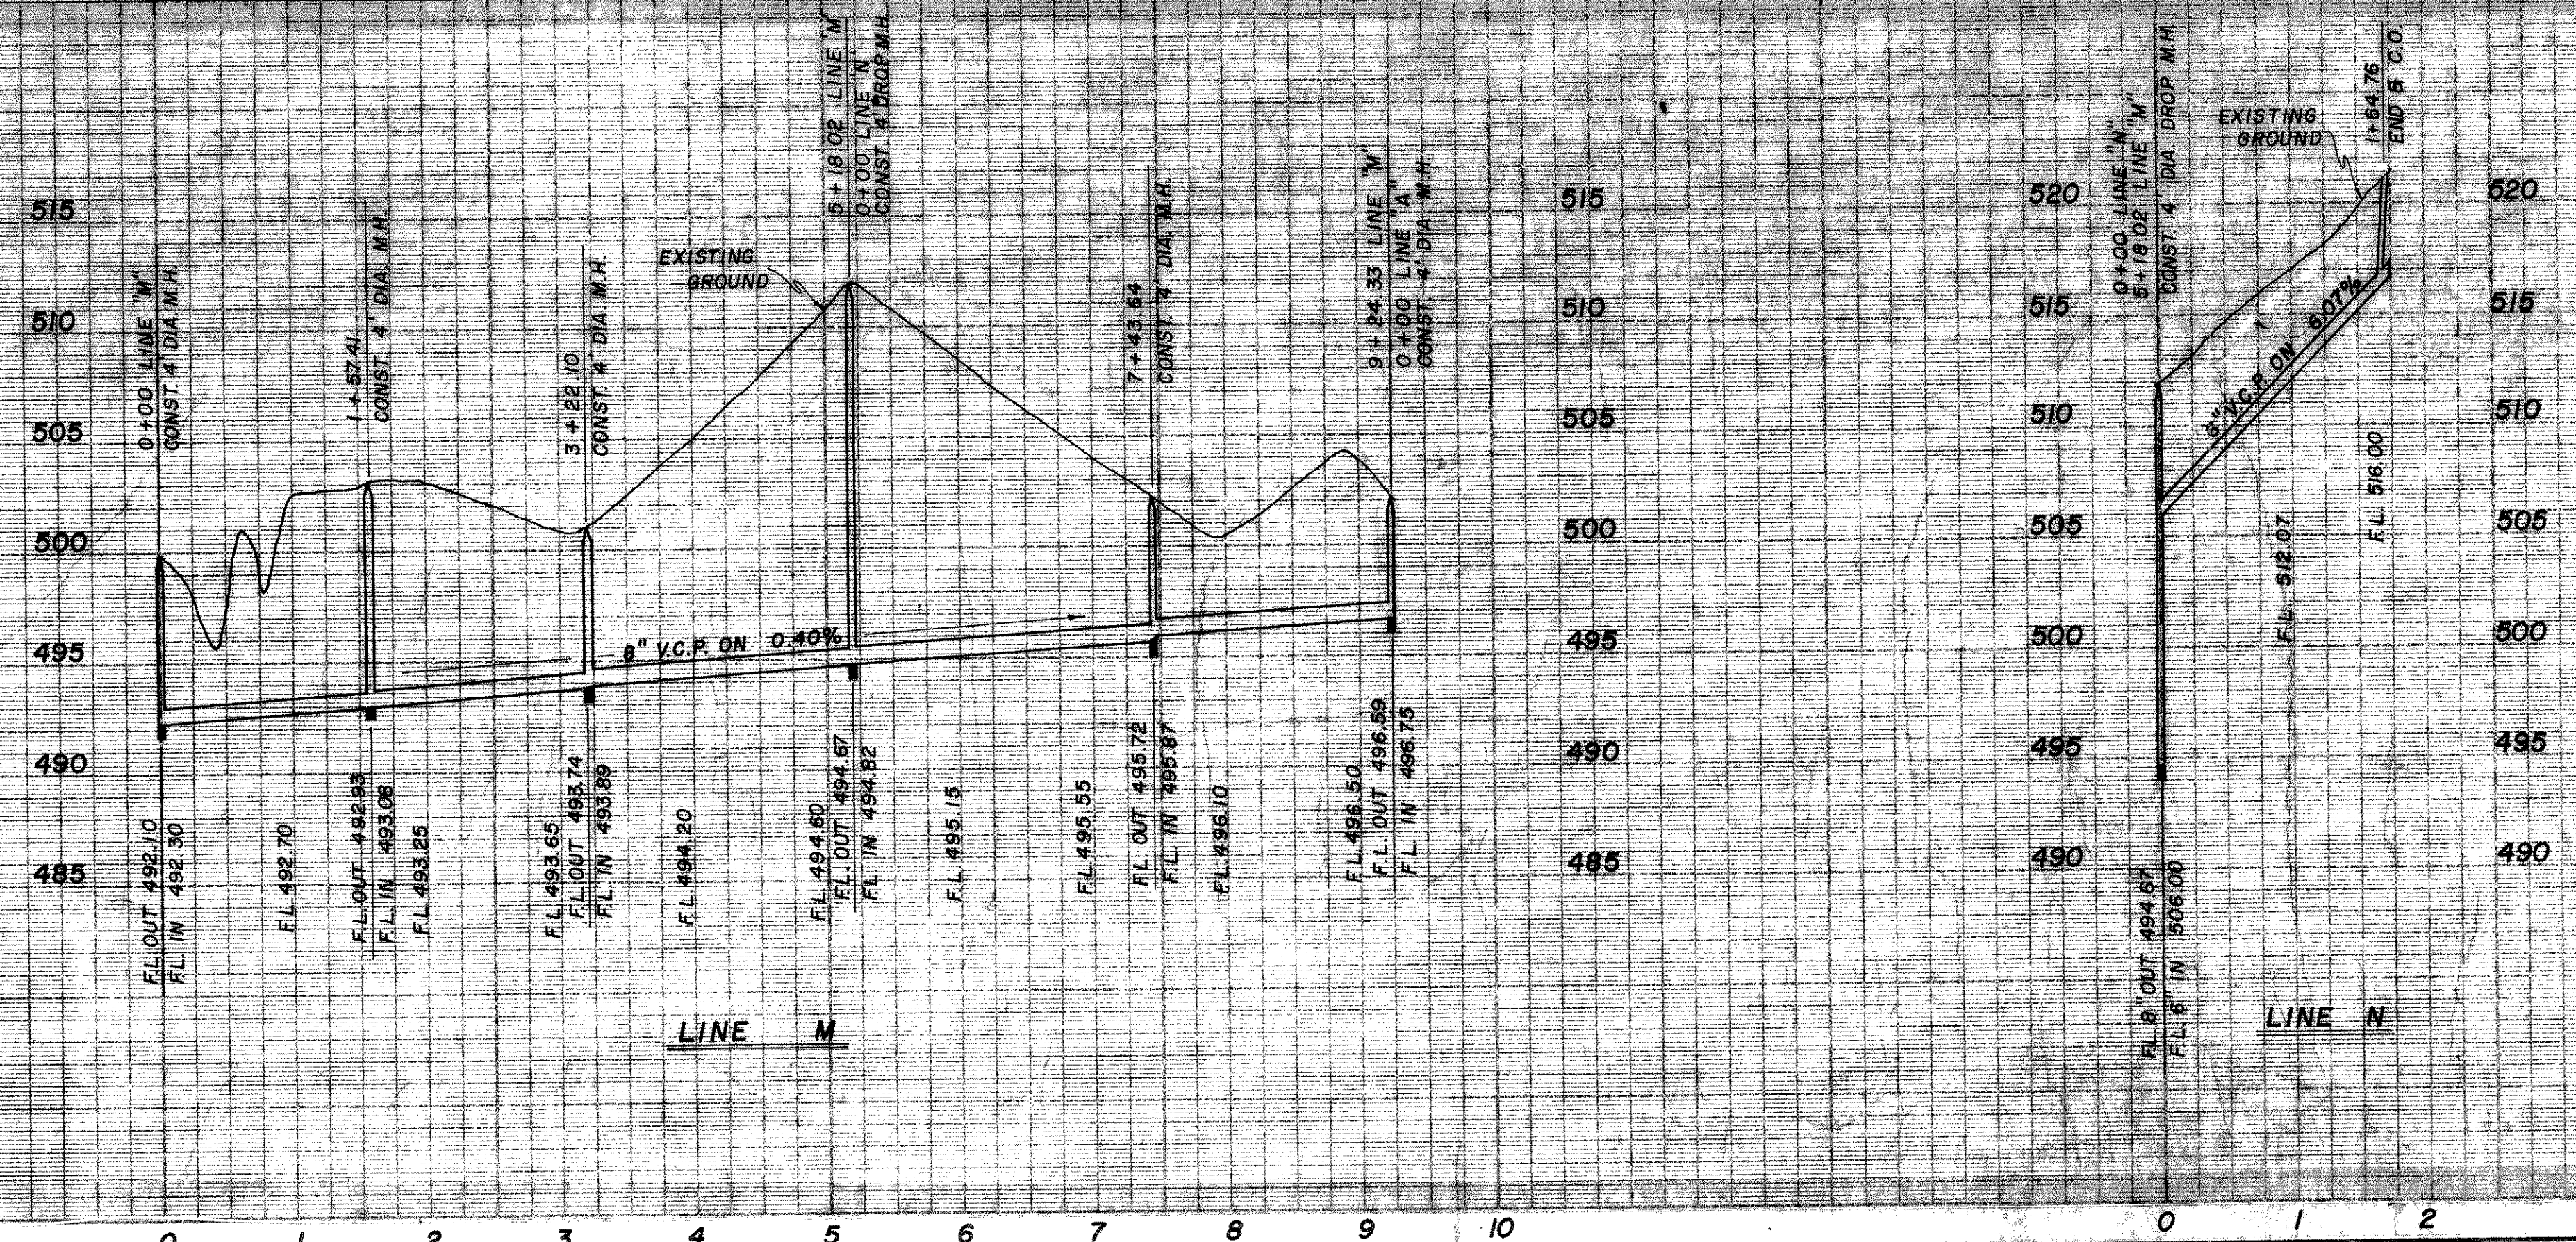

AS BUILT

NORTHSHORE PROPOSED SANITARY SEWER OUTFALL LINES 'M' & 'N' ROCKWALL, TEXAS						
DESIGN	DRAWN	DATE	SCALE	NOTES	FILE	NO.
J.T.S.	R.M.H.	4/73	1"=100'H 1"=6'V			72/40