


DRAINAGE DATA						
AREA	ACRES	L <sub>s</sub>	C	I <sub>s</sub>	C <sub>s</sub>	CS ACCUM
1	1.55	10	0.50	6.8	5.27	~
2	2.29	10	0.50	6.8	7.79	13.06
3	0.20	10	0.50	6.8	0.68	13.74
4	3.04	10	0.50	6.8	10.34	24.08
5	0.39	10	0.50	6.8	1.34	26.42
6	1.92	10	0.50	6.8	4.49	~
7	2.55	10	0.50	6.8	8.67	13.16
8	2.21	10	0.50	6.8	7.51	20.67
9	2.89	10	0.50	6.8	9.83	30.50
10	1.48	10	0.50	6.8	5.03	35.53
11	1.47	10	0.50	6.8	5.00	40.53
12	1.89	10	0.50	6.8	6.43	~
13	1.80	10	0.50	6.8	6.12	~
14	4.82	10	0.50	6.8	16.39	~
15	3.98	10	0.50	6.8	13.53	~
16	1.20	10	0.50	6.8	4.08	~
17	0.56	10	0.50	6.8	1.90	~

5+10 = 60.95  
5+11 = 65.95

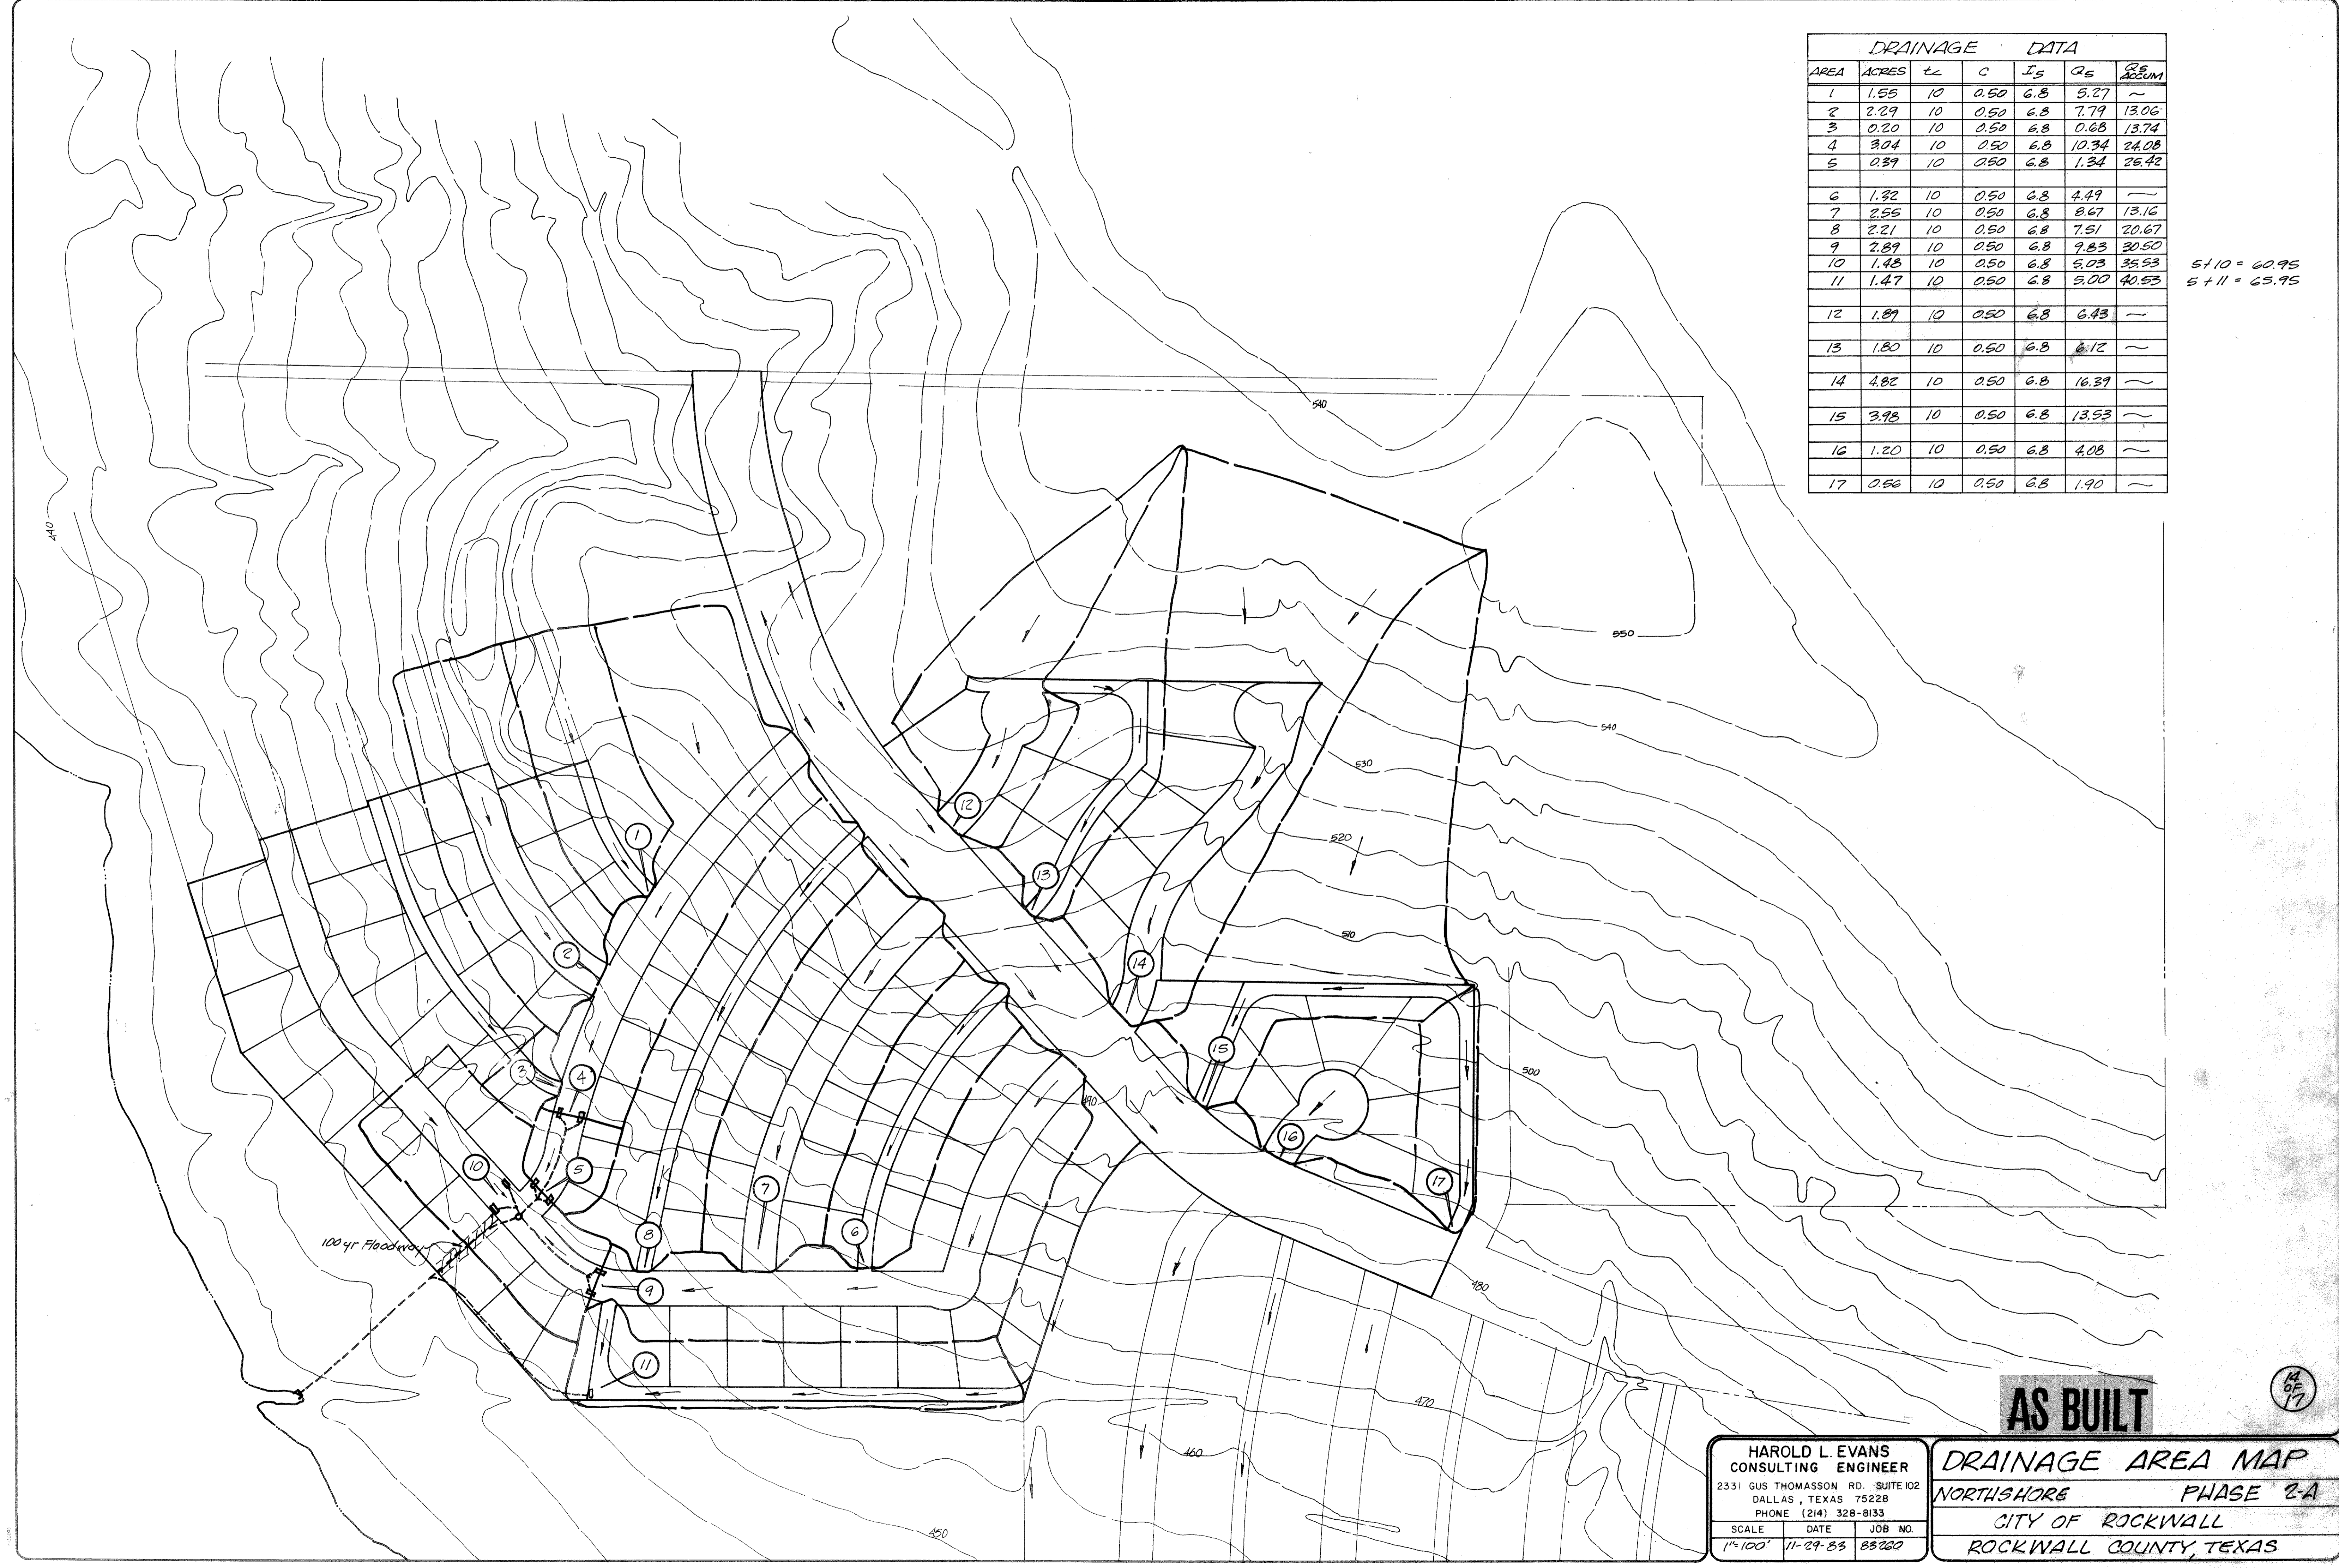

**AS BUILT**

12 OF 17

<b>HAROLD L. EVANS</b> CONSULTING ENGINEER 2331 GUS THOMASSON RD., SUITE 102 DALLAS, TEXAS 75228 PHONE (214) 328-8133			<b>DRAINAGE AREA MAP</b> NORTHSORE PHASE 2-A CITY OF ROCKWALL ROCKWALL COUNTY, TEXAS		
SCALE	DATE	JOB NO.			
1"=100'	11-29-83	83280			