

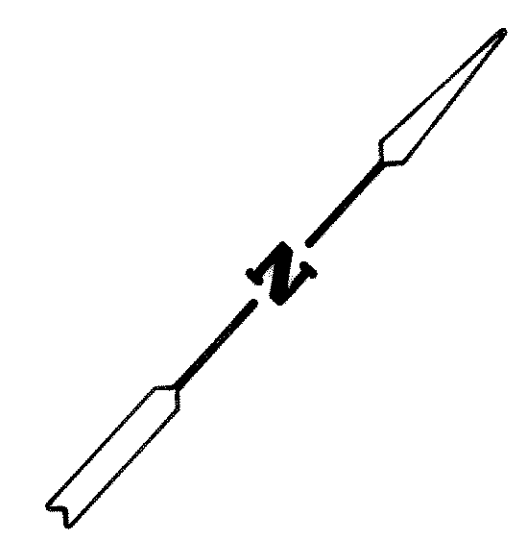


LAKE RAY HUBBARD

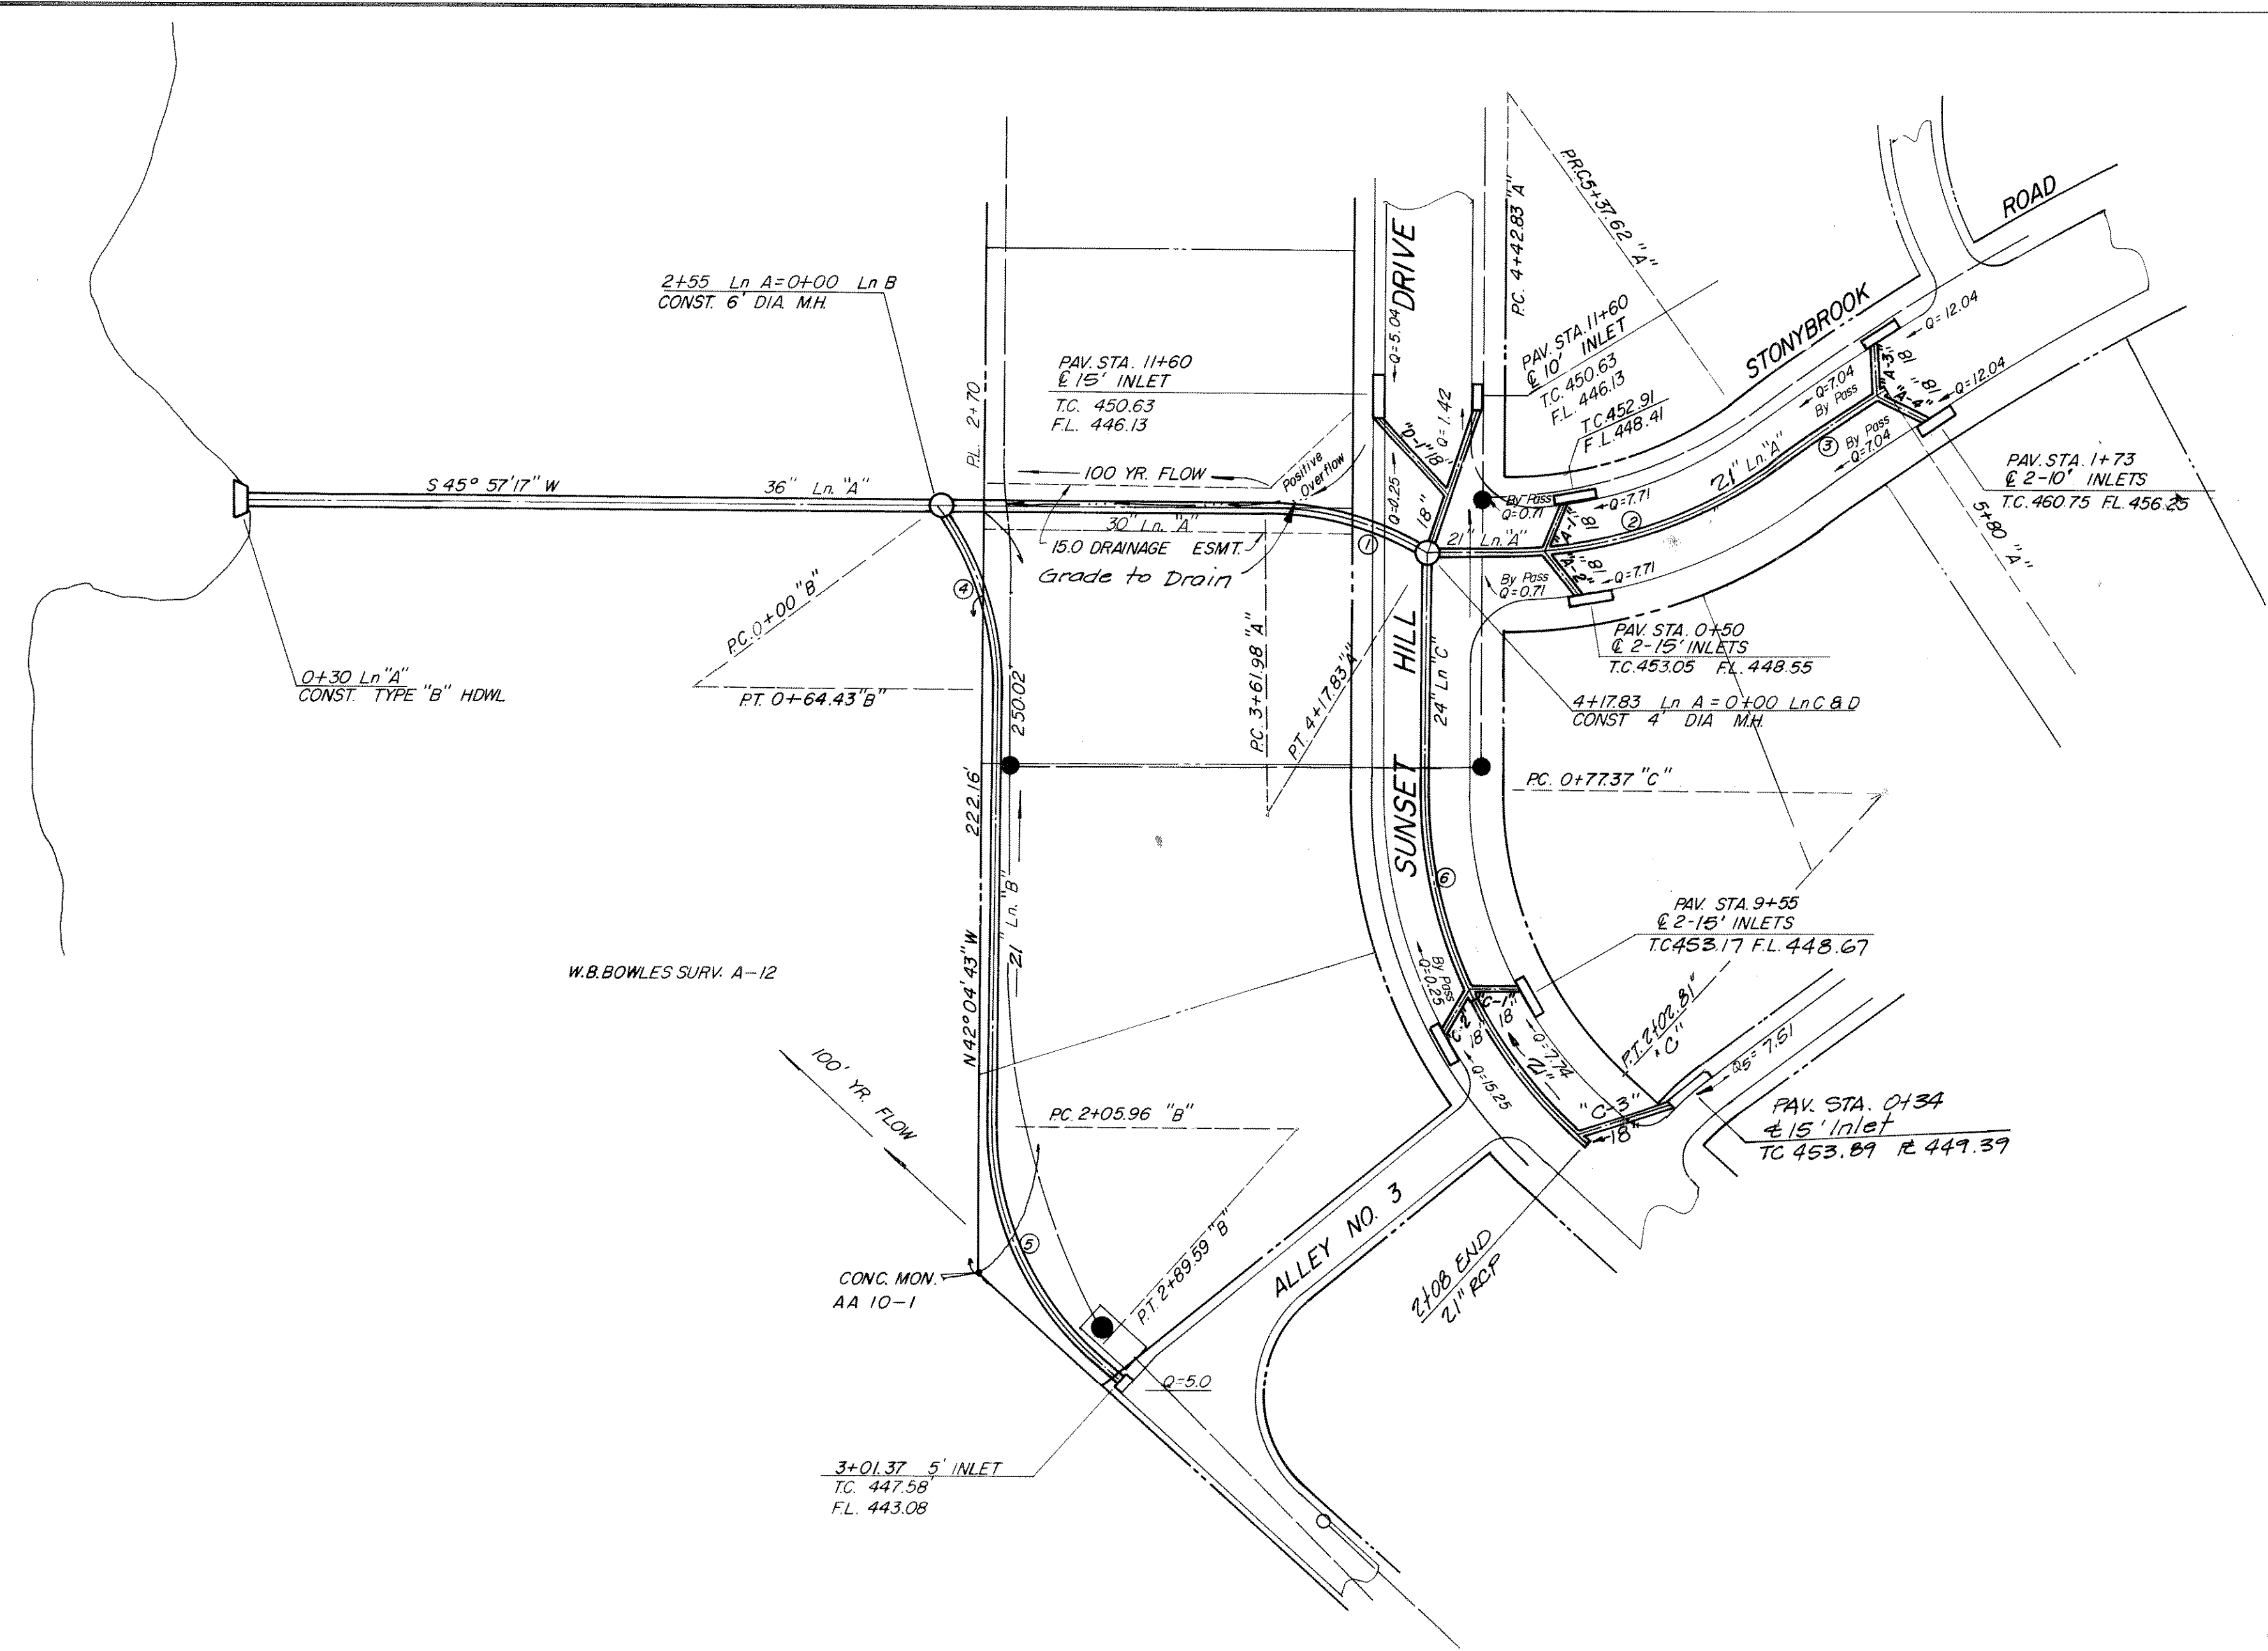

CURVE DATA																	
1	<table border="1"> <tr><td>Δ</td><td>32°00'00"</td><td>Δ</td><td>36°55'00"</td></tr> <tr><td>R</td><td>100.00</td><td>R</td><td>100.00</td></tr> <tr><td>T</td><td>28.67</td><td>T</td><td>33.38</td></tr> <tr><td>L</td><td>55.85</td><td>L</td><td>64.43</td></tr> </table>	Δ	32°00'00"	Δ	36°55'00"	R	100.00	R	100.00	T	28.67	T	33.38	L	55.85	L	64.43
Δ	32°00'00"	Δ	36°55'00"														
R	100.00	R	100.00														
T	28.67	T	33.38														
L	55.85	L	64.43														
2	<table border="1"> <tr><td>Δ</td><td>36°12'30"</td><td>Δ</td><td>47°54'50"</td></tr> <tr><td>R</td><td>150.00</td><td>R</td><td>100.00</td></tr> <tr><td>T</td><td>49.04</td><td>T</td><td>44.43</td></tr> <tr><td>L</td><td>94.79</td><td>L</td><td>83.63</td></tr> </table>	Δ	36°12'30"	Δ	47°54'50"	R	150.00	R	100.00	T	49.04	T	44.43	L	94.79	L	83.63
Δ	36°12'30"	Δ	47°54'50"														
R	150.00	R	100.00														
T	49.04	T	44.43														
L	94.79	L	83.63														
3	<table border="1"> <tr><td>Δ</td><td>02°44'45"</td><td>Δ</td><td>47°54'50"</td></tr> <tr><td>R</td><td>884.31</td><td>R</td><td>150.00</td></tr> <tr><td>T</td><td>21.19</td><td>T</td><td>66.65</td></tr> <tr><td>L</td><td>42.38</td><td>L</td><td>125.44</td></tr> </table>	Δ	02°44'45"	Δ	47°54'50"	R	884.31	R	150.00	T	21.19	T	66.65	L	42.38	L	125.44
Δ	02°44'45"	Δ	47°54'50"														
R	884.31	R	150.00														
T	21.19	T	66.65														
L	42.38	L	125.44														

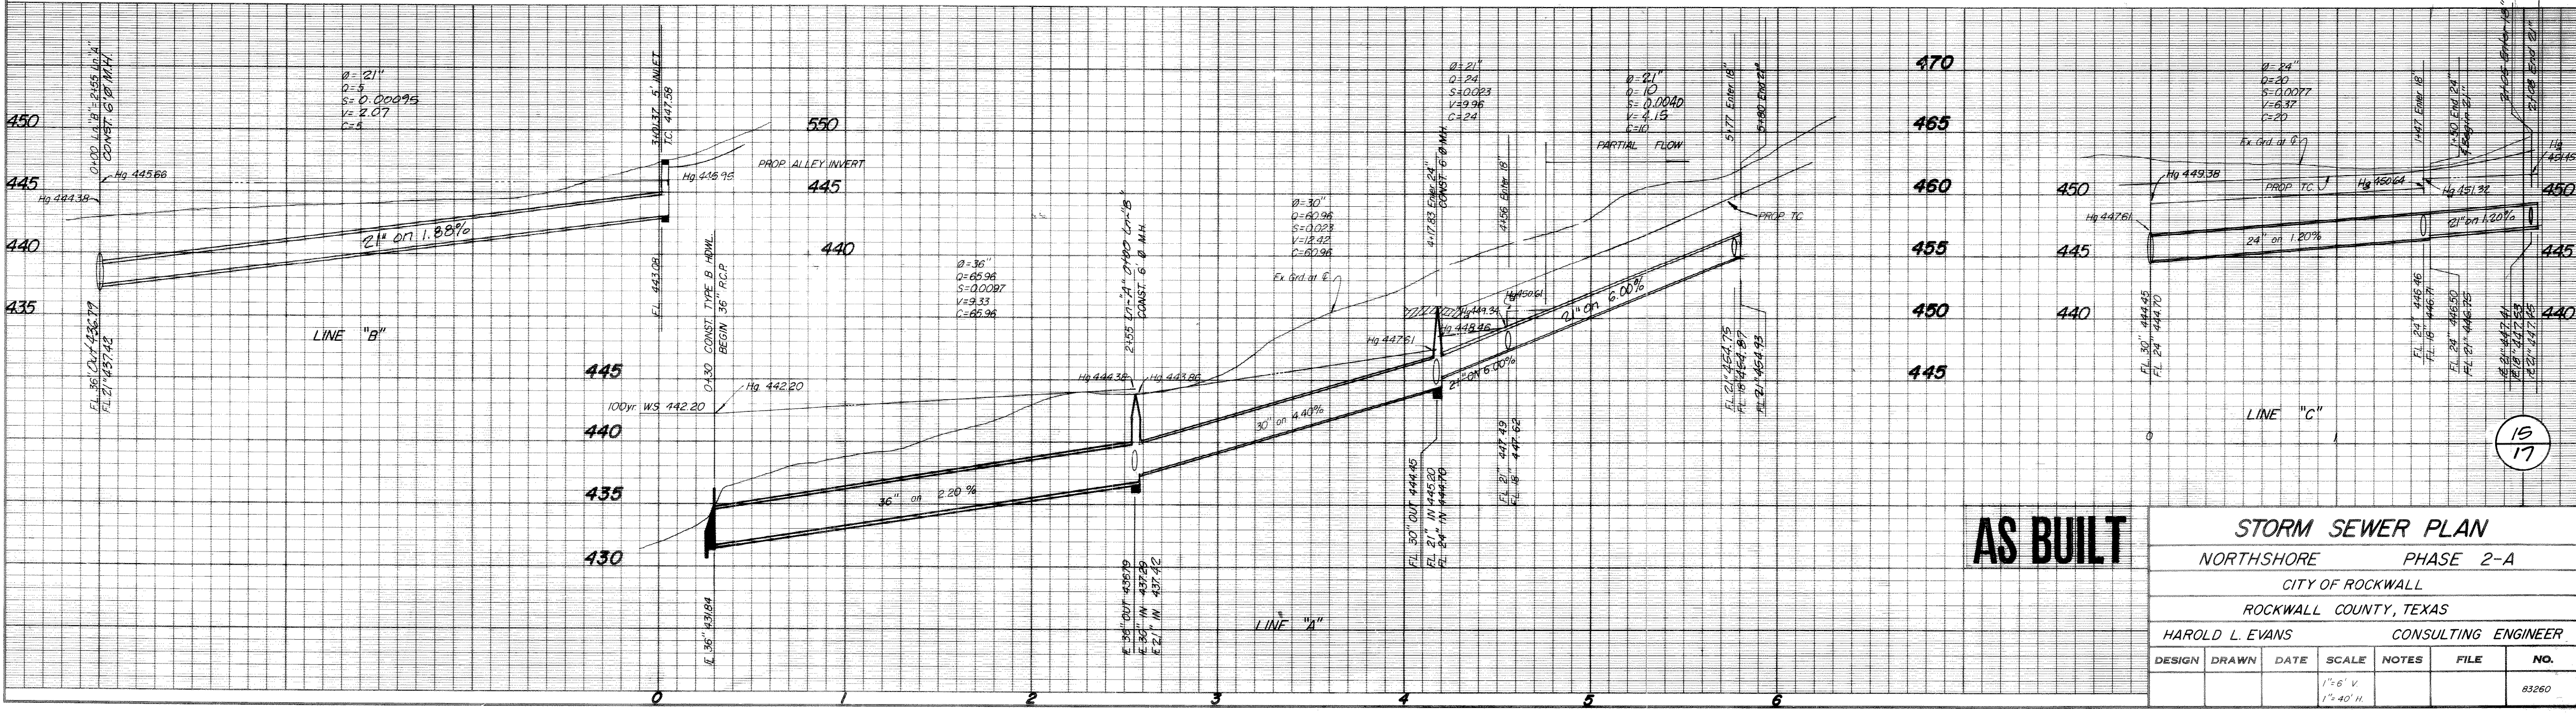

AS BUILT

STORM SEWER PLAN					
NORTHSHORE PHASE 2-A					
CITY OF ROCKWALL					
ROCKWALL COUNTY, TEXAS					
HAROLD L. EVANS			CONSULTING ENGINEER		
DESIGN	DRAWN	DATE	SCALE	NOTES	FILE
			1"=6' V 1"=40' H		
					NO. 83260