

# CONSTRUCTION PLANS


## NORTHSHORE PHASE 4

AN ADDITION TO THE CITY OF ROCKWALL  
ROCKWALL COUNTY, TEXAS

### SHEET INDEX

- 1..... COVER SHEET
- 2 & 3... PLAT
- 4 thru 6... PAVING PLANS
- 7..... DRAINAGE AREA MAP
- 8..... STORM DRAINAGE PLANS
- 9 & 10... WATER & SANITARY SEWER PLANS
- 11..... LOT GRADING PLAN
- 12..... CONDUIT INSTALLATION PLAN

### LOCATION MAP

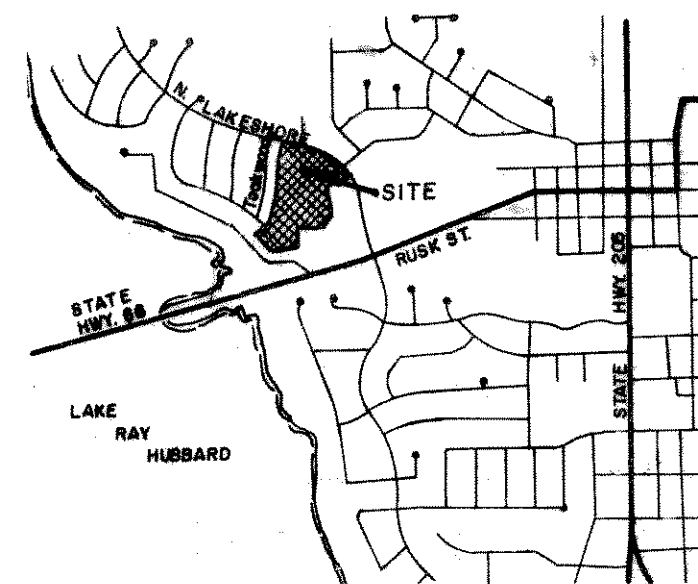

### GENERAL NOTES

ALL CONSTRUCTION SHALL CONFORM TO  
CITY OF ROCKWALL STANDARD SPECIFICATIONS.

### REVISIONS

OWNER :

**BURGY-MILLER, INC.**  
319 YACHT CLUB DRIVE  
ROCKWALL, TEXAS 75087

PREPARED BY:

**HAROLD L. EVANS & ASSOCIATES**  
CONSULTING ENGINEERS  
2331 GUS THOMASSON ROAD, Suite 102  
DALLAS, TEXAS 75228  
PHONE: (214) 328-8133

AS-BUILT

11-8-87