


OAC SENIOR LIVING, LLC.
ROCKWALL BY-PASS ADDITION
STORM DRAIN PLAN
ROCKWALL, TEXAS

PROJECT TITLE:
OAC SENIOR LIVING, LLC.
ROCKWALL BY-PASS ADDN.

mima
mycoskie+mcinnis+associates
civil engineering surveying landscape architecture planning
texas registration number: f-2759
200 east abram
arlington, texas 76010
817-489-1871
fax: 817-274-8757
www.mimacosks.com

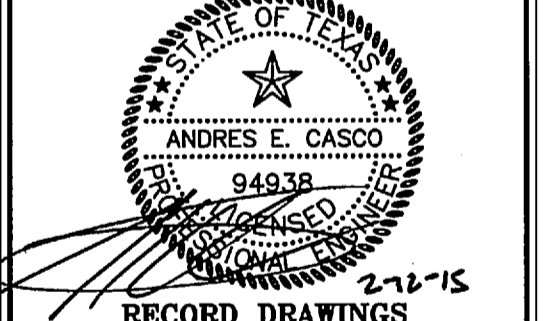

RECORD DRAWINGS
2-12-15

PROJECT NUMBER: 2651-00-01
PROJECT MANAGER: J. SUMPTER
DRAWN BY: S. BELL
CHECKED BY: A. CASCO
ISSUE DATE: 04/30/2013

TO THE BEST OF OUR KNOWLEDGE, MYCOSKIE MCINNIS ASSOCIATES, INC. HEREBY STATES THAT THIS PLAN IS AS-BUILT. THIS IS BASED ON SURVEY DATA, VISUAL POST-CONSTRUCTION FIELD OBSERVATIONS AND INFORMATION PROVIDED BY THE CONTRACTOR.

02.12.15 RECORD DRAWINGS AEC

REV. DATE DESCRIP. BY

SHEET CONTENT:
STORM DRAIN PLAN