


SD-A (PRIVATE)


SD-D (PUBLIC)

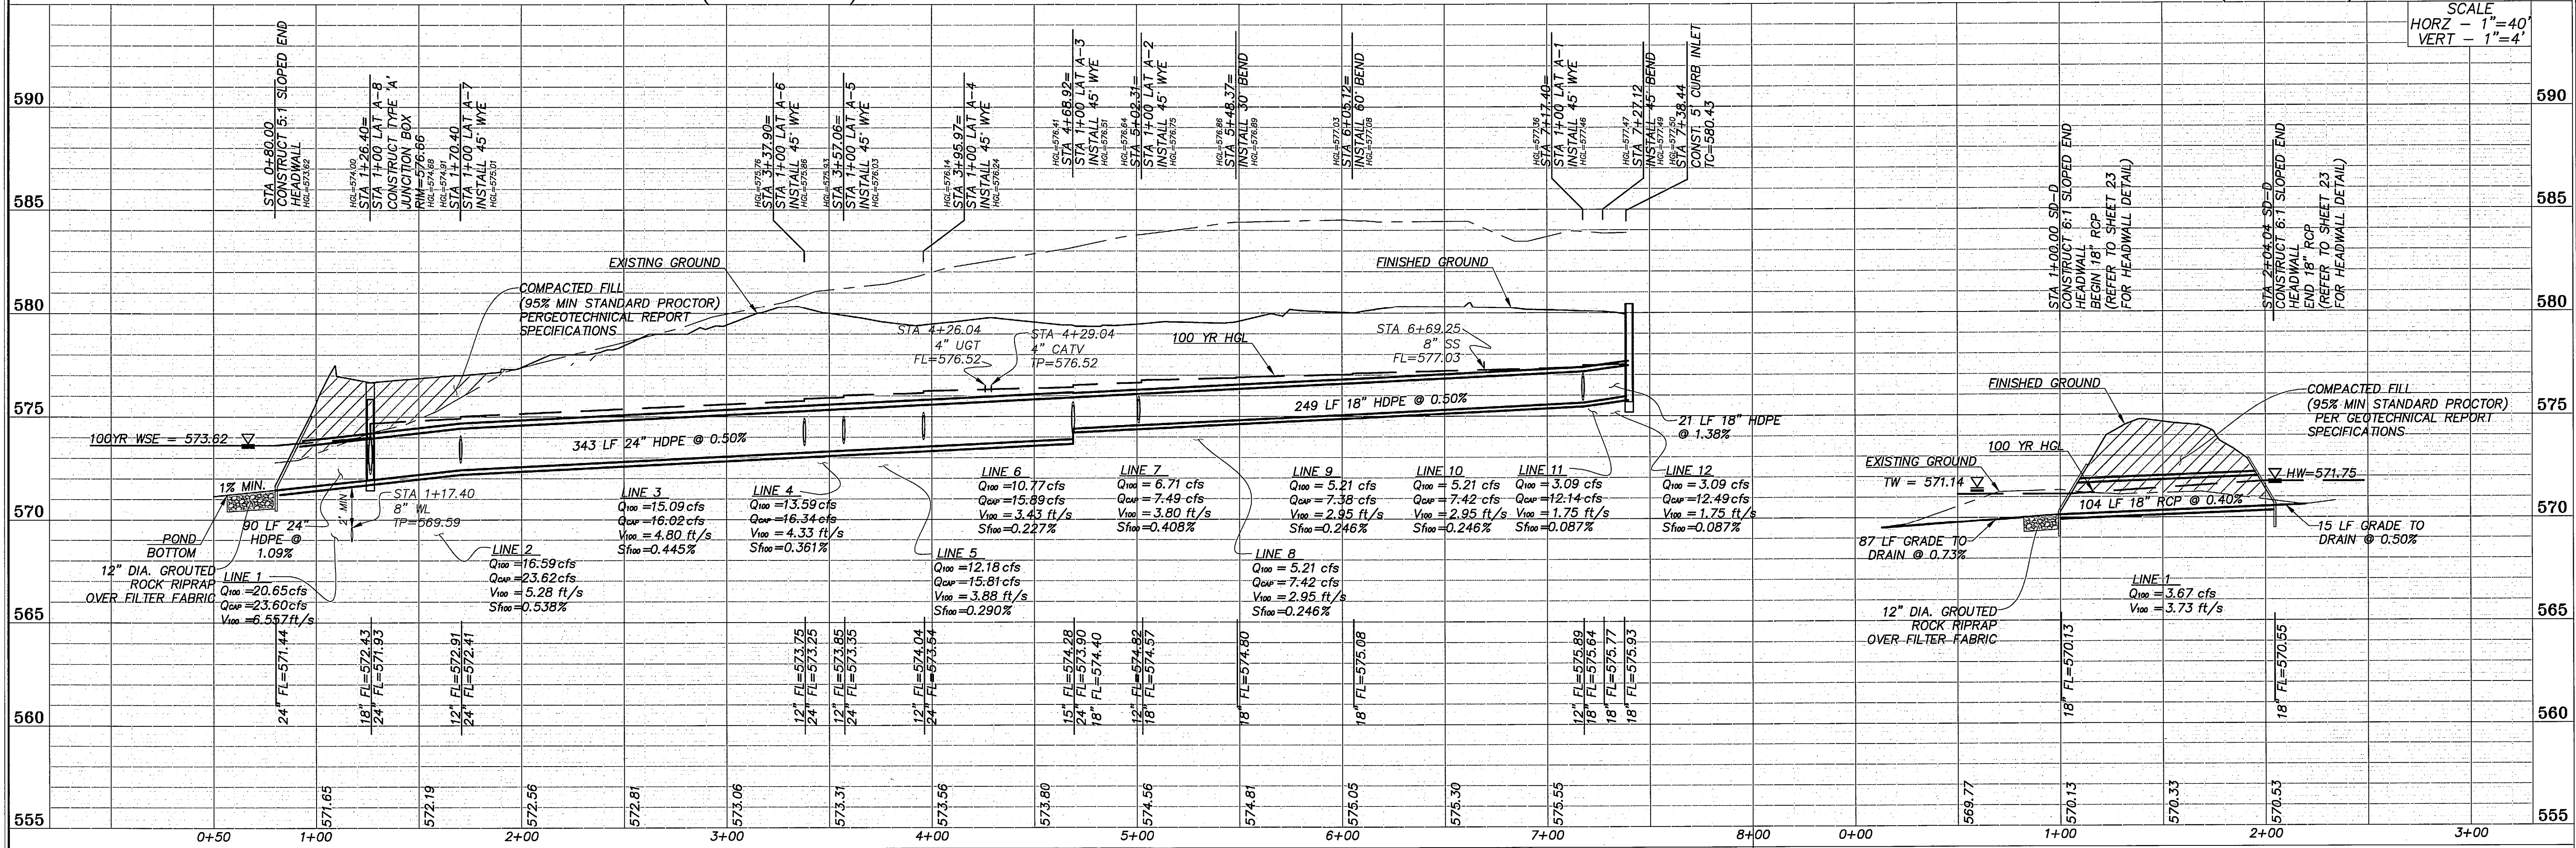

SCALE
 HORZ - 1"=40'
 VERT - 1"=4'

SD-B (PRIVATE)

SD-C (PUBLIC)

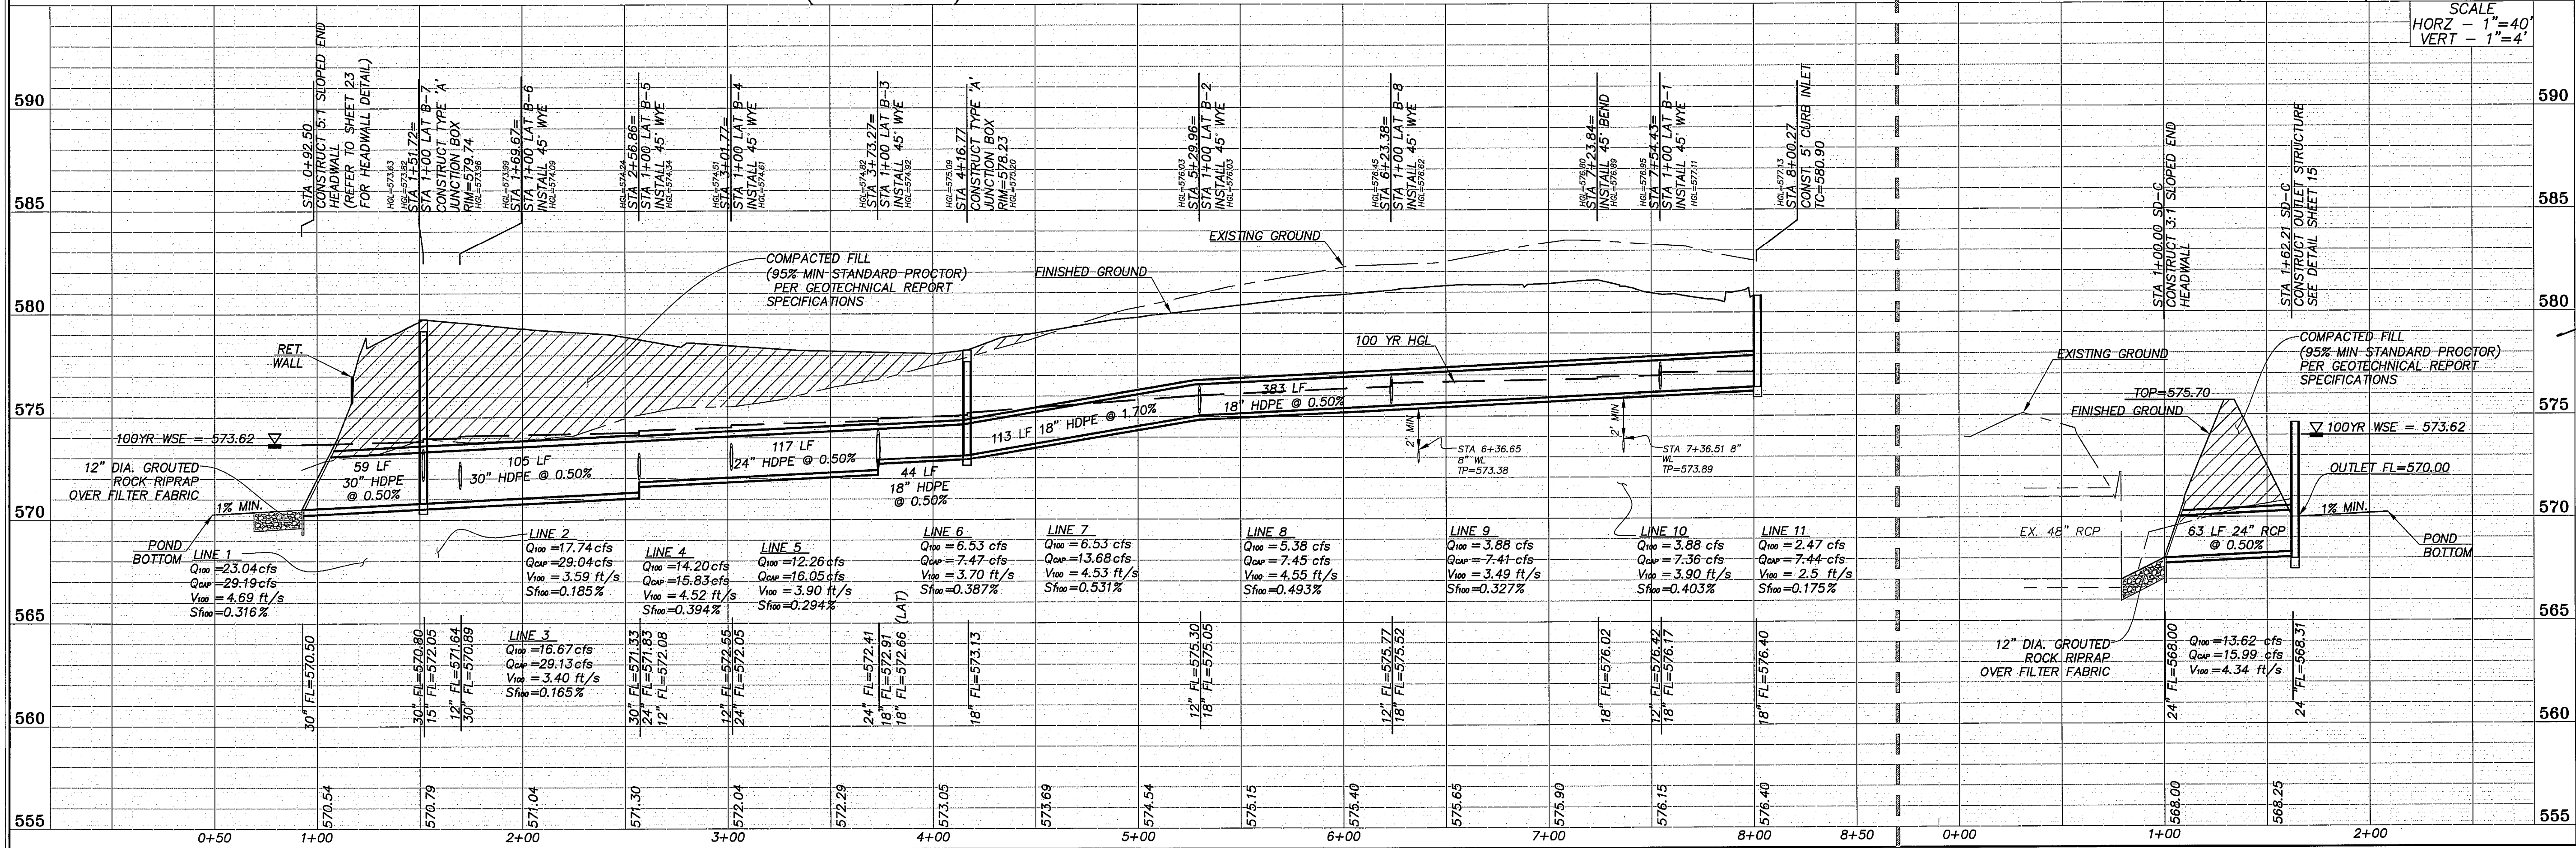

SCALE
 HORZ - 1"=40'
 VERT - 1"=4'

OAC SENIOR LIVING, LLC.
 ROCKWALL BY-PASS ADDITION
 SD-A, SD-B, SD-C, & SD-D PROFILES
 ROCKWALL, TEXAS

PROJECT TITLE:
 OAC SENIOR LIVING, LLC.
 ROCKWALL BY-PASS ADDN.

mima
 mycoskie+mcinnis+associates
 civil engineering surveying landscape architecture planning
 the registration number: 1-2759
 200 east abram
 arlington, texas 76010
 817-469-1671
 fax: 817-274-8757
 www.mimaco.com

STATE OF TEXAS
 ANDRES E. CASCO
 94938
 LICENSED PROFESSIONAL ENGINEER
 RECORD DRAWINGS
 PROJECT NUMBER: 2651-00-01
 PROJECT MANAGER: J. SUMPTER
 DRAWN BY: S. BELL
 CHECKED BY: A. CASCO
 ISSUE DATE: 04/30/2013

TO THE BEST OF OUR KNOWLEDGE,
 MYCOSKIE+MCINNIS+ASSOCIATES, INC.
 HEREBY STATES THAT THIS PLAN IS
 AS-BUILT. THIS IS BASED ON
 SURVEY DATA, VISUAL
 POST-CONSTRUCTION FIELD
 OBSERVATIONS AND INFORMATION
 PROVIDED BY THE CONTRACTOR.

02.12.15 RECORD DRAWINGS AEC

REV. DATE DESCRIP. BY
 SHEET CONTENT:
 SD-A, SD-B,
 SD-C, & SD-D
 PROFILES

SHEET NO:
 12
 COPYRIGHT © 2013 MMA, INC.