


SCALE
 HORZ - 1"=40'
 VERT - 1"=4'

OAC SENIOR LIVING, LLC.
ROCKWALL BY-PASS ADDITION
 SANITARY SEWER PROFILES SS-A
 ROCKWALL, TEXAS

PROJECT TITLE:
 OAC SENIOR LIVING, LLC.
 ROCKWALL BY-PASS ADDN.

m|ma
 mycoskie+mcinnis+associates
 civil engineering surveying landscape architecture planning
 ltpc registration number: f - 2759
 200 east abram
 arlington, texas 76010
 817-469-1671
 fax: 817-274-8757
 www.mmatexas.com

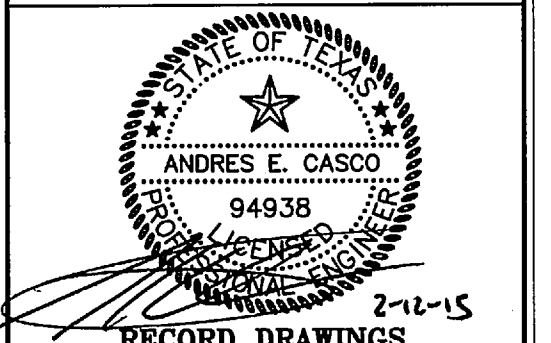

2-12-15
RECORD DRAWINGS
 PROJECT NUMBER: 2651-00-01
 PROJECT MANAGER: J. SUMPSTER
 DRAWN BY: S. BELL
 CHECKED BY: A. CASCO
 ISSUE DATE: 04/30/2013

TO THE BEST OF OUR KNOWLEDGE, MYCOSKIE MCINNIS ASSOCIATES, INC. HEREBY STATES THAT THIS PLAN IS AS-BUILT. THIS IS BASED ON SURVEY DATA, VISUAL POST-CONSTRUCTION FIELD OBSERVATIONS AND INFORMATION PROVIDED BY THE CONTRACTOR.

02.12.15 RECORD DRAWINGS AEC

12.31.13 ADD GAS CROSSING AEC
 REV. DATE DESCRIP. BY

SHEET CONTENT:
SANITARY SEWER PROFILES:
 SS-A

SHEET NO:
19
 COPYRIGHT © 2013 MMA, INC.

RESPONSIBILITY NOTE:

"ALL RESPONSIBILITY FOR ADEQUACY DESIGN REMAINS WITH THE DESIGN ENGINEER. THE CITY OF ROCKWALL, IN REVIEWING AND RELEASING PLANS FOR CONSTRUCTION, ASSUMES NO RESPONSIBILITY FOR ADEQUACY OR ACCURACY OF DESIGN."

BENCHMARK:

BM NO. 1
 CITY OF ROCKWALL R-19. BRASS MONUMENT AT THE NORTHWEST CORNER OF SILVERVIEW & DIAMOND WAY, ±500' SOUTH OF SH 276.

PUBLISHED NAVD88 ELEV: 600.69'

BM NO. 2
 BOX CUT ON TOP OF THE WEST CURB LINE OF SH 205 BYPASS, ON THE SOUTH CURB RETURN OF A DRIVEWAY, 615' SOUTH OF THE CENTERLINE OF SH 276, AND 19' NORTHEAST OF A 5/8" CAPPED IRON ROD STAMPED "MYCOSKIE MCINNIS".

ELEV: 581.15'

GENERAL UTILITY NOTES:

ALL EXISTING UTILITY DATA IS PROVIDED FOR INFORMATION ONLY. ALTHOUGH THIS DATA IS SHOWN AS ACCURATELY AS POSSIBLE, THE CONTRACTOR IS CAUTIONED THAT THE OWNER AND THE ENGINEER NEITHER ASSUMES NOR IMPLIES ANY RESPONSIBILITY FOR THE ACCURACY OF THIS DATA. IT SHALL BE THE CONTRACTOR'S RESPONSIBILITY TO CONTACT THE UTILITY AFFECTED AND VERIFY THESE LOCATIONS AND ELEVATIONS PRIOR TO CONSTRUCTION.

CALL 1-800-344-8377 (DIG-TESS) OR OTHER UTILITY LOCATING SERVICES 48 HOURS PRIOR TO CONSTRUCTION ACTIVITY. MYCOSKIE MCINNIS ASSOCIATES, INC. IS NOT RESPONSIBLE FOR KNOWING ALL EXISTING UTILITIES OR DEPICTING EXACT LOCATIONS OF UTILITIES ON DRAWINGS.