


OAC SENIOR LIVING, LLC.
ROCKWALL BY-PASS ADDITION
 DETAILS
 DRAINAGE DETAILS

PROJECT TITLE:
OAC SENIOR LIVING, LLC.
ROCKWALL BY-PASS ADDN.

mima
 mycoskie+mcinnis+associates
 civil engineering surveying landscape architecture planning
 ltrpe registration number: f - 2759
 200 east abram
 arlington, texas 76010
 817-469-1671
 fax: 817-274-8757
 www.mimotexas.com

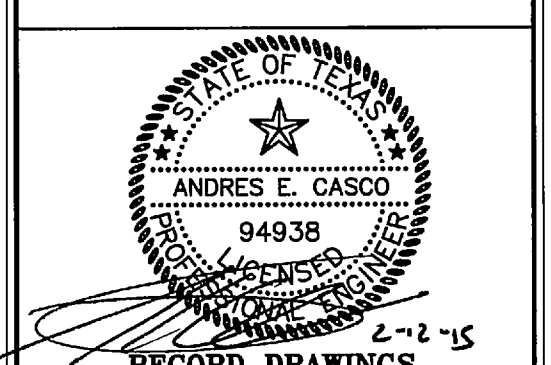

RECORD DRAWINGS
 PROJECT NUMBER: 2651-00-01
 PROJECT MANAGER: J. SUMPTER
 DRAWN BY: S. BELL
 CHECKED BY: A. CASCO
 ISSUE DATE: 04/30/2013

TO THE BEST OF OUR KNOWLEDGE MYCOSKIE MCINNIS ASSOCIATES, INC. HEREBY STATES THAT THIS PLAN IS AS-BUILT. THIS IS BASED ON SURVEY DATA, VISUAL POST-CONSTRUCTION FIELD OBSERVATIONS AND INFORMATION PROVIDED BY THE CONTRACTOR.

02.12.15 RECORD DRAWINGS AEC

REV. DATE DESCRIP. BY

SHEET CONTENT:
DRAINAGE DETAILS