


MATCH LINE SEE SHEET 16

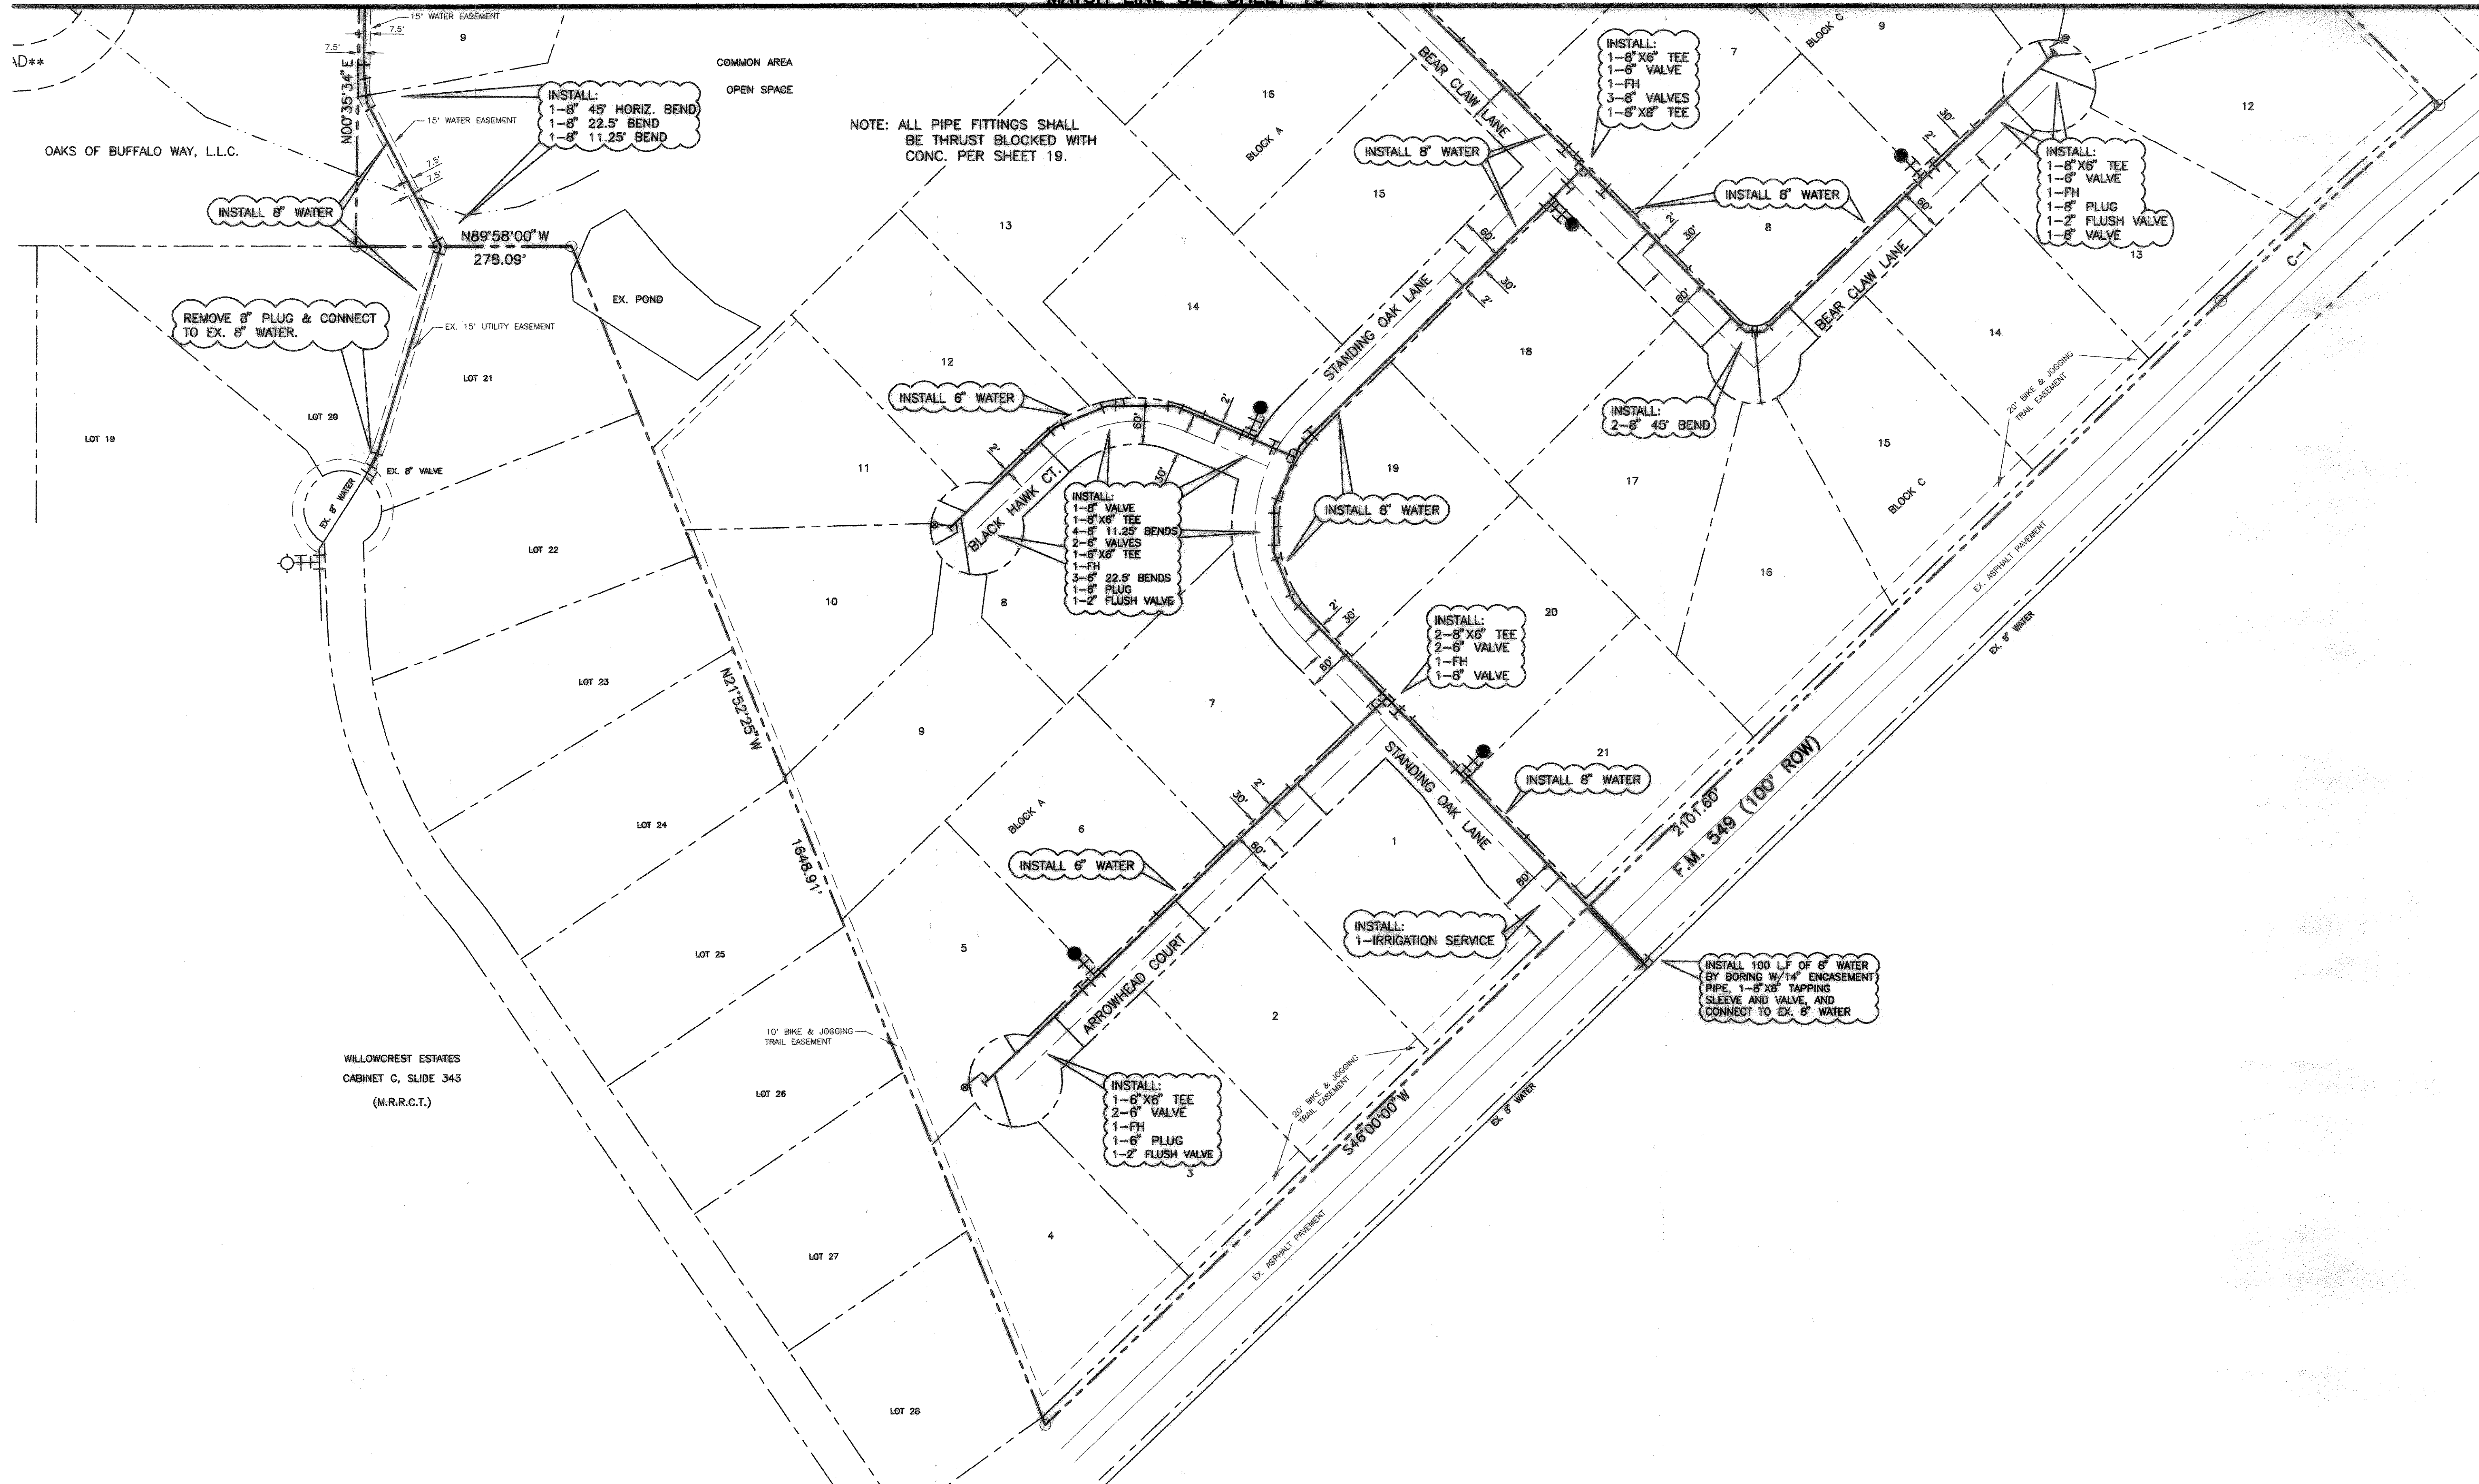

NOTE: ALL PIPE FITTINGS SHALL BE THRUST BLOCKED WITH CONC. PER SHEET 19.


WILLOWCREST ESTATES
CABINET C, SLIDE 343
(M.R.R.C.T.)

THE OAKS OF BUFFALO WAY
OWNER: OAKS OF BUFFALO WAY, L.L.C.

WATER PLAN

FREEMAN - MILLICAN, Inc.
 CONSULTING ENGINEERS
 3200 BROADWAY BLVD., SUITE 272
 OAKLAND, TEXAS 75043
 (214) 278-2850

No.	Date	Revision
2	2/14/97	Revised per RCH comments
1	1/27/97	Revised per RCH comments

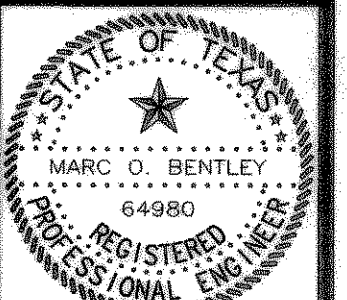

THE SEAL APPEARING ON THIS DOCUMENT WAS AUTHORIZED BY MARC O. BENTLEY, P.E. NO. 64980 ON 1/10/97

Scale:	1" = 100'
Date:	NOV. 1996
Project No.:	96149
Designed:	FMI
Drawn:	FMI
Checked:	MOB

F:\Tractive\96149 - JONES The Oaks\96149P.DWG Mon Jan 12 10:57:39 2004 ALEX C.