


No.	Date	By

THE OAKS OF BUFFALO WAY  
 OWNER: OAKS OF BUFFALO WAY, L.L.C.  
**PAVING PLAN**  
 BEAR CLAW STA 0+00 - STA 12+00

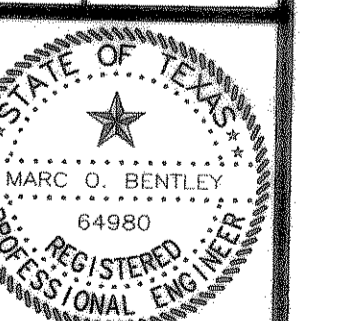

THE SEAL APPEARING ON THIS DOCUMENT WAS AUTHORIZED BY MARC O. BENTLEY, P.E. NO. 64980 ON 1/10/97

Scale: 1" = 40' H  
 1" = 5' V

Date: NOV. 1996

Project No.: 96149

Designed: FMI

Drawn: FMI

Checked: MOB

