


PAVING


1. All embankment shall be compacted to 95% Standard Proctor density.
2. All streets shall be placed on lime stabilized subgrade with a lime content of not less than 6%.
3. The minimum 28 day compressive strength of concrete street paving shall not be less than 3600 psi and shall be air entrained. Water may not be applied to the surface of concrete paving to improve workability.

DRAINAGE

1. Storm sewer pipe shall be reinforced concrete, Class III unless otherwise noted.
2. All structural concrete shall be Class "C" (3600 psi compressive strength at 28 days), air entrained.
3. The contractor shall install plugs in storm sewer lines or otherwise prevent mud from entering the storm sewer system during construction.

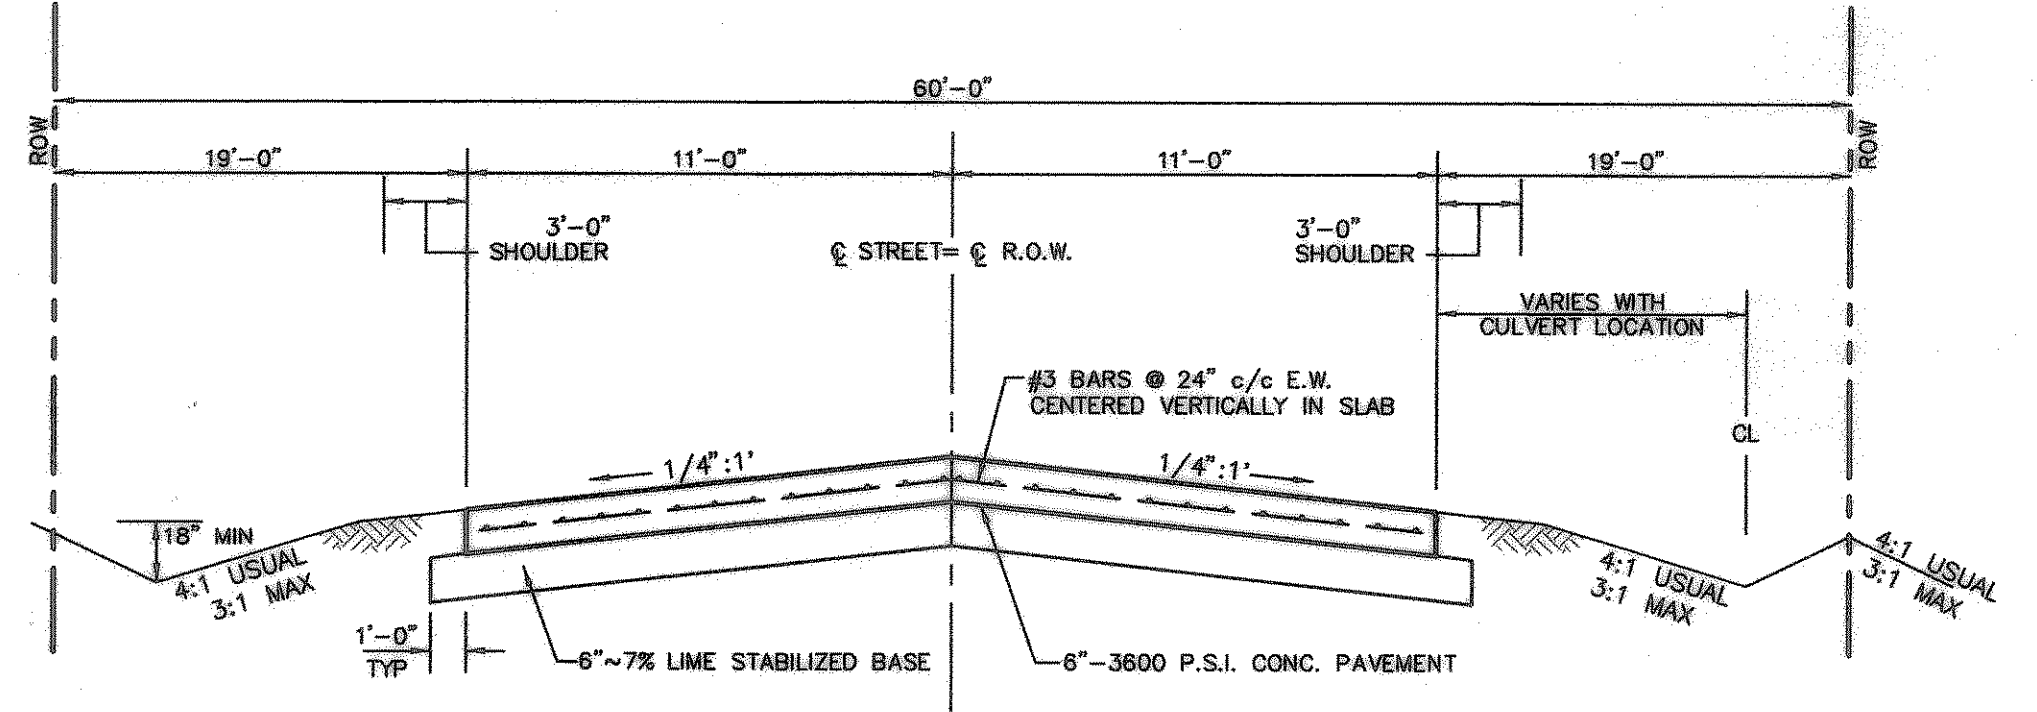

TYPICAL STREET SECTION
NTS

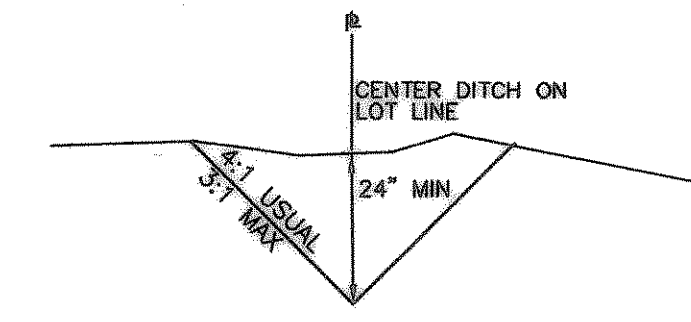

GRADE TO DRAIN TYPICAL SECTION
NTS

BENCHMARK: TOP OF 1/2" IRON ROD, SAID ROD BEING THE NORTHWEST PROPERTY CORNER. ROD IS LOCATED ON THE WEST SIDE OF WALLACE LANE.
ASSUMED PLAN ELEV. = 99.21
ACTUAL ELEV. = 561.62

21+00 22+00 23+00 24+00



F:\InActive\96149 - JONES The Oaks\6149PAV.DWG Mon Jan 12 10:19:17 2004 ALEX C.