



BENCHMARK: TOP OF 1/2" IRON ROD, SAID ROD
 BEING THE NORTHWEST PROPERTY
 CORNER. ROD IS LOCATED ON
 THE WEST SIDE OF WALLACE LANE.
 ASSUMED PLAN ELEV. = 99.21
 ACTUAL ELEV. = 561.62
 NOTE: FOR TYPICAL PAVING SECTION AND
 PAVING/DRAINAGE GENERAL NOTES
 SEE SHEET 12.

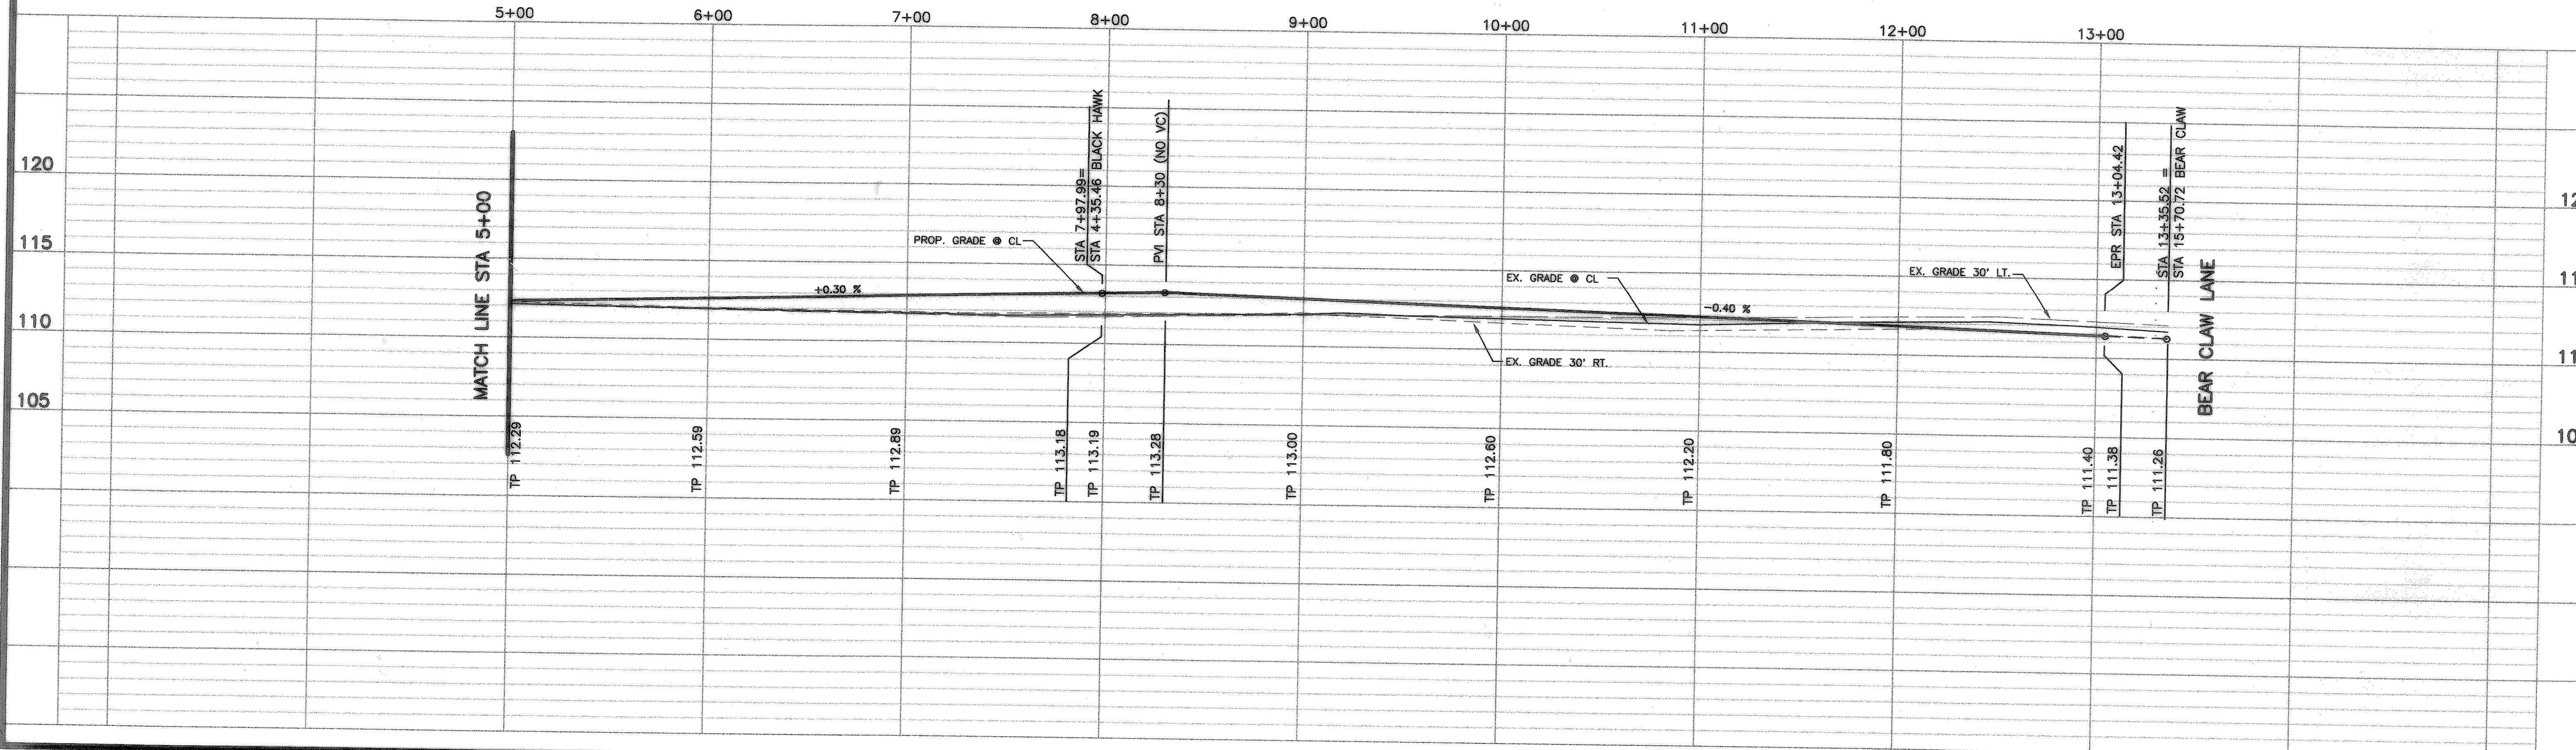

FREEMAN - MILLICAN, Inc.
 CONSULTING ENGINEERS
 3200 BROADWAY BLVD., SUITE 272
 GARLAND, TEXAS 75043
 (214) 276-2850

No.	Date	Revision	By

THE OAKS OF BUFFALO WAY
 OWNER: OAKS OF BUFFALO WAY, L.L.C.
PAVING PLAN
 STANDING OAK STA 5+00 - STA 13+35

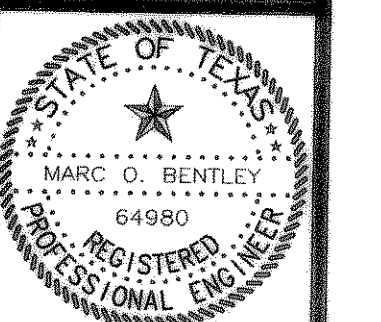

THE SEAL APPEARING ON THIS
 DOCUMENT WAS AUTHORIZED BY
 MARC O. BENTLEY, P.E.
 NO. 64980 ON 1/10/97
 Scale: 1" = 40' H
 1" = 5' V
 Date: NOV. 1996
 Project No.: 96149
 Designed: FMI
 Drawn: FMI
 Checked: MOB

F:\Inactive\96149 - JONES The Oaks\649PAV.DWG Mon Jan 12 16:48:18 2004 ALEX C.