
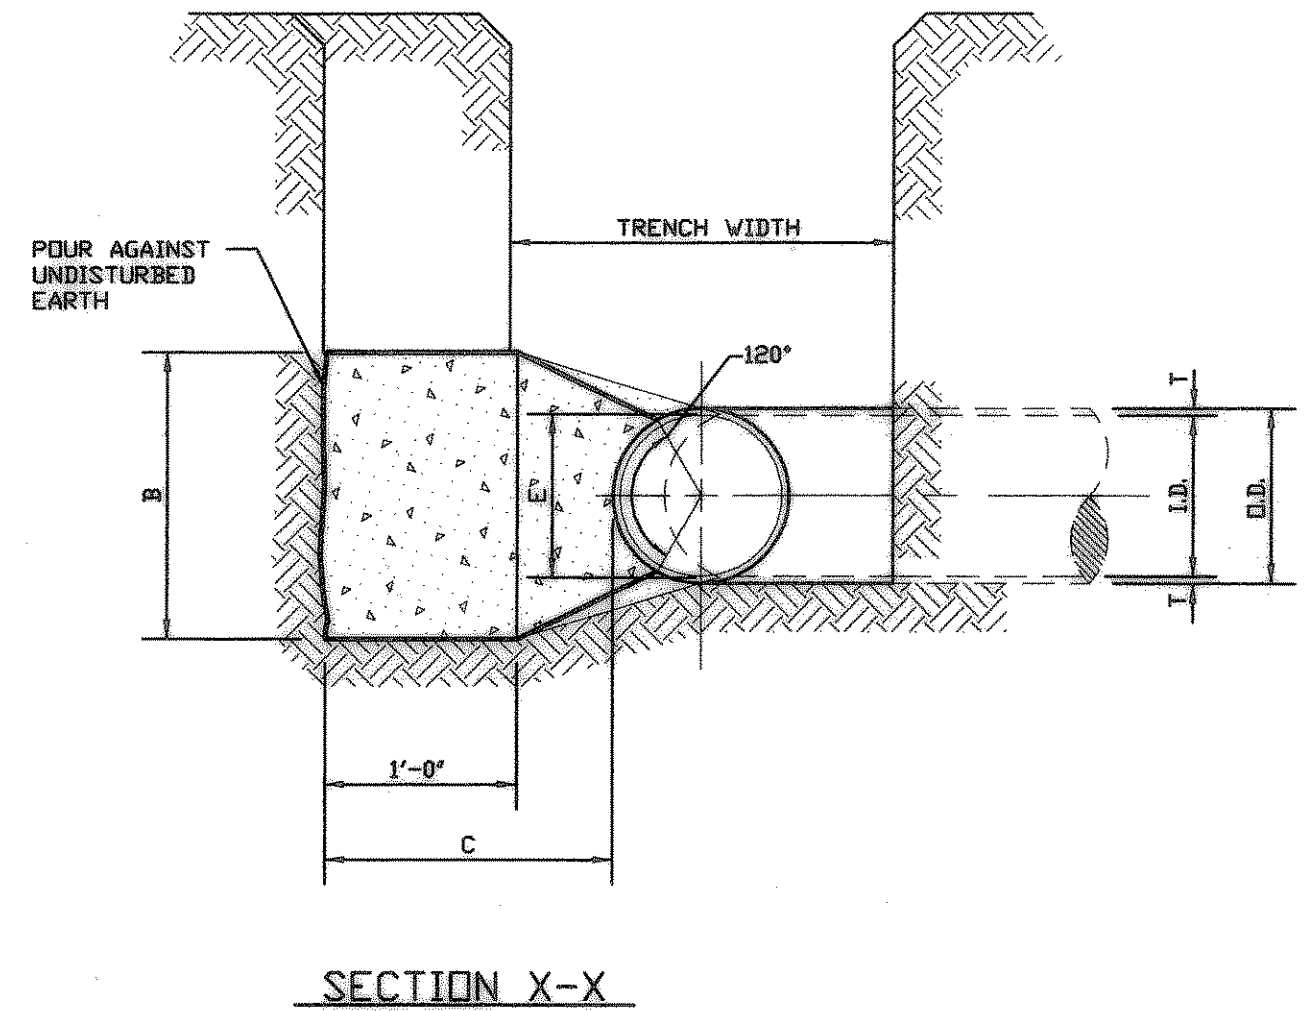


HORIZONTAL BENDS

I.D. In.	T Thrust tons	$\Delta = 1125^\circ$			$\Delta = 2250^\circ$			$\Delta = 30^\circ$			$\Delta = 45^\circ$			$\Delta = 67.50^\circ$			$\Delta = 90^\circ$											
		A Ft.	B Ft.	VOLUME c.y.	A Ft.	B Ft.	VOLUME c.y.	A Ft.	B Ft.	VOLUME c.y.	A Ft.	B Ft.	VOLUME c.y.	A Ft.	B Ft.	VOLUME c.y.	A Ft.	B Ft.	VOLUME c.y.									
4.6,8	0.4	1.5	1.5	0.9	4.6,8	0.4	1.0	1.0	1.0	1.0	1.0	1.0	1.5	1.5	0.1	4.6,8	2.1	5.6	3.0	2.0	0.3	2.0	1.5	0.4	2.0	2.0	0.2	
10.12	0.5	1.5	1.5	1.2	10.12	0.6	2.2	1.5	1.5	0.1	10.12	1.1	4.4	2.0	2.5	0.3	1.5	1.5	0.1	10.12	1.5	5.9	2.5	2.5	0.3	2.0	1.5	0.2
16.18	0.6	1.5	1.5	1.6	16.18	0.8	5.0	2.0	2.5	0.3	1.5	2.0	0.2	16.18	2.2	13.2	3.5	4.0	0.8	2.5	3.0	0.4	16.18	3.2	19.5	4.5	4.5	1.2
20	0.7	1.5	1.5	1.8	20	0.9	6.2	2.0	3.5	0.4	1.5	3.0	0.3	20	1.8	12.3	3.5	3.5	0.7	2.0	3.5	0.4	20	2.4	16.3	4.5	4.0	1.0
24	0.9	1.5	1.5	2.1	24	1.1	8.9	3.0	3.0	0.5	1.5	3.0	0.3	24	2.2	17.7	4.0	4.5	1.0	3.0	3.0	0.5	24	2.9	23.4	6.0	4.0	1.4
30	2.9	1.5	1.9	2.6	30	1.4	10.4	3.0	3.5	0.6	2.0	3.5	0.4	30	2.7	20.7	5.0	4.5	1.5	3.0	4.0	0.8	30	3.6	27.5	5.5	5.0	1.9
36	4.5	1.5	2.3	3.3	36	1.7	15.0	3.5	4.5	0.9	2.0	4.0	0.5	36	3.3	29.8	5.5	5.5	2.3	4.0	4.0	1.3	36	4.4	39.5	7.0	6.0	3.4
42	5.0	1.8	2.6	3.8	42	1.9	20.4	4.5	5.0	1.5	2.5	5.0	0.8	42	3.8	40.5	7.0	6.0	3.9	4.5	5.0	2.1	42	5.1	53.8	8.0	7.0	5.1
48	5.5	2.0	3.0	4.3	48	2.2	26.6	4.5	6.0	2.0	2.5	6.0	1.1	48	4.4	52.9	8.0	7.0	5.7	4.5	6.0	2.8	48	5.8	70.3	9.0	8.0	7.4
54	6.0	2.3	3.4	4.8	54	2.5	33.7	6.0	6.0	3.0	3.0	6.0	1.4	54	4.9	67.0	9.0	8.0	8.0	6.0	6.0	4.1	54	6.5	89.0	10.0	9.0	10.3
60	6.5	2.5	3.8	5.3	60	2.7	41.6	6.0	7.0	3.8	3.0	7.0	1.8	60	5.5	82.7	9.5	9.0	10.6	6.0	7.0	5.3	60	7.3	110.0	11.0	10.0	13.9
66	6.8	2.8	4.1	5.7	66	3.0	50.3	6.5	8.0	5.1	3.5	8.0	2.7	66	6.0	100.1	10.5	10.0	14.1	6.5	8.0	7.2	66	8.0	132.9	12.5	11.0	18.9
72	7.5	3.0	4.5	6.3	72	3.3	59.9	7.5	8.0	6.3	4.0	8.0	3.3	72	6.6	119.1	11.0	11.0	17.6	7.5	8.0	9.1	72	8.7	158.2	13.5	12.0	24.0
78	7.5	3.3	4.9	6.7	78	3.6	70.2	8.0	9.0	8.1	4.0	9.0	3.9	78	7.1	139.8	12.0	12.0	22.5	8.0	9.0	11.7	78	9.4	185.6	14.5	13.0	30.0
84	8.0	3.5	5.3	7.2	84	3.8	81.5	9.5	10.0	10.3	4.5	10.0	5.3	84	7.6	162.1	13.0	12.5	27.2	8.5	10.0	14.8	84	10.1	215.3	15.5	14.0	37.1
90	8.5	3.8	5.6	7.7	90	4.1	93.5	9.5	10.0	12.2	5.0	10.0	6.3	90	8.2	186.1	14.0	13.5	33.7	9.5	10.0	17.7	90	10.9	247.1	16.5	15.0	45.0
96	9.0	4.0	6.0	8.2	96	4.4	106.4	10.0	11.0	15.0	5.0	11.0	7.4	96	8.7	211.7	15.0	14.5	41.2	10.0	11.0	21.8	96	11.6	281.2	18.0	16.0	55.5

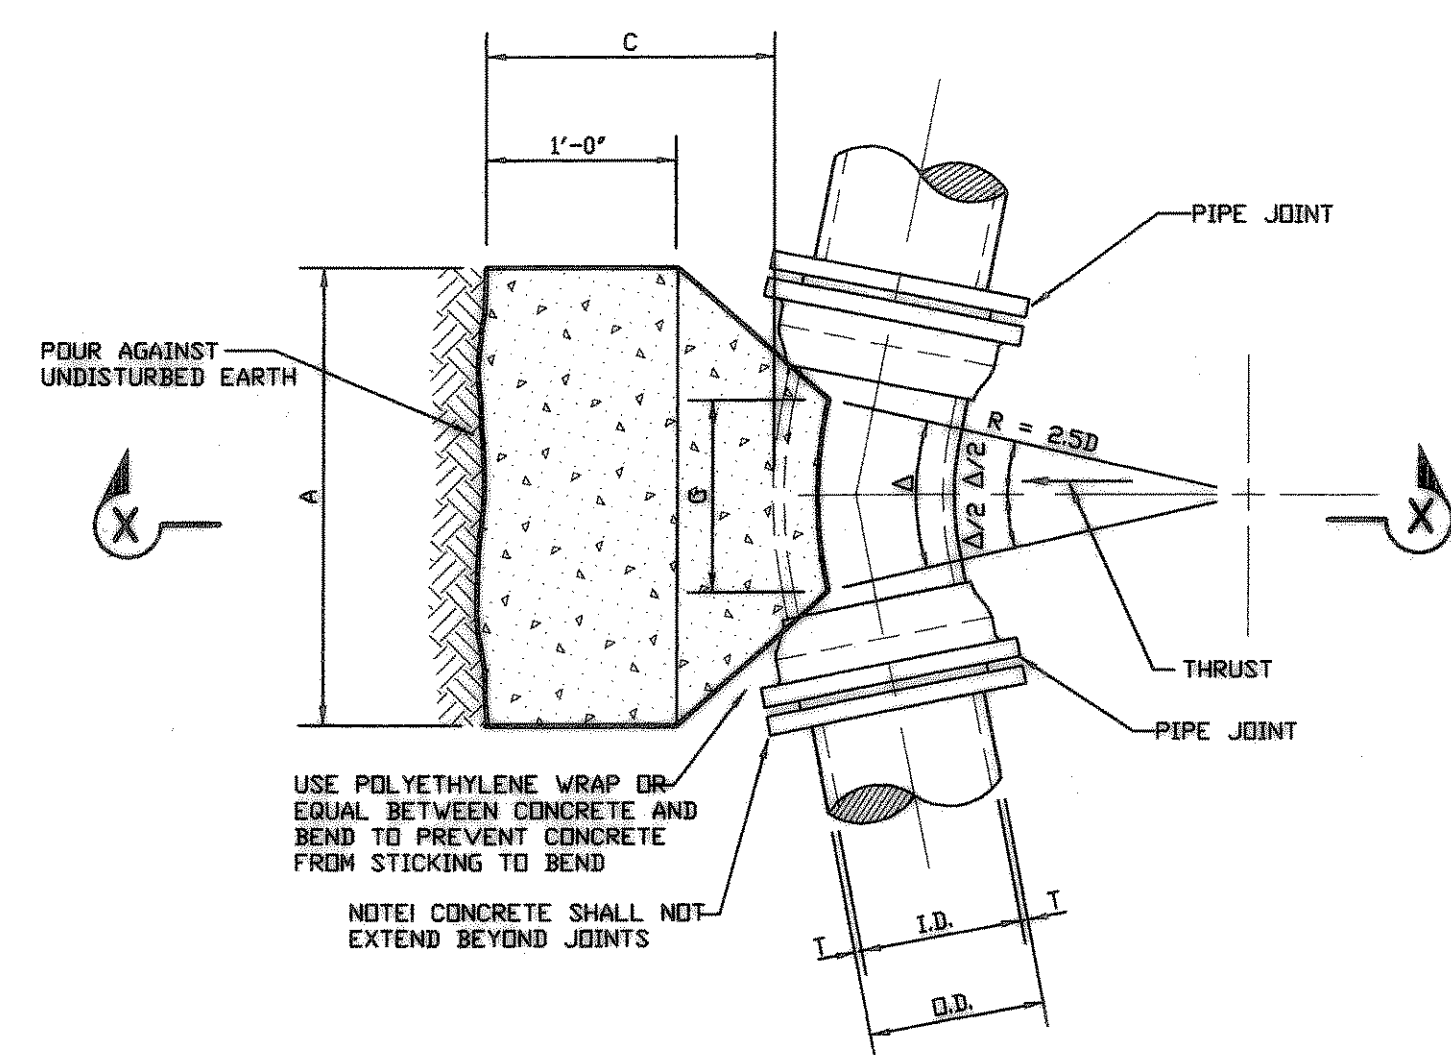


TYPICAL HORIZONTAL THRUST BLOCK


- GENERAL NOTES**
- ALL CALCULATIONS ARE BASED ON INTERNAL PRESSURE OF 200 p.s.i. FOR 24" I.D. PIPE AND SMALLER, AND 150 p.s.i. ON 30" I.D. AND LARGER.
 - VOLUMES OF VERTICAL BEND THRUST BLOCKS ARE NET VOLUMES OF CONCRETE TO BE FURNISHED. THE CORRESPONDING WEIGHT OF THE CONCRETE (4,000 lb/c.y.) IS EQUAL TO OR GREATER THAN THE VERTICAL BEND.
 - ALL BEARING SURFACES OF THRUST BLOCKS SHALL BE POURED AGAINST UNDISTURBED EARTH OR ROCK.
 - WALL THICKNESS (T) ASSUMED HERE FOR ESTIMATING PURPOSES ONLY.
 - CONCRETE FOR BLOCKING SHALL BE 2,000 p.s.i. CONCRETE.
 - DIMENSIONS MAY BE VARIED AS REQUIRED BY FIELD CONDITIONS WHERE AND AS DIRECTED BY THE ENGINEER. THE VOLUME OF CONCRETE BLOCKING SHALL NOT BE LESS THAN SHOWN HERE.

TEES & PLUGS

I.D. In.	THRUST tons	C Ft.	EARTH		ROCK	
			A Ft.	VOLUME c.y.	A Ft.	VOLUME c.y.
4.6,8	5.1	1.5	2.5	0.3	2.0	0.2
10.12	11.3	1.5	3.5	0.6	2.5	0.3
16.18	25.5	2.0	5.5	1.6	4.0	0.9
20	31.5	2.0	6.0	1.9	4.0	0.9
24	45.2	2.5	7.0	3.1	5.0	1.7
30	53.0	3.0	7.5	4.1	5.5	2.4
36	76.3	4.0	9.0	7.3	6.5	4.2
42	104.0	4.5	10.5	11.0	7.5	5.2
48	136.0	5.0	12.0	15.6	8.5	8.7
54	172.0	5.5	13.5	21.4	9.5	11.9
60	212.0	6.0	15.0	28.4	10.5	15.7
66	257.0	6.5	16.5	36.8	11.5	20.5
72	305.0	7.5	17.5	47.2	12.5	27.2
78	358.0	8.0	19.0	58.9	13.5	33.7
84	416.0	8.5	20.5	72.3	14.5	41.2
90	477.0	9.0	22.0	87.7	15.5	49.7
96	543.0	9.5	23.5	104.8	16.5	61.0

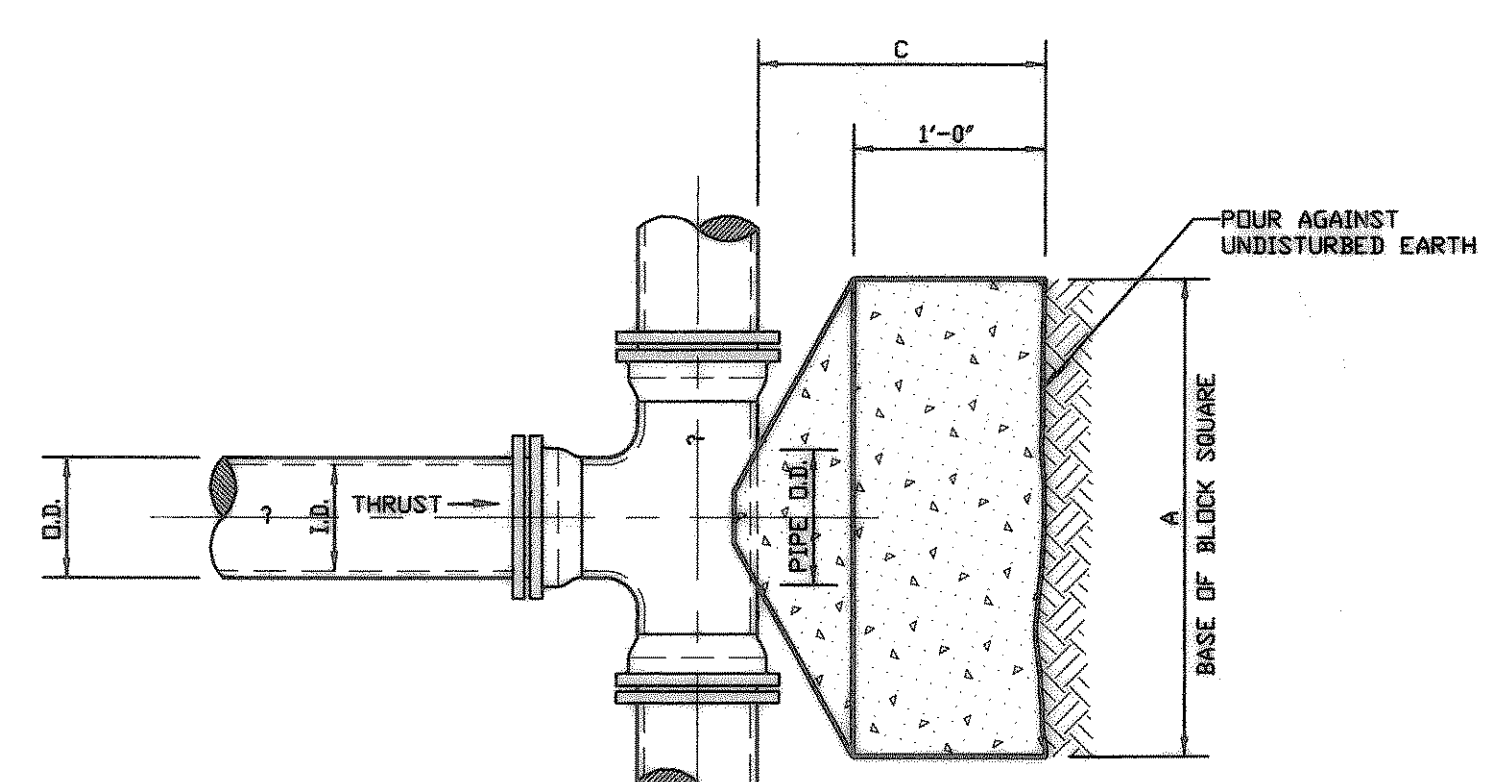


PLAN OF TEE THRUST BLOCK

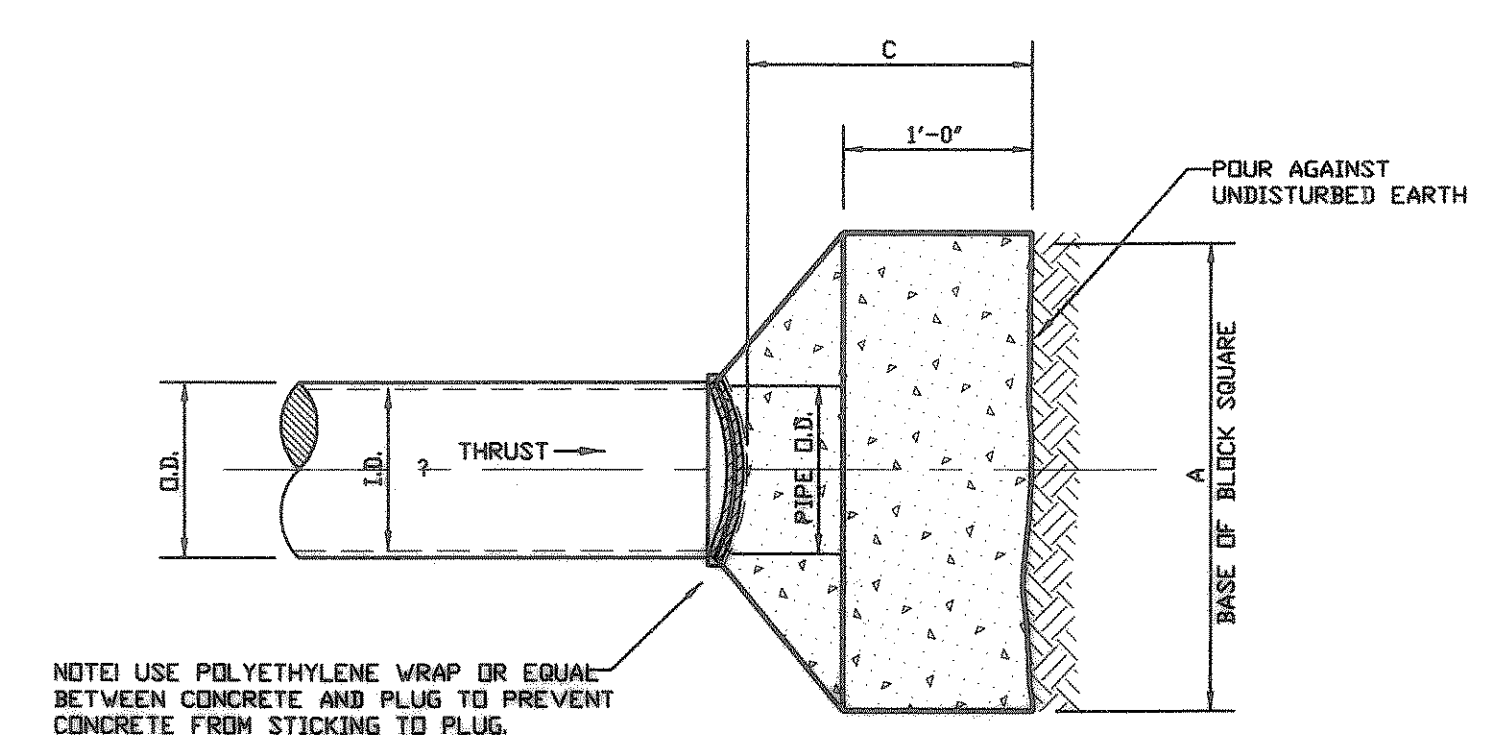


PLAN OF PLUG THRUST BLOCK

VERTICAL BENDS

I.D. In.	$\Delta = 1125^\circ$		$\Delta = 2250^\circ$		$\Delta = 30^\circ$		$\Delta = 45^\circ$		$\Delta = 67.50^\circ$		$\Delta = 90^\circ$	
	THRUST tons	VOLUME c.y.	THRUST tons	VOLUME c.y.	THRUST tons	VOLUME c.y.	THRUST tons	VOLUME c.y.	THRUST tons	VOLUME c.y.	THRUST tons	VOLUME c.y.
4.6,8	1.0	0.5	2.0	1.0	2.5	1.3	3.6	1.8	4.6	2.3	5.0	2.5
10.12	2.2	1.1	4.3	2.2	5.7	2.8	8.0	4.0	10.5	5.2	11.3	5.7
16.18	5.0	2.5	9.7	4.9	12.7	6.4	18.0	9.0	23.5	11.8	25.5	12.7
20	6.1	3.1	12.0	6.0	15.7	7.9	22.2	11.1	29.2	14.5	31.4	15.7
24	8.2	4.4	17.3	8.7	22.6	11.3	32.0	16.0	41.8	20.9	45.2	22.6
30	10.5	5.2	23.3	10.1	26.5	13.3	37.5	18.8	49.0	24.5	53.1	26.5
36	14.9	7.5	29.2	14.6	38.2	19.1	54.0	27.0	70.5	35.3	76.4	38.2
42	20.3	10.1	39.8	19.9	52.0	26.0	73.5	36.7	96.0	48.0	104.0	52.0
48	26.5	13.2	51.9	26.0	67.9	33.9	96.0	48.0	126.0	62.7	136.0	67.9
54	33.5	16.8	65.7	32.9	85.9	42.9	122.0	60.7	159.0	79.4	172.0	85.9
60	41.4	20.7	81.2	40.6	106.0	53.0	150.0	75.0	196.0	98.0	212.0	106.0
66	50.1	25.0	98.2	49.1	128.0	64.2	182.0	90.7	237.0	119.0	257.0	128.0
72	59.6	29.8	117.0	58.4	153.0	76.3	216.0	108.0	282.0	141.0	305.0	153.0
78	69.9	35.0	137.0	68.6	179.0	90.0	254.0	127.0	331.0	166.0	358.0	179.0
84	81.1	40.5	159.0	79.5	208.0	104.0	294.0	147.0	384.0	192.0	416.0	208.0
90	93.1	46.5	183.0	91.3	239.0	119.0	337.0	169.0	441.0	221.0	477.0	239.0
96	106.0	53.0	208.0	104.0	272.0	136.0	384.0	192.0	502.0	251.0	543.0	272.0

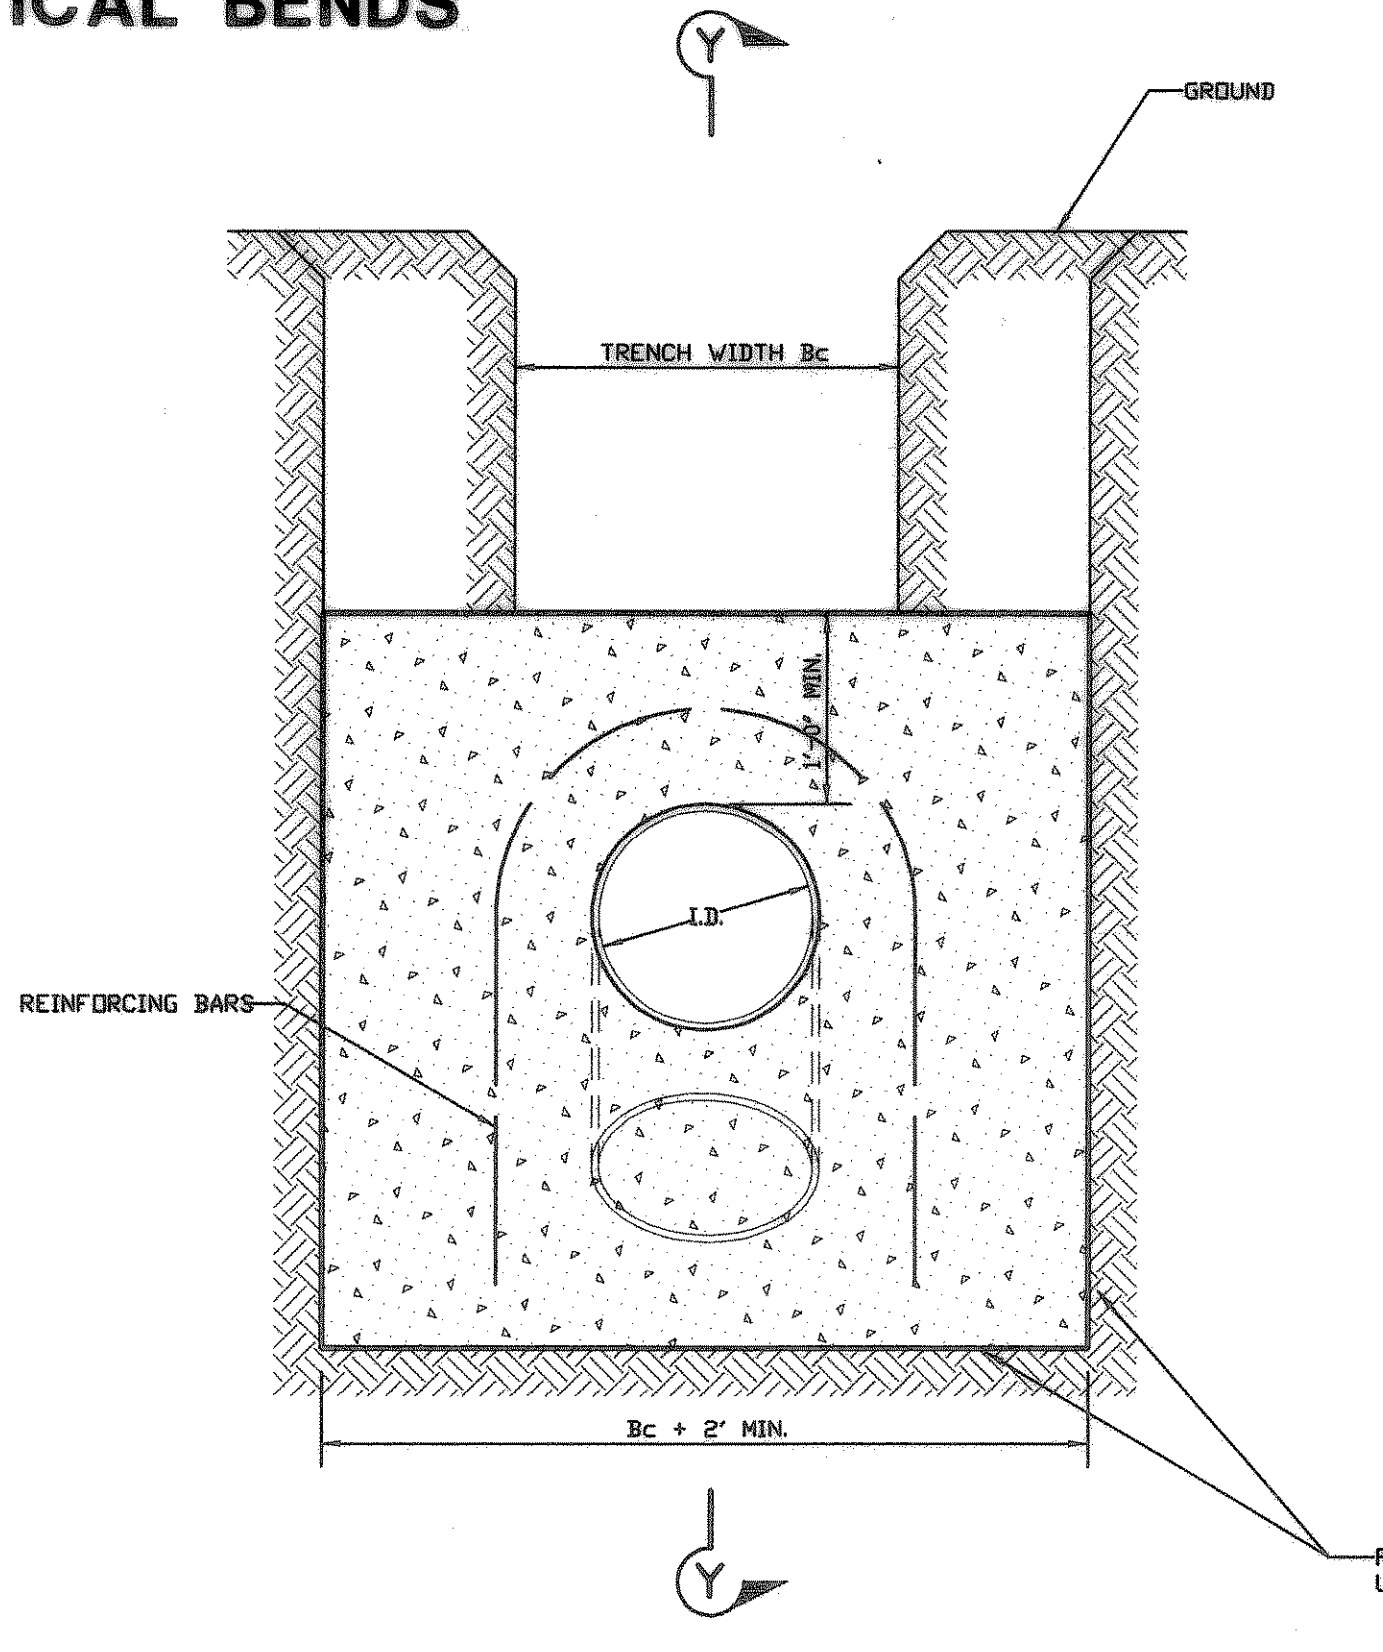

SECTION W-W

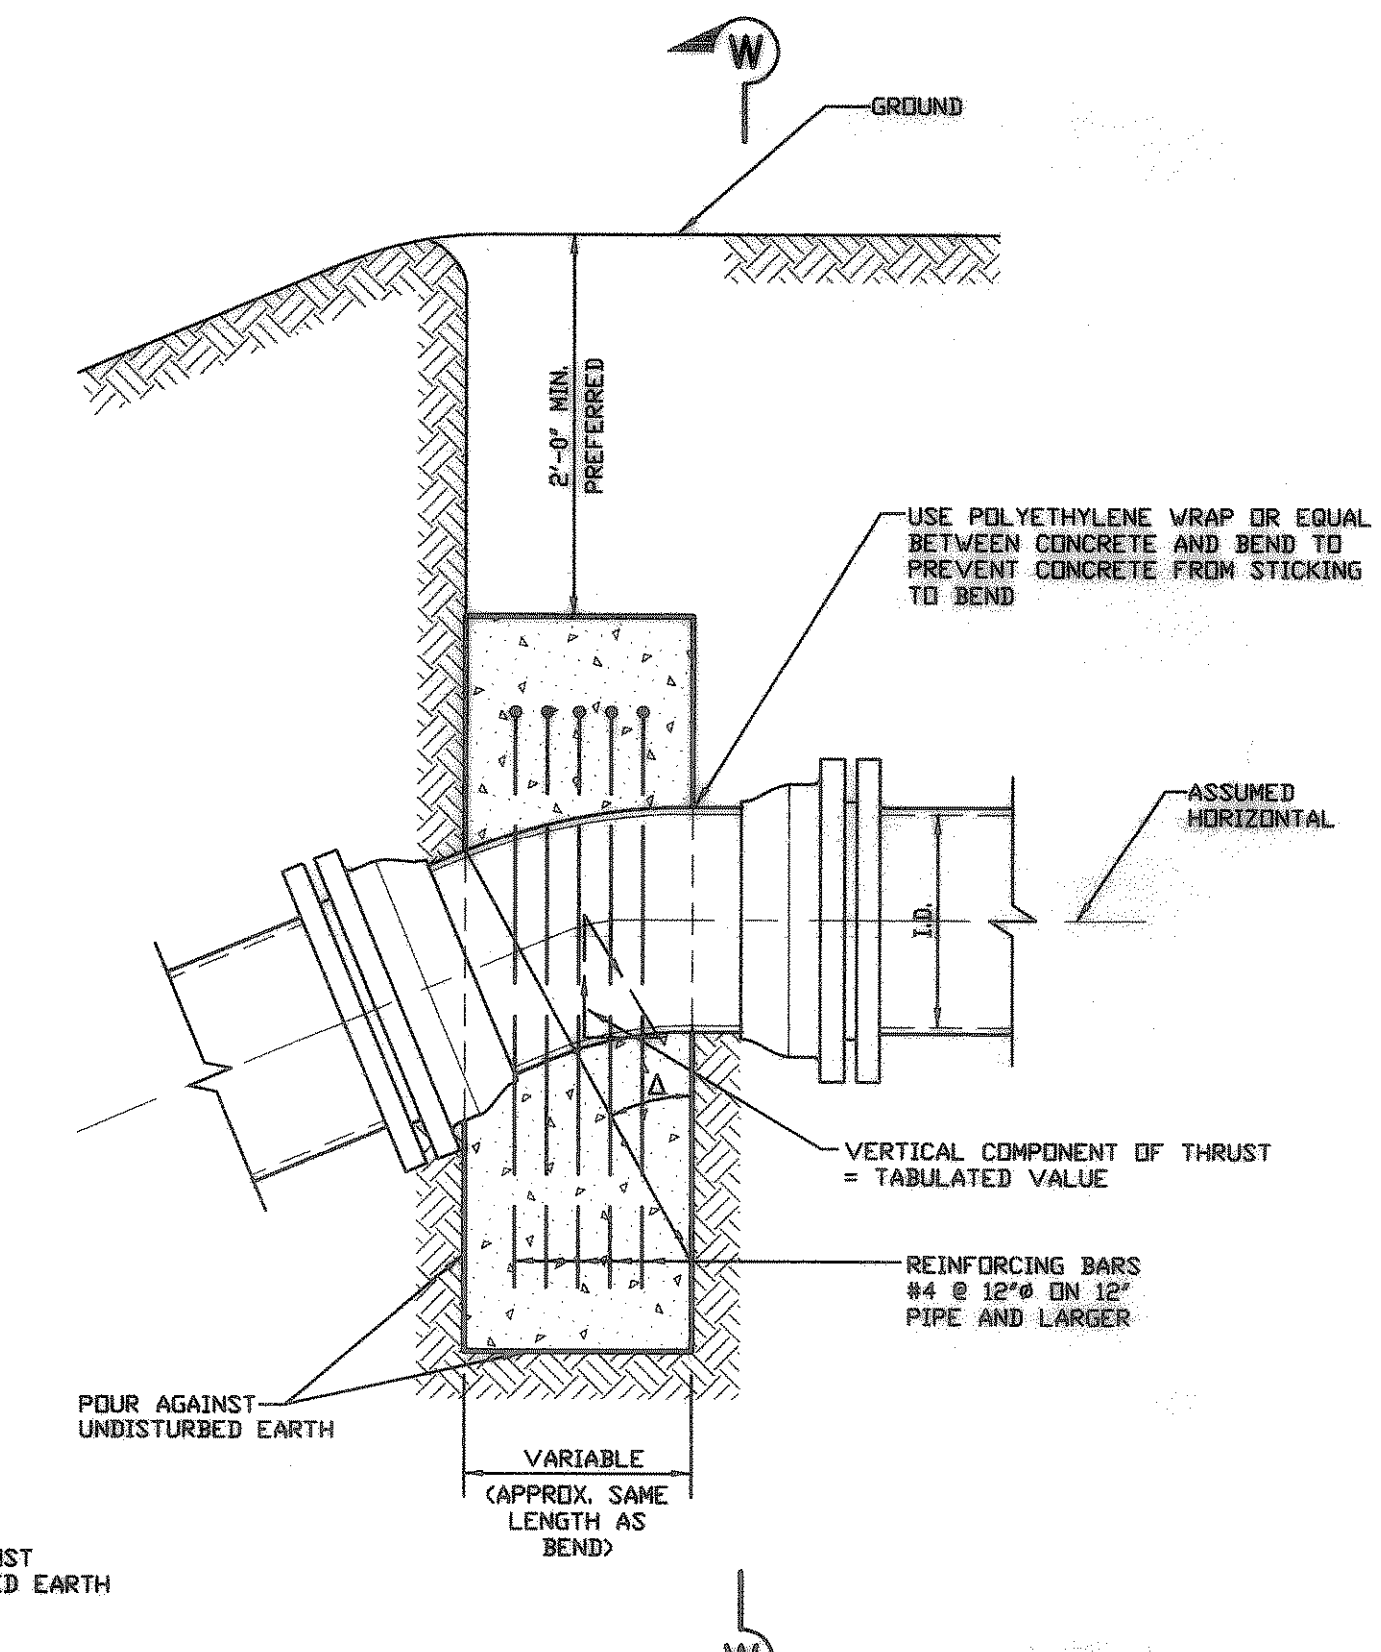

SECTION Y-Y

TYPICAL VERTICAL BEND THRUST BLOCK

FREEMAN - MILLICAN, Inc.
CONSULTING ENGINEERS
3200 BROADWAY BLVD., SUITE 272
GARLAND, TEXAS 75043
(214) 278-2850

THE OAKS OF BUFFALO WAY
OWNER: OAKS OF BUFFALO WAY, L.L.C.
THRUST BLOCKING

Scale: NTS
Date: NOV. 1996
Project: No86149
Designed: FMI
Drawn: FMI
Checked: HDB
SHEET
19
20