


BENCH MARK:
RR SPINE IN RR AT
NORTH CORNER OF PROPERTY
Elev. 560.72

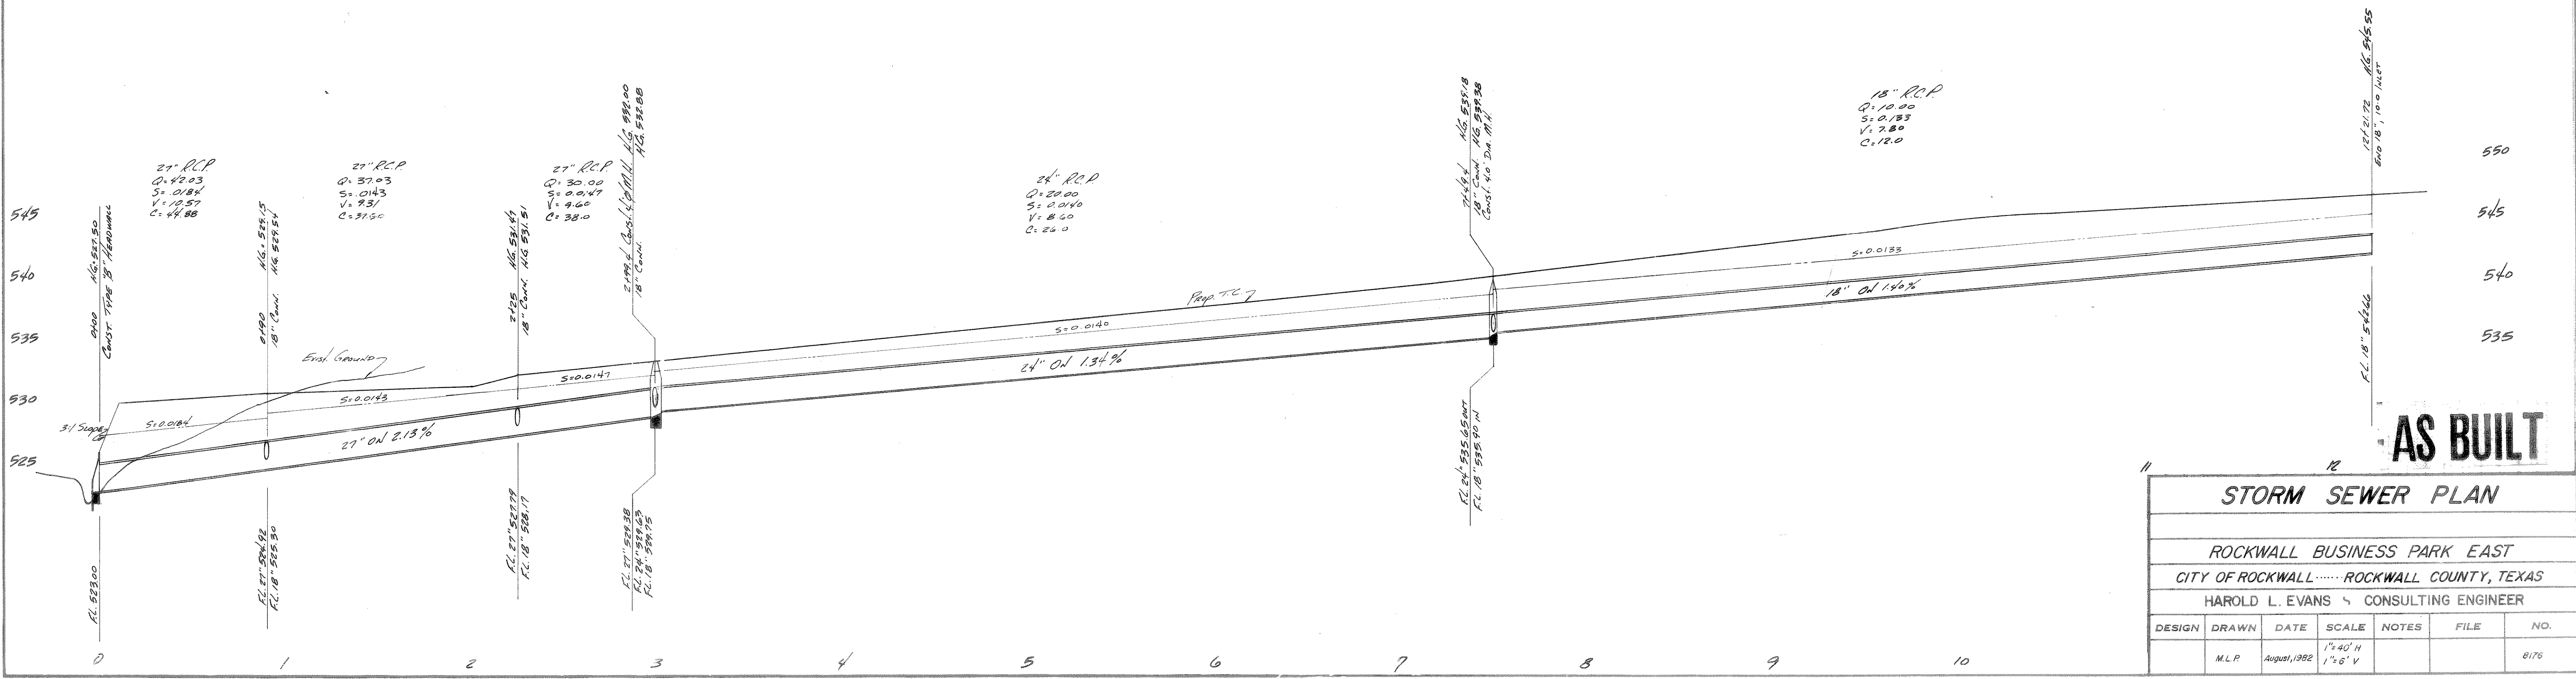

AS BUILT

STORM SEWER PLAN						
ROCKWALL BUSINESS PARK EAST						
CITY OF ROCKWALL ····· ROCKWALL COUNTY, TEXAS						
HAROLD L. EVANS · CONSULTING ENGINEER						
DESIGN	DRAWN	DATE	SCALE	NOTES	FILE	NO.
	M.L.P.	August, 1982	1"=40' H 1"=6' V			8176