

Drawing name: K:\SNA\_CAD\DWG\PROJ\04\02\EROSION\CC-105.dwg (2.2) EROSION CONTROL DETAILS Mar 29, 2012 2:29pm by: jmk/bk/bk  
 THIS DOCUMENT, TOGETHER WITH THE CONCEPTS AND DESIGN PRESENTED HEREIN, IS AN INSTRUMENT OF SERVICE, IS INTENDED ONLY FOR THE SPECIFIC PURPOSE AND CLIENT FOR WHICH IT WAS PREPARED, REUSE OF AND IMPROPER RELIANCE ON THIS DOCUMENT WITHOUT WRITTEN AUTHORIZATION AND ADAPTATION BY KIMLEY-HORN AND ASSOCIATES, INC. SHALL BE WITHOUT LIABILITY TO KIMLEY-HORN AND ASSOCIATES, INC.

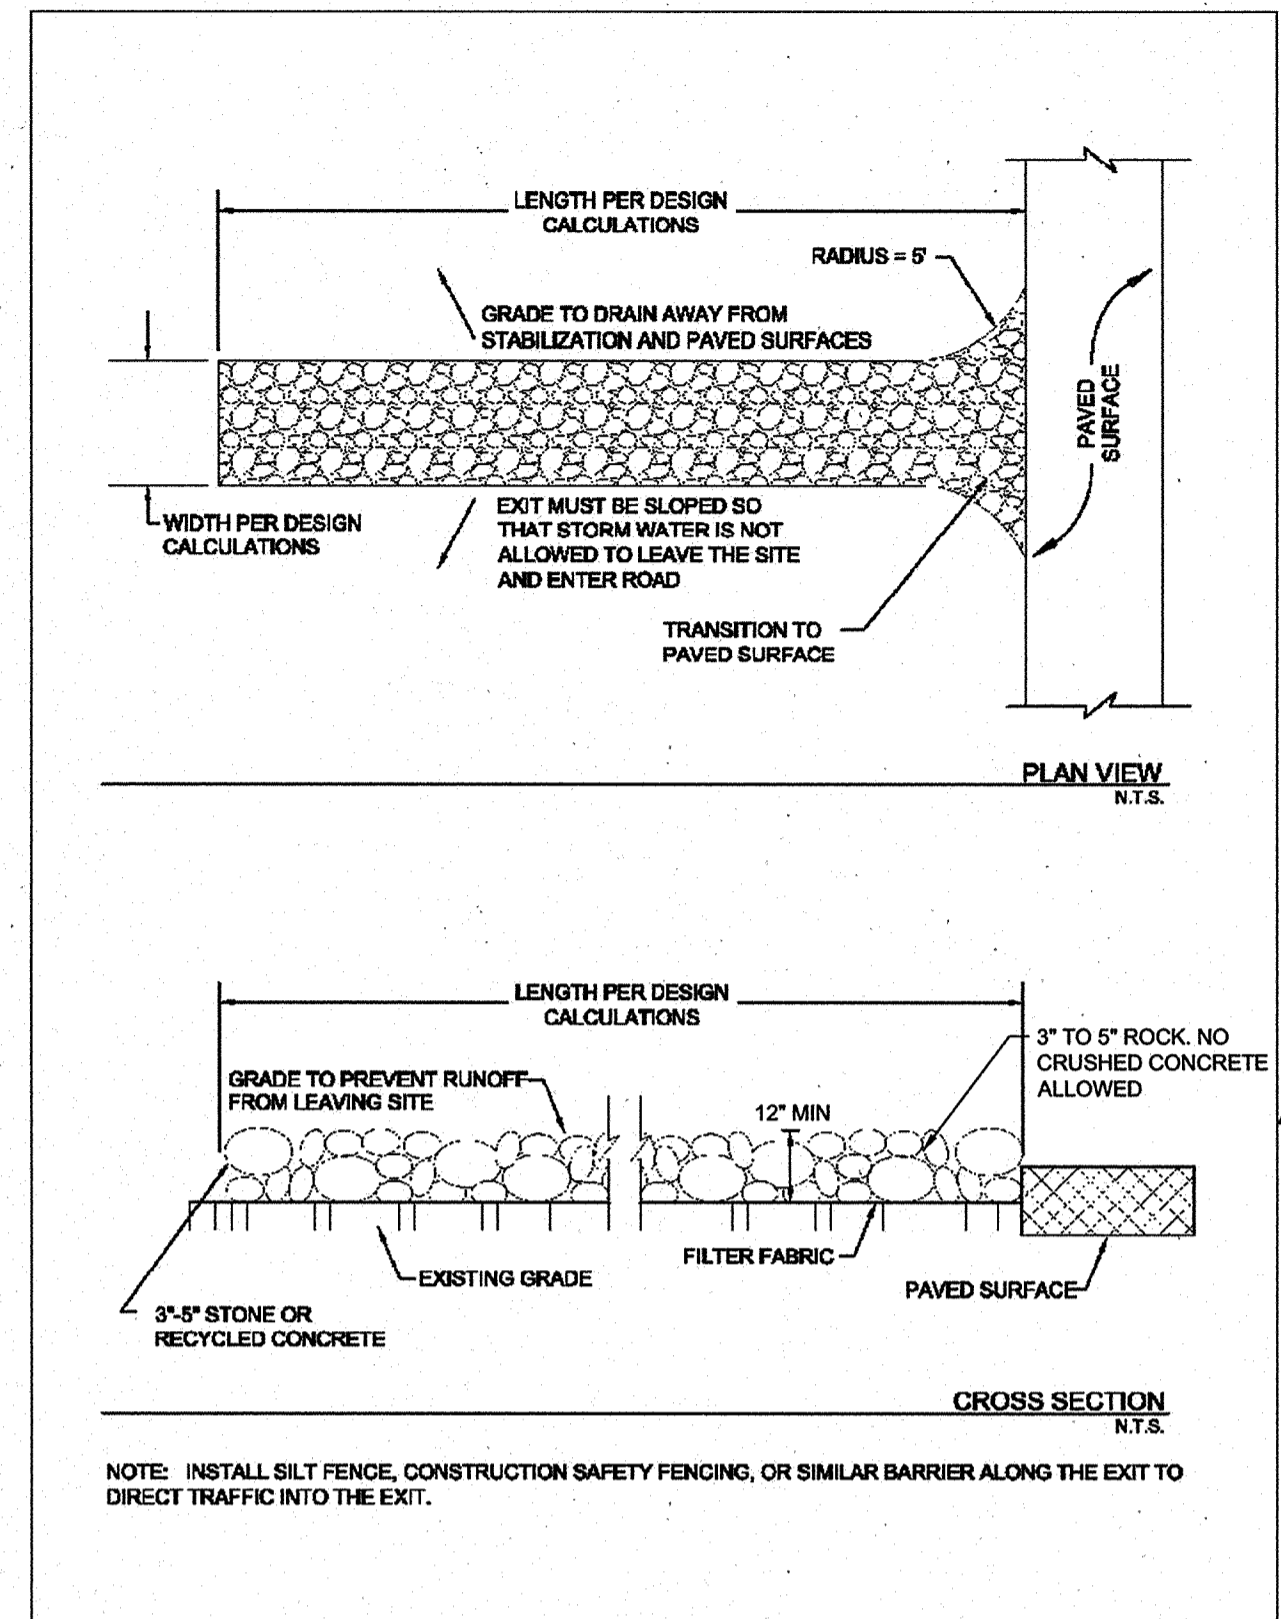


Figure 3.29 Schematics of Stabilized Construction Exit

Stabilized Construction Exit Revised 04/10 CC-151

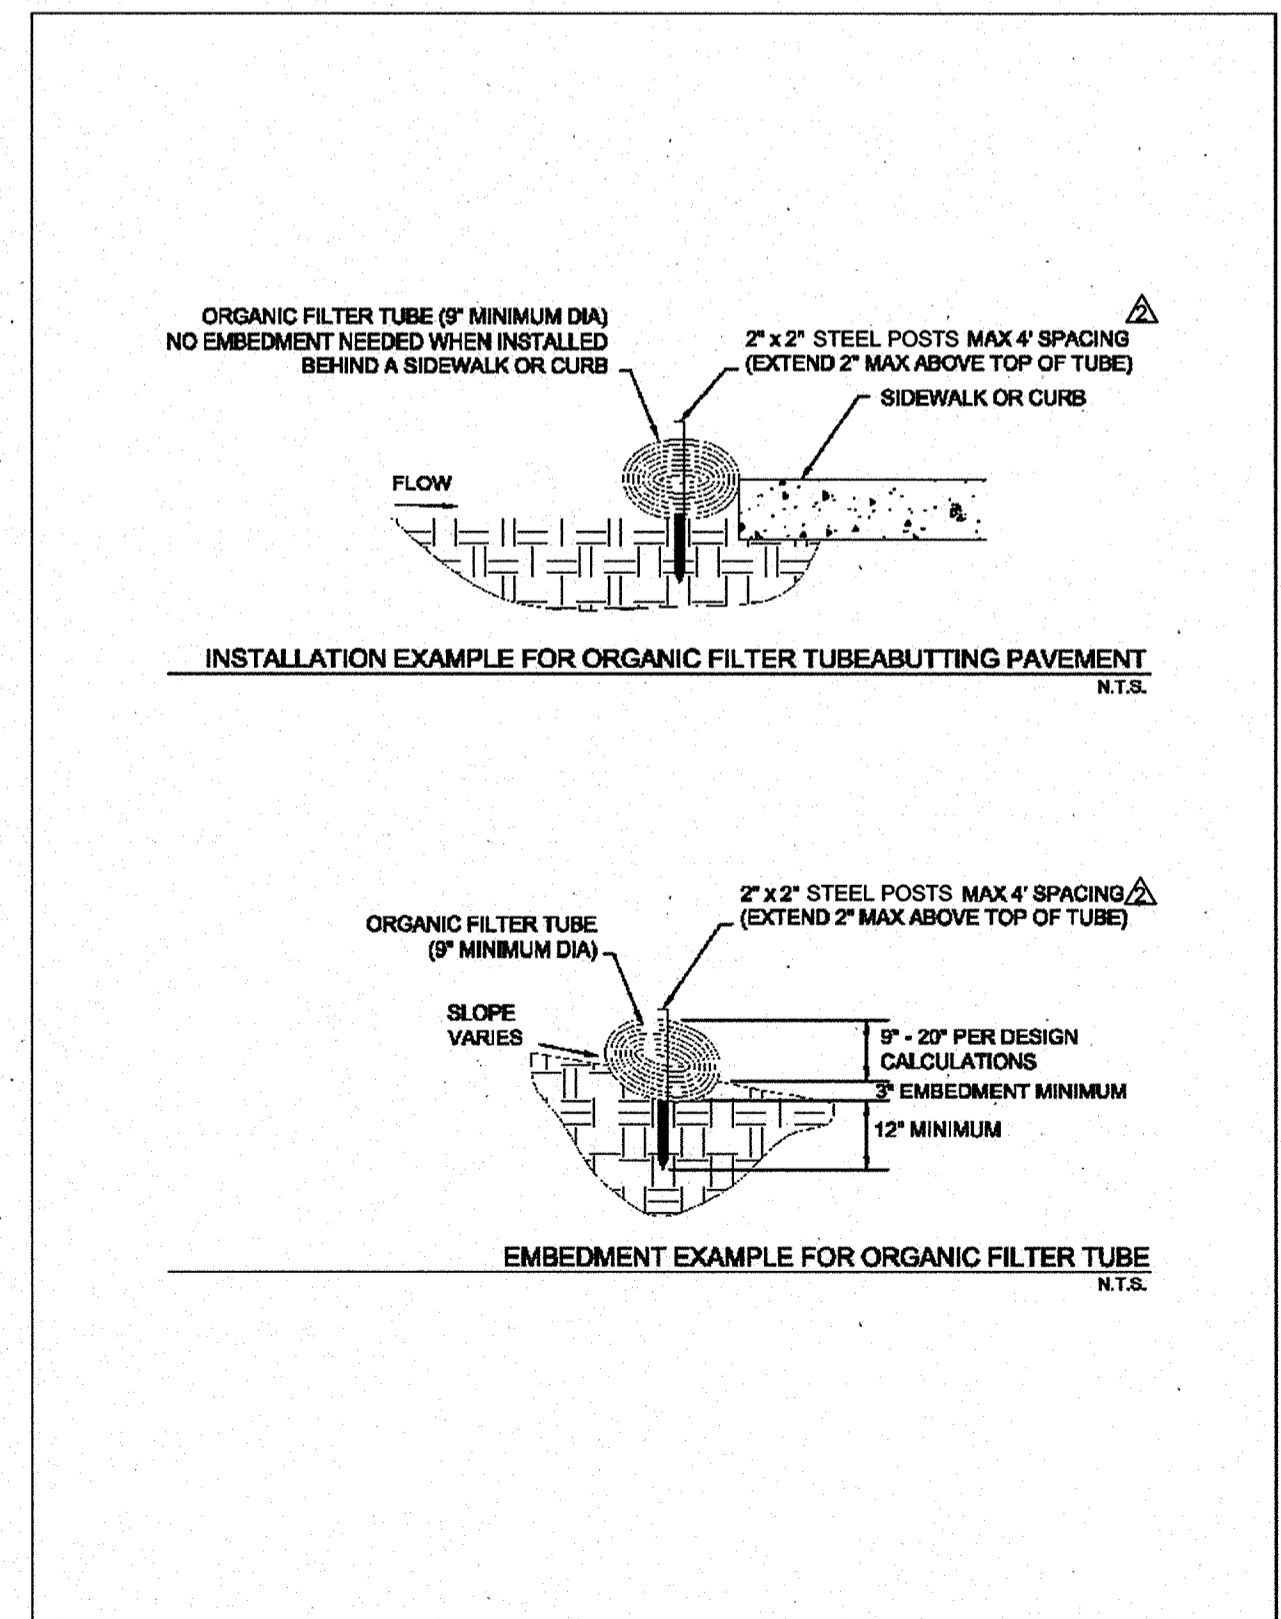


Figure 3.16 Examples of Organic Filter Tube Installation Methods

Organic Filter Tubes Revised 04/10 CC-105

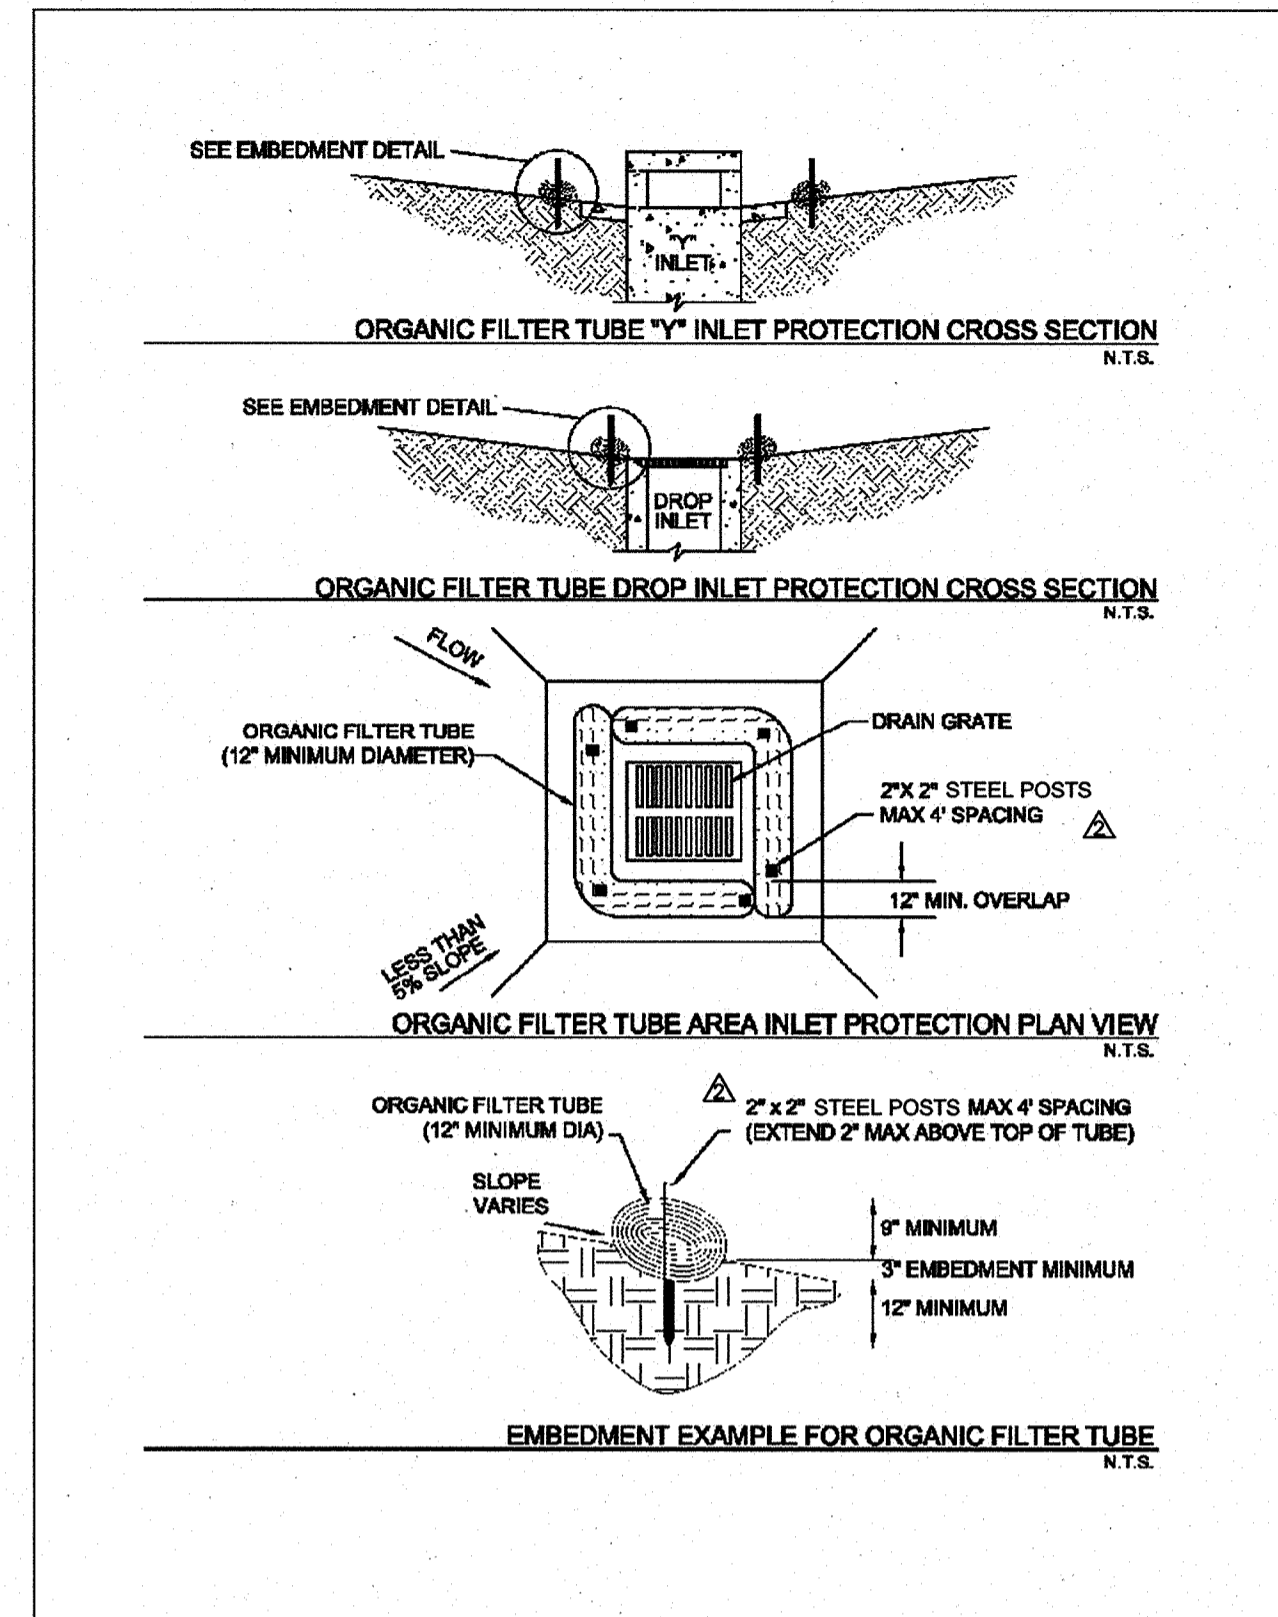


Figure 3.13 Schematics of Organic Filter Tube Area Inlet Protection

Inlet Protection Revised 04/10 CC-95


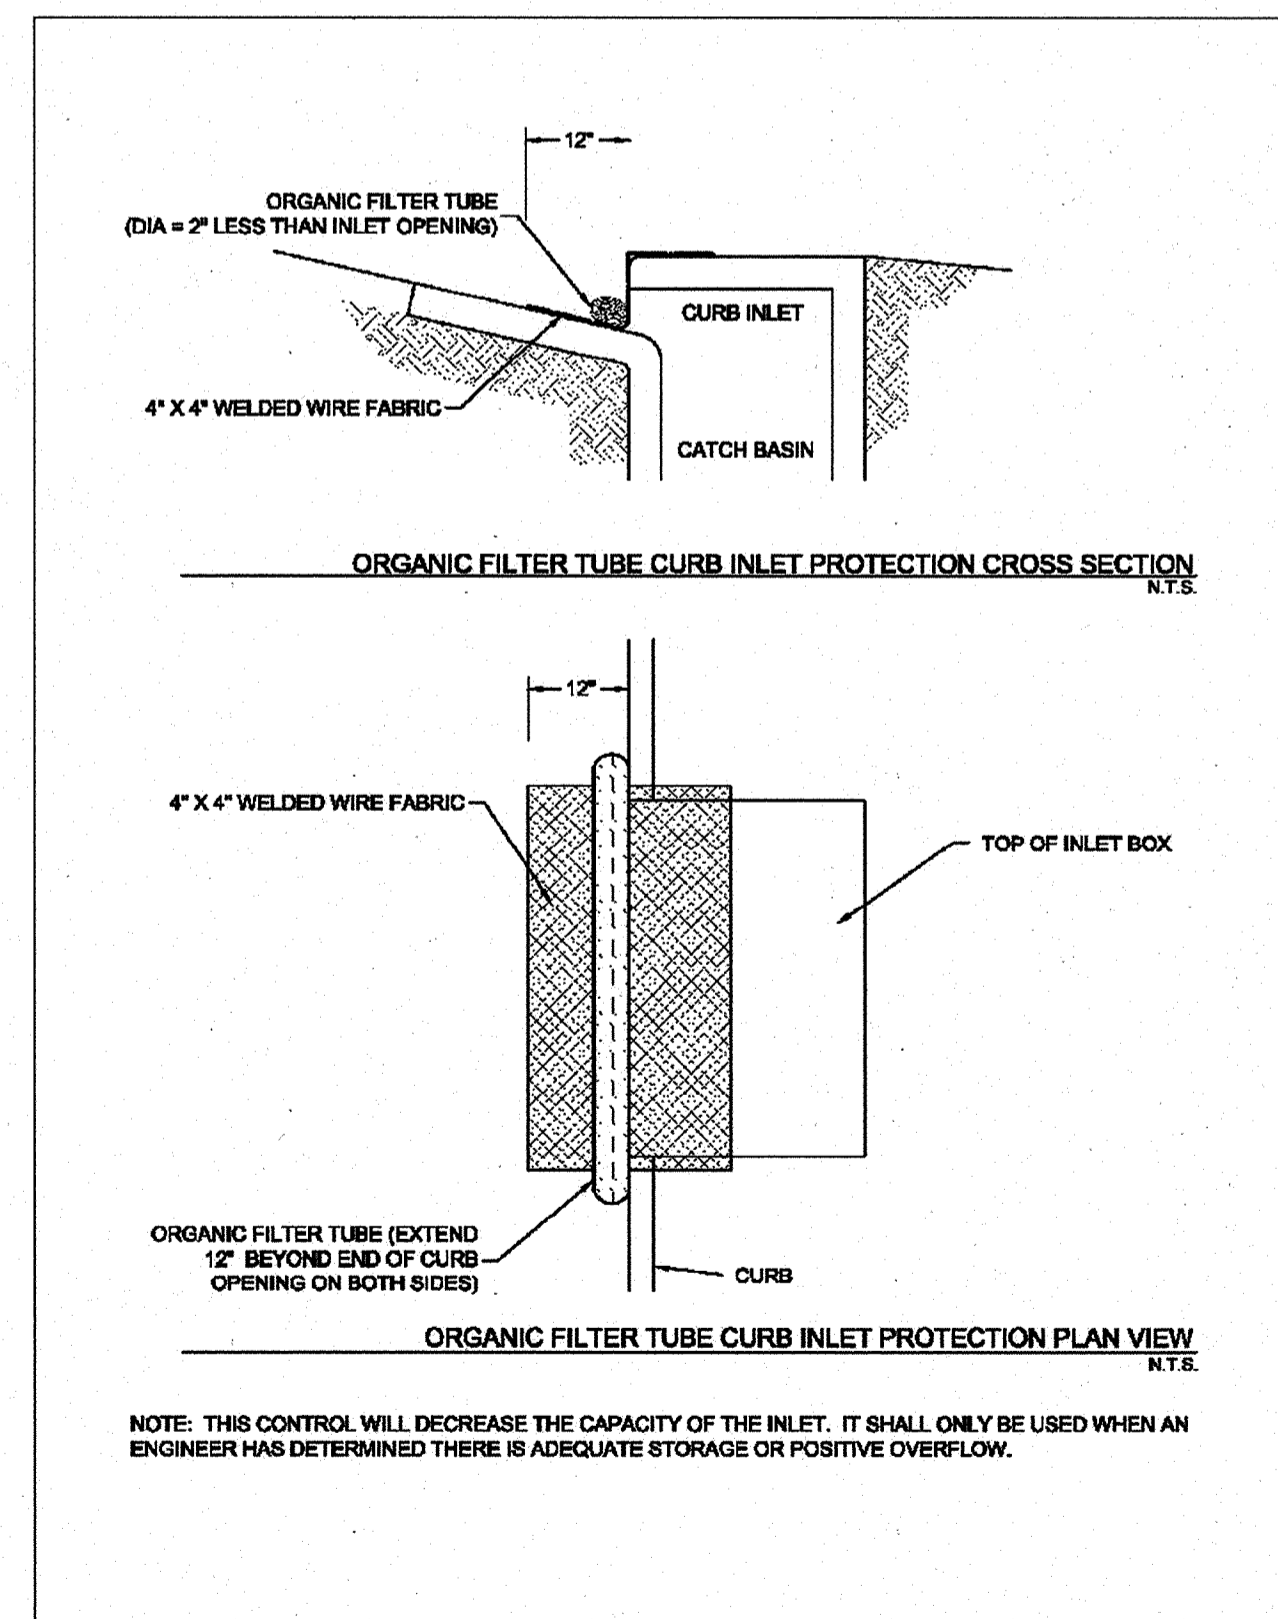


Figure 3.8 Schematics of Organic Filter Tube Curb Inlet Protection  
(Source: Modified from City of Plano BMP SP-4)

Inlet Protection Revised 04/10 CC-88

**"RECORD DRAWING"**  
 THIS DRAWING HAS BEEN REVISED TO SHOW THOSE CHANGES DURING THE CONSTRUCTION PROCESS VISUALLY VERIFIED BY A REPRESENTATIVE FROM OUR OFFICE AND REPORTED BY THE CONTRACTOR TO KIMLEY-HORN AND ASSOCIATES, INC. AND CONSIDERED TO BE SIGNIFICANT. THIS DRAWING IS NOT GUARANTEED TO BE "AS-BUILT" BUT IS BASED ON THE INFORMATION MADE AVAILABLE.

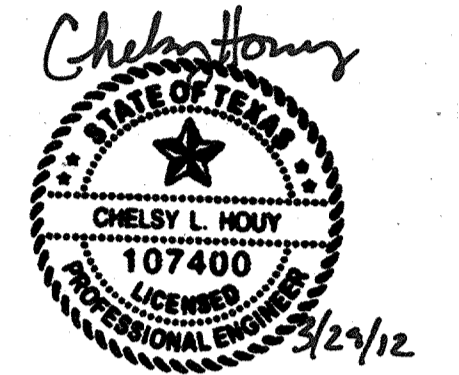

Issue Date: 07/18/11

REVISION INFORMATION

NO.	DATE	REVISION
1	07/21/11	GENERAL REVISIONS
2	09/07/11	CITY COMMENTS
3		
4		
5		
6		
7		

Restaurant #: 11L0042

**OLIVE GARDEN**  
 PROTOTYPE OG-P-75R  
 ROCKWALL BUSINESS  
 PARK EAST SUBDIVISION  
 1043 EAST IH-30

AUTHORIZED FOR: PERMIT/BID

ROCKWALL, TEXAS

DRAWING  
 EROSION CONTROL  
 DETAILS