



Drawing name: K:\SMA_DWG\3587045\DWG\3587045-C-DETAILS.dwg Mar 29, 2012 3:30pm by jmh/brnck
 THIS DOCUMENT, TOGETHER WITH THE CONCEPTS AND DESIGN PRESENTED HEREIN, IS INTENDED ONLY FOR THE SPECIFIC PURPOSE AND CLIENT FOR WHICH IT WAS PREPARED. REUSE OF AND IMPROPER RELIANCE ON THIS DOCUMENT WITHOUT WRITTEN AUTHORIZATION AND ADAPTATION BY KIMLEY-HORN AND ASSOCIATES, INC. SHALL BE WITHOUT LIABILITY TO KIMLEY-HORN AND ASSOCIATES, INC.

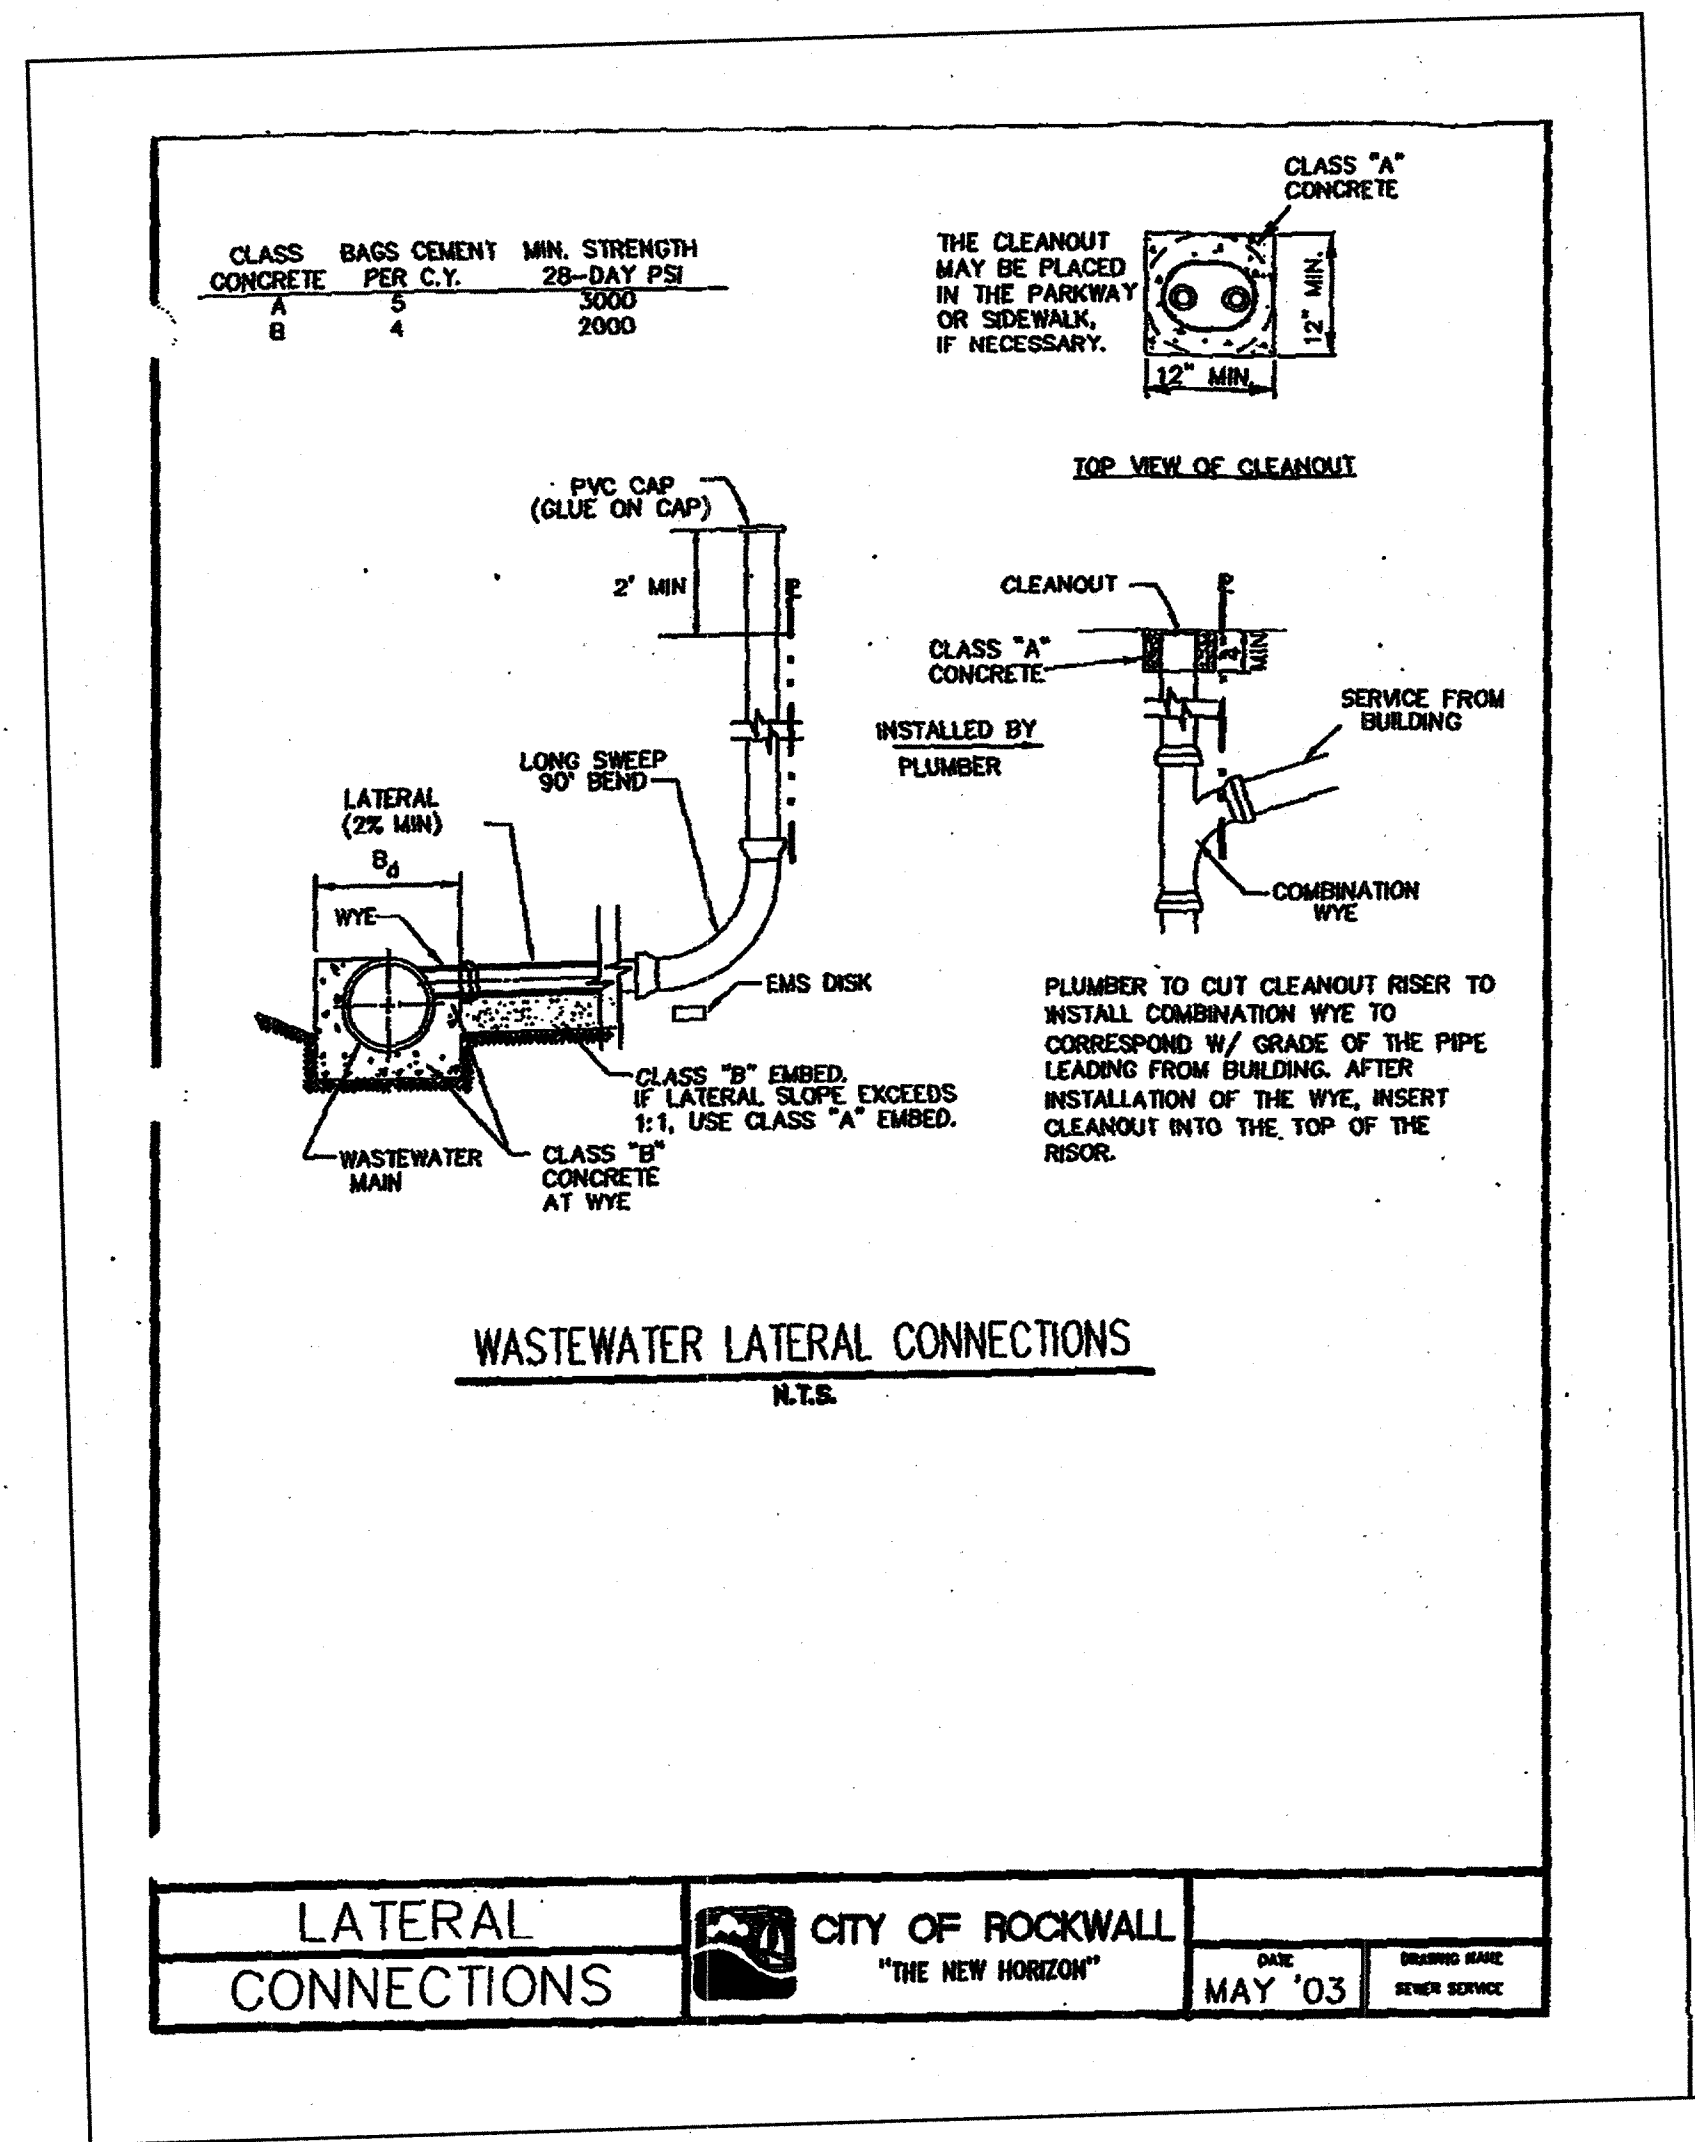

LATERAL CONNECTIONS	CITY OF ROCKWALL "THE NEW HORIZON"	DATE: MAY '03 DRAWN BY: RENEE SCORCE
----------------------------	--	---

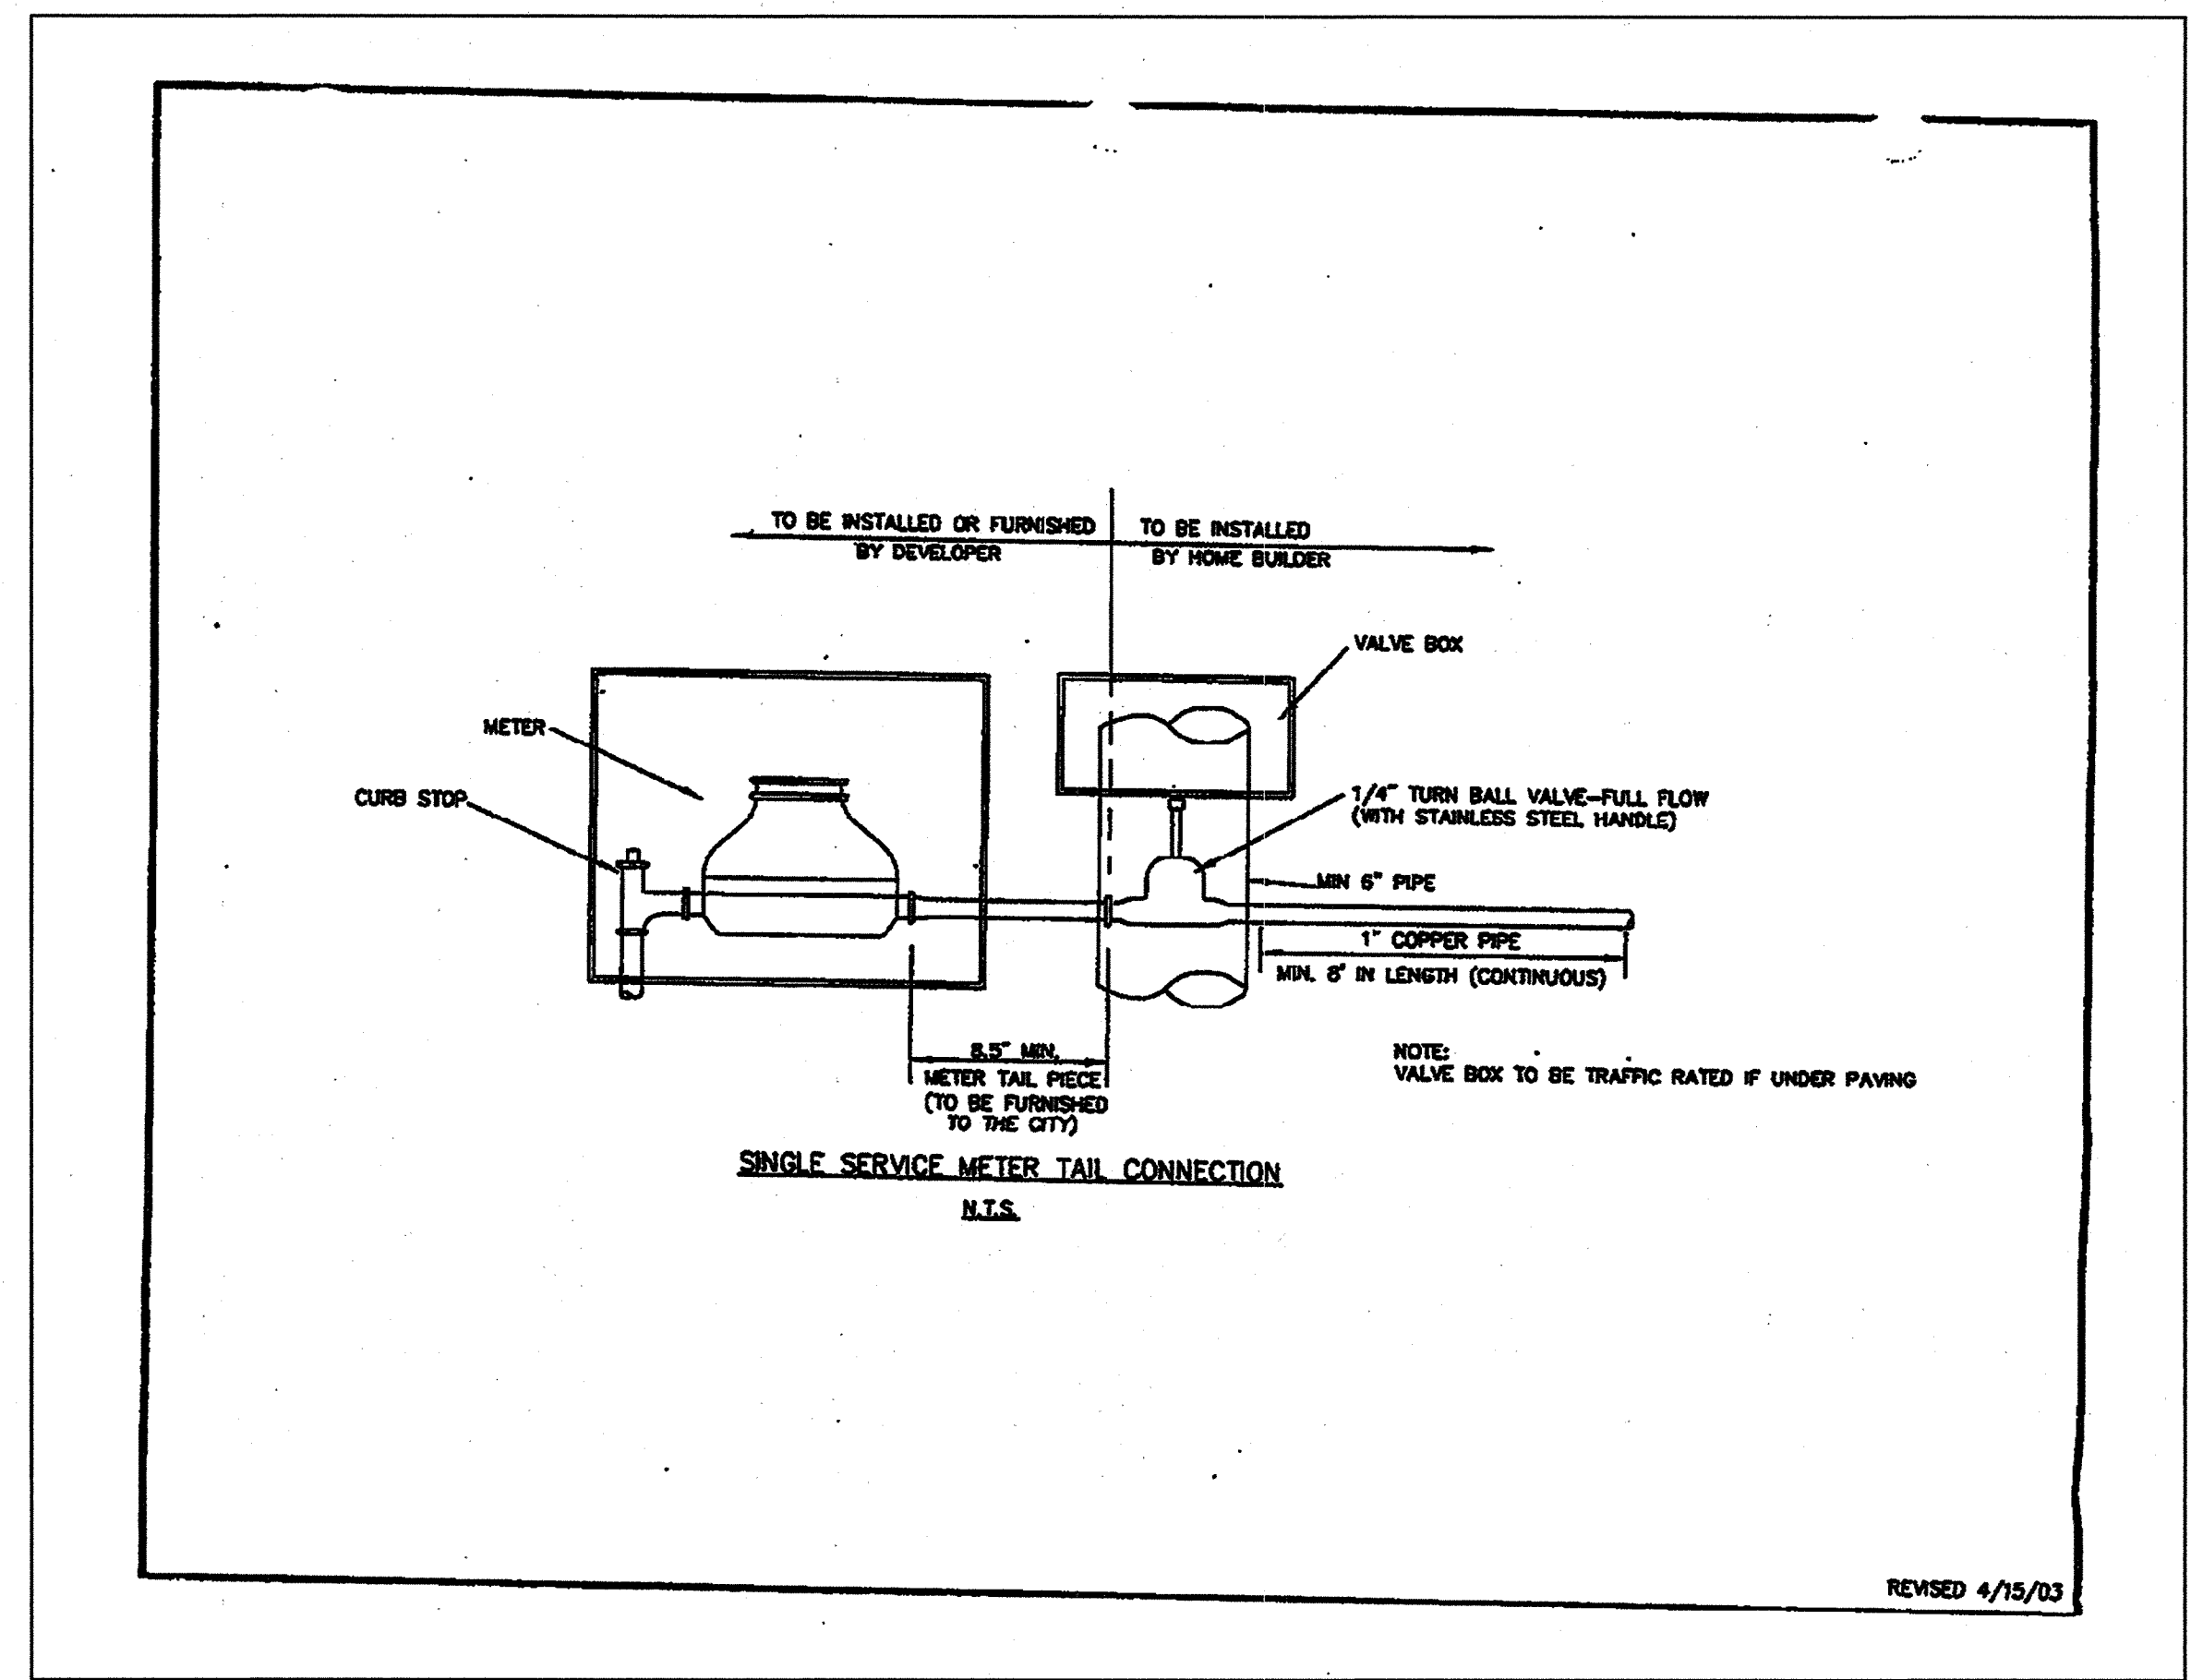

"RECORD DRAWING"
 THIS DRAWING HAS BEEN REVISED TO SHOW THOSE CHANGES DURING THE CONSTRUCTION PROCESS VISUALLY VERIFIED BY A REPRESENTATIVE FROM OUR OFFICE AND REPORTED BY THE CONTRACTOR TO KIMLEY-HORN AND ASSOCIATES, INC. AND CONSIDERED TO BE SIGNIFICANT. THIS DRAWING IS NOT GUARANTEED TO BE "AS-BUILT" BUT IS BASED ON THE INFORMATION MADE AVAILABLE.

NOTE:
 CONTRACTOR TO USE DETAILS AS OUTLINED IN THE STANDARD SPECIFICATIONS FOR PUBLIC WORKS CONSTRUCTION, NORTH CENTRAL TEXAS, THIRD EDITION AND THE CITY OF ROCKWALL STANDARDS OF DESIGN AND CONSTRUCTION FOR ANY DETAILS NOT PROVIDED.

C · R · H · O
 Architecture Interior Planning
 195 South "C" Street 200
 Justin, California 92780
 714 832-1834
 FAX 832-1910

ARCHITECTS PROJECT #:
11194

Kimley-Horn and Associates, Inc.
 601 NW LOOP 410, SUITE 350
 SAN ANTONIO, TEXAS 78216
 PHONE: 210-541-9166
 FAX: 210-541-8669
 WWW.KIMLEY-HORN.COM
 TBPE Firm No. 928

© 2011 KIMLEY-HORN AND ASSOCIATES, INC.
 KHA PROJECT # 083887045

Olive Garden
 ITALIAN RESTAURANT

Issue Date: 07/18/11

REVISION INFORMATION

Restaurant #: 11L0042

OLIVE GARDEN
 PROTOTYPE OG-P-75R
 ROCKWALL BUSINESS
 PARK EAST SUBDIVISION
 1043 EAST IH-30

AUTHORIZED FOR: PERMIT/BID

ROCKWALL, TEXAS

DRAWING
CITY UTILITY DETAILS

C7.1