



# Paving, Drainage and Utility Plans

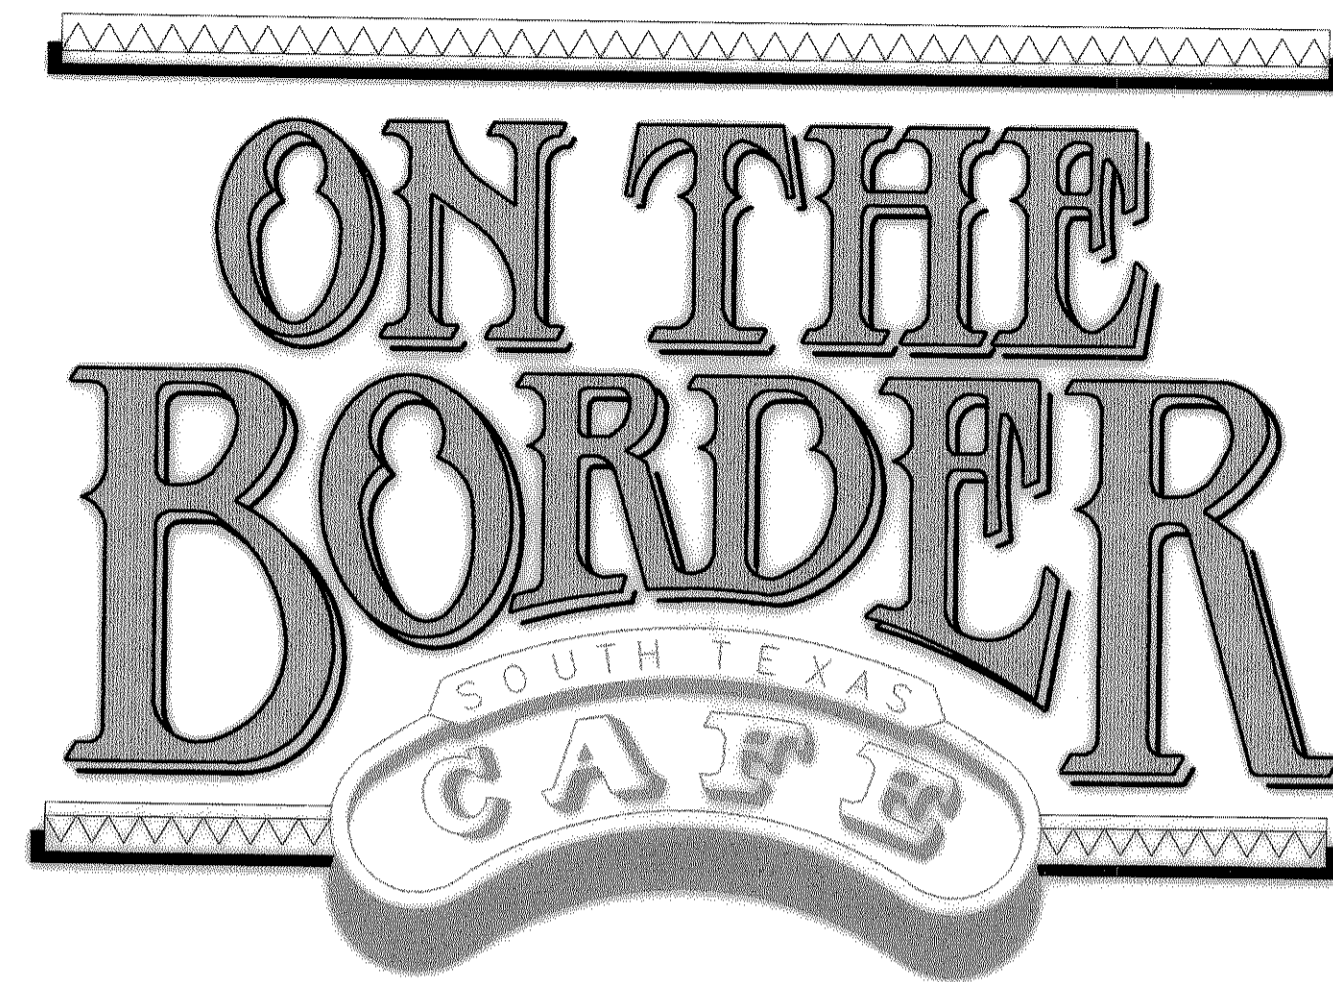

## Lot 2, Block A Home Depot - Rockwall Addition City of Rockwall, Texas

### Index Of Drawings

- Cover Sheet
- C1 Survey
- C2 Final Plat
- C3 Site Plan
- C4 Grading & Drainage Plan
- C5 Utility Plan
- C6 Storm Water Pollution Prevention Plan
- C7 Storm Water Pollution Prevention Guidelines
- C8 Sitework Specifications
- C9 Sitework Specifications (Cont.)
- C10 Standard Details
- L1 Landscape Plan

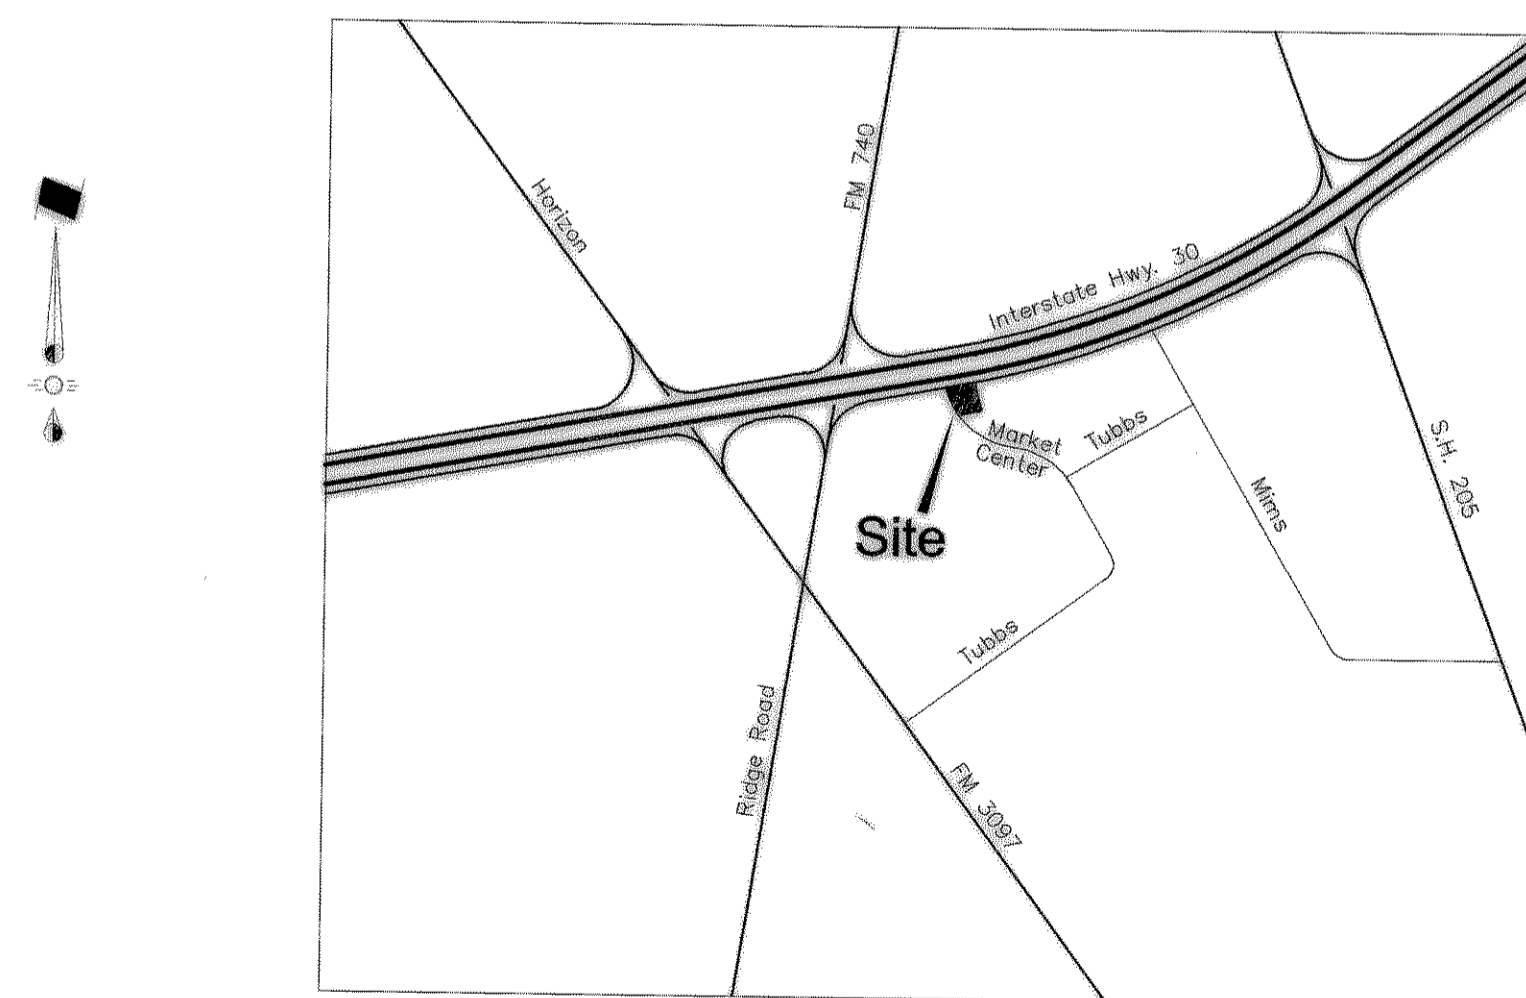

**RLK ENGINEERING**  
803 E. Main St., Suite B - Allen, Texas 75002  
972-359-1733 Fax 972-359-1833



**BRINKER  
INTERNATIONAL**  
6820 LBJ FREEWAY  
DALLAS, TEXAS 75240

**AS-BUILT**

NOTE:  
THESE PLANS HAVE BEEN REVISED  
TO CONFORM WITH CONSTRUCTION  
RECORDS PROVIDED BY CONTRACTOR.