


**SANITARY SEWER SYSTEM SUMMARY**

MANHOLE	RESIDENTIAL FLOW			Commercial or Industrial Point Source Flow		Peak Infiltration/Inflow (gpm)	Total Design Flow Maximum Wet-Weather Day (gpm)		
	FROM	TO	CUMULATIVE POPULATION OR Population Equivalent *	AVERAGE DRY-DAY FLOW (gpm)	MAXIMUM DRY-DAY FLOW (gpm)		Units*	Average Flow (gpm)	
0+00	1+36	144	10	25	-	-	0.14	25.14	25.14
0+00	3+98	60	4.16	10.42	-	-	0.07	10.49	10.49
3+98	6+50	24	1.66	4.17	-	-	0.03	4.20	4.20
0+00	2+01C	885 *	63.49	158.73	-	-	0.03	158.76	158.76
2+01C	4+82	52	3.61	9.05	-	-	0.03	9.08	9.08
0+00	1+03	833 *	57.88	144.70	-	-	0.14	144.84	144.84

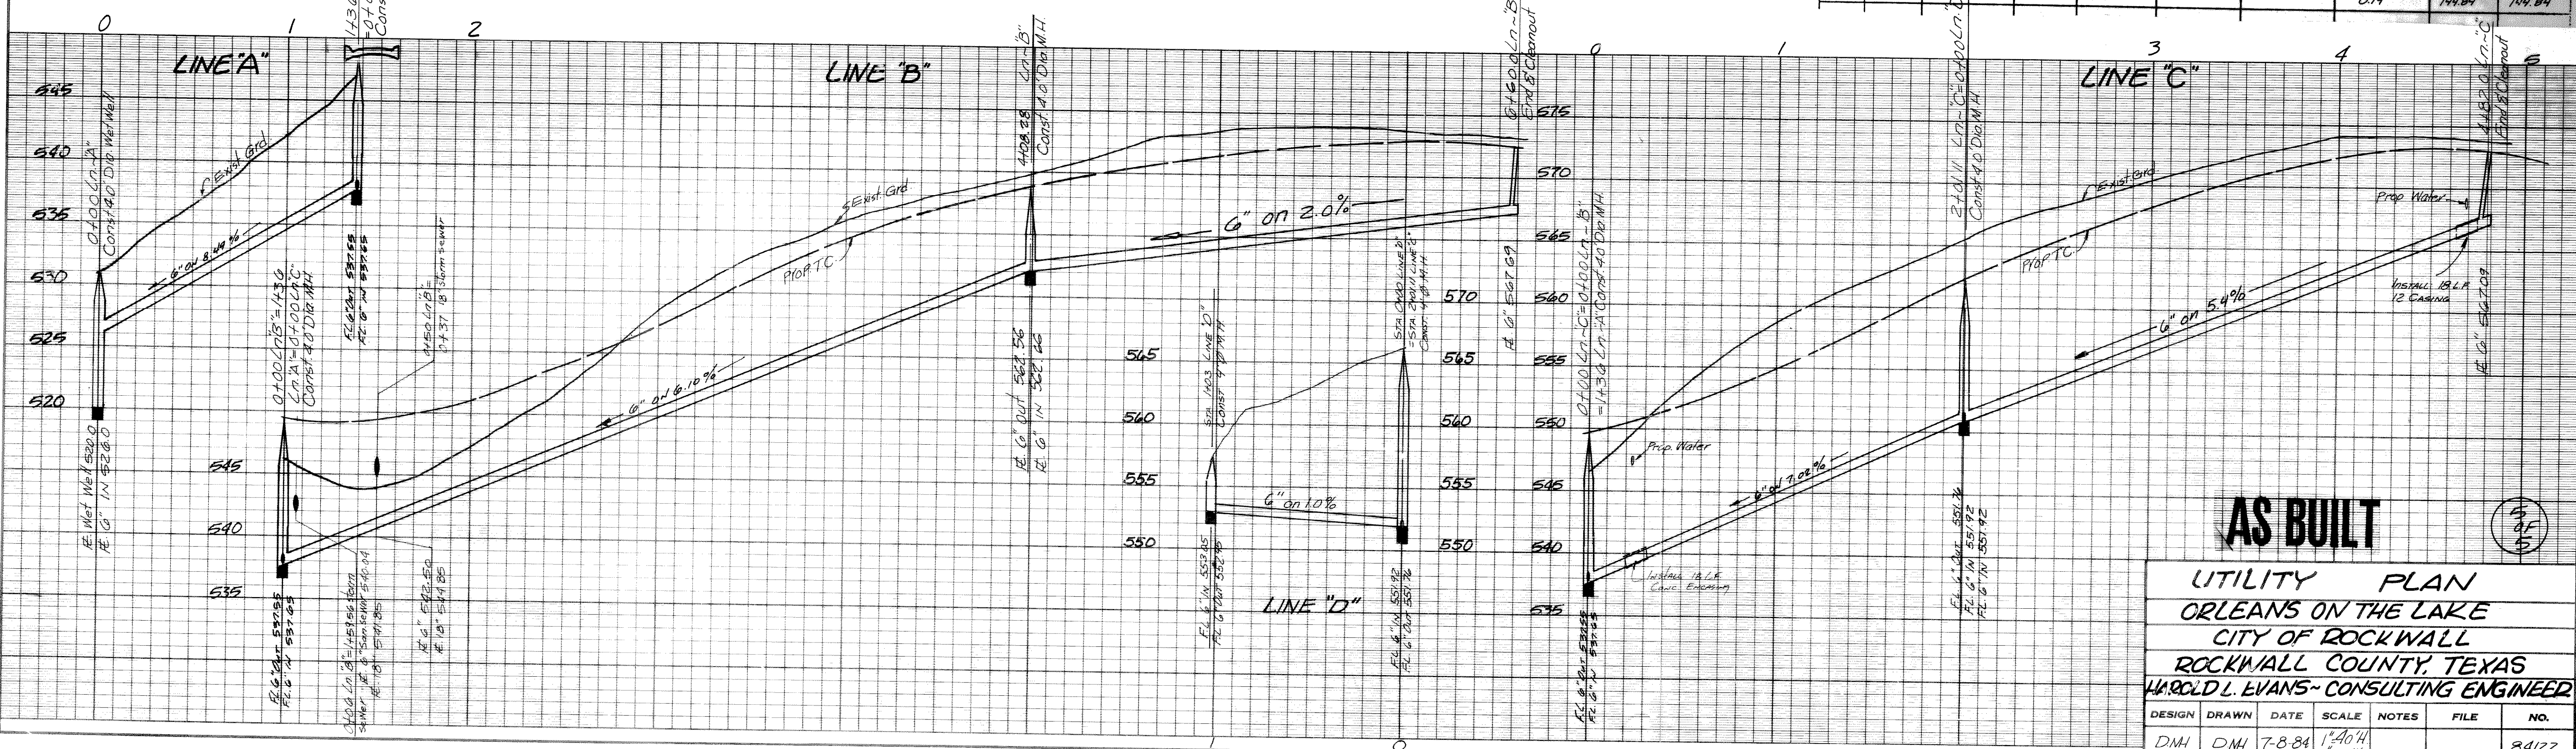

**AS BUILT**

**UTILITY PLAN**  
**ORLEANS ON THE LAKE**  
**CITY OF ROCKWALL**  
**ROCKWALL COUNTY, TEXAS**  
**HAROLD L. EVANS - CONSULTING ENGINEER**

DESIGN	DRAWN	DATE	SCALE	NOTES	FILE	NO.
DMH	DMH	7-8-84	1"=20' 1"=6' V			84122

REV. 8-21-84 REVISED 1-10-85