


THE SEAL APPEARING ON THIS DOCUMENT WAS AUTHORIZED BY THE STATE OF TEXAS P.E. DOUGLAS W. DOUPHRATE, LICENSE NO. 60102, EXPIRES ON DATE: JULY 20, 2015

DOUPHRATE & ASSOCIATES, INC.
ENGINEERING • PROJECT MANAGEMENT • SURVEYING
2235 RIDGE RD., # 200 ROCKWALL, TEXAS 75087
PHONE: (972)771-9004 FAX: (972)771-9005

SITE PLAN
OUR HOUSE
803 N. GOLIAD STREET
B.F. BOYDSTON SURVEY, ABST. 14
CITY OF ROCKWALL
ROCKWALL COUNTY, TEXAS

10-13-15 REV. ACCESS ESMT., EX. RAMP & PARKING REVISION
WLD.
CHECKED
DRAWN
SCALE 1"=10' H 1"=5' V
DATE JULY 20, 2015
PROJECT 15016 SITE PLAN 2
3/14

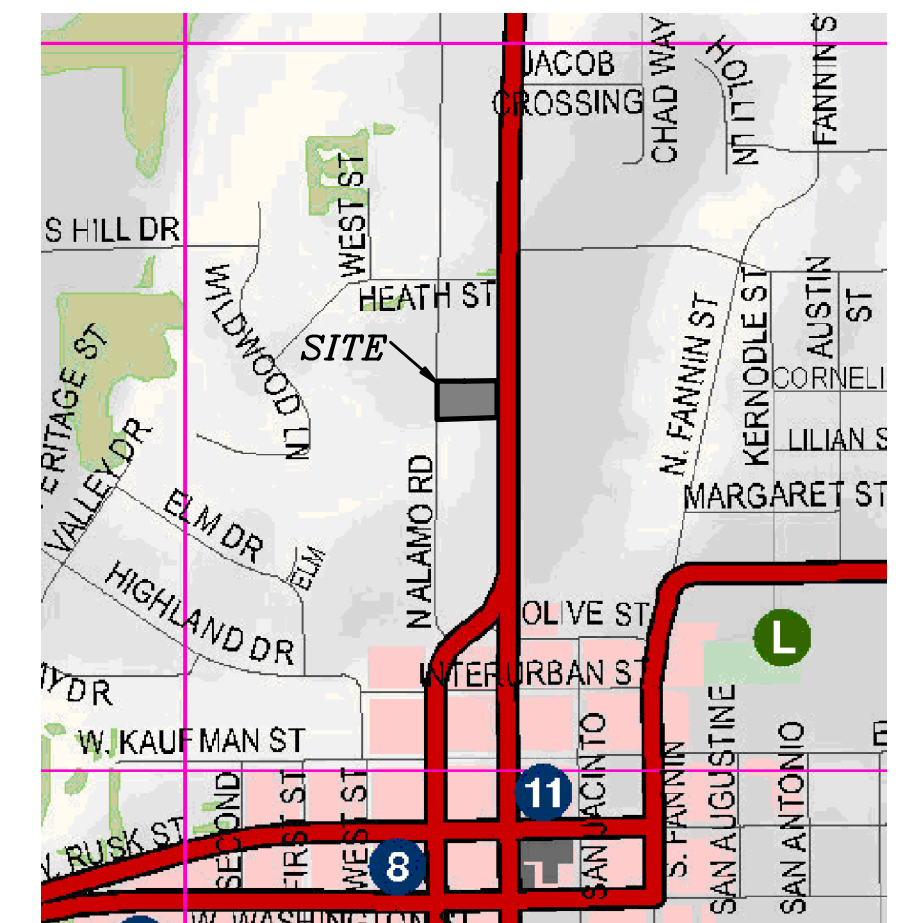

REVISED TO CONFORM TO CONSTRUCTION RECORDS.
W. Douphrate DATE: 12-30-15

ZONING - PD50
TAX ROLL DESCRIPTION
PROPERTY ID 14033
AMICK, BLOCK 23A, .43 ACRES
PROPERTY ID 1435
AMICK, BLOCK 24C,

SURVEYOR
MADDOX SURVEYING & MAPPING, INC.
P.O. Box 2109
Forney, Texas 75126
(972) 564-4416
Firm No. 10013200

Owner
SCOTT MILDER
830 SHORES BLVD.
ROCKWALL, TEXAS 75087
214-497-6411

NOTE:
DIMENSIONS ARE TO BACK OF CURB OR EDGE OF PAVEMENT

