


CONSTRUCTION PLANS FOR DAMASCUS ROAD WIDENING PROJECT OUR LADY OF THE LAKE CATHOLIC CHURCH CITY OF ROCKWALL, ROCKWALL COUNTY, TEXAS

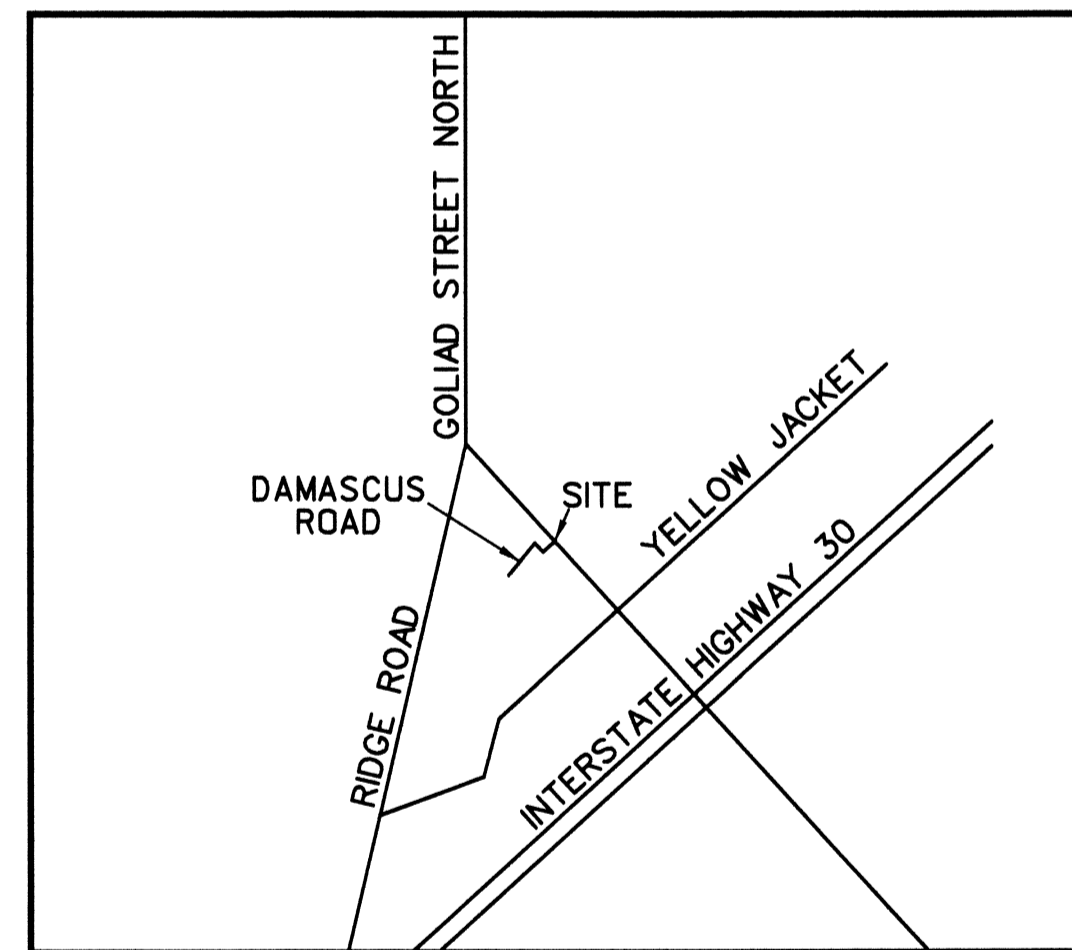

VICINITY MAP
(NOT TO SCALE)

GENERAL CONSTRUCTION NOTES:


- 1) CONTRACTOR SHALL CONTACT MS. ELISABETH MORGAN, ENGINEERING ADMIN. TO SET UP A PRE-CONSTRUCTION MEETING PRIOR TO START OF CONSTRUCTION.
- 2) THE EXISTENCE AND LOCATION OF ALL UNDERGROUND UTILITIES SHOWN ON THESE DRAWINGS WERE OBTAINED FROM FIELD SURVEY AND AVAILABLE RECORDS AND ARE APPROXIMATE AT BEST. THE OWNER, CITY OF ROCKWALL AND ENGINEER ASSUME NO RESPONSIBILITY FOR UTILITIES NOT SHOWN OR NOT IN THE LOCATION SHOWN. THE CONTRACTOR SHALL DETERMINE THE DEPTH AND LOCATION OF ALL EXISTING UNDERGROUND UTILITIES PRIOR TO CONSTRUCTION AND SHALL BE REQUIRED TO TAKE ANY MEASURES NECESSARY TO PROTECT ALL UTILITIES SHOWN AND/OR ANY OTHER UTILITIES NOT OF RECORD OR NOT SHOWN ON THE PLANS. CONTRACTOR SHALL BE RESPONSIBLE FOR CONTACTING ALL FRANCHISE AND CITY UTILITIES PRIOR TO CONSTRUCTION.
3. ANY CONTRACTOR/SUBCONTRACTOR PERFORMING WORK ON THIS PROJECT SHALL FAMILIARIZE HIMSELF WITH THE SITE AND SHALL BE SOLELY RESPONSIBLE FOR ANY DAMAGE TO EXISTING FACILITIES RESULTING DIRECTLY OR INDIRECTLY FROM HIS OPERATIONS. EXISTING IMPROVEMENTS SHALL INCLUDE BUT NOT BE LIMITED ANY UTILITY OR FUEL LINE, BERMS, DITCHES, FENCES, PLANTS, TREES, EX. PAVEMENT, OVERHEAD POWER AND FRANCHISE UTILITY LINES, UNDERGROUND POWER AND FRANCHISE UTILITY LINES, ETC. ANY DAMAGE OR REMOVAL TO EXISTING IMPROVEMENTS SHALL BE REPLACED OR REPAIRED BY THE CONTRACTOR OR HIS DESIGNEE AT HIS EXPENSE AND SHALL BE APPROVED BY THE CITY OF ROCKWALL AND ALL GOVERNING AUTHORITIES.
4. ALL CONSTRUCTION, TESTING AND CONSTRUCTION MATERIALS SHALL MEET OR EXCEED ALL STANDARDS, DETAILS, SPECIFICATIONS & PRACTICES OF THE CITY OF ROCKWALL AND THE NCTCOG STANDARD SPECIFICATIONS FOR PUBLIC WORKS CONSTRUCTION THIRD EDITION.
5. TEMPORARY SIGNAGE REQUIRED TO MAINTAIN TRAFFIC FLOW AND THE SAFETY OF MOTORISTS TO BE INSTALLED WHERE REQUIRED BY THE CONTRACTOR.
6. LANE CLOSURE OF DAMASCUS (WHEN REQUIRED) TO BE LIMITED TO BETWEEN THE HOURS OF 8:00 AM AND 4:00 PM MONDAY THROUGH FRIDAY.
7. TRAFFIC FLOW ON AFFECTED DRIVES TO BE MAINTAINED AT ALL TIMES.
8. ALL DISTURBED SOIL TO BE RE-VEGETATED AS PART OF THIS CONTRACT. CONTRACTOR RESPONSIBLE FOR RE-VEGETATION. FINAL PAYMENT WILL NOT BE MADE UNTIL RE-VEGETATION IS APPROVED BY THE ENGINEER.
9. ALL DETAILS REFERENCED BY THESE PLANS HAVE BEEN SELECTED UNDER THE SUPERVISION OF JOSEPH E. HELMBERGER, P.E. #66040
10. THE SEAL APPEARING ON THIS DOCUMENT WAS AUTHORIZED BY JOSEPH E. HELMBERGER, P.E. 66040 ON JUNE 30, 2009. ALTERATION OF A SEALED DOCUMENT WITHOUT PROPER NOTIFICATION TO THE RESPONSIBLE ENGINEER IS AN OFFENSE UNDER THE TEXAS ENGINEERING PRACTICE ACT.

SHEET INDEX

COVER	
FINAL PLAT	
PAVING PLAN/PROFILE	C1
DRIVE ENTRY DIMENSIONAL CONTROL PLAN	C2
DRIVE ENTRY GRADING/DRAINAGE PLAN	C3
EROSION CONTROL PLAN	C4

AS-BUILT DRAWING 06-21-11

TO THE BEST OF OUR KNOWLEDGE, HELMBERGER ASSOCIATES, INC. HEREBY STATES THAT THIS PLAN IS AS-BUILT. THIS INFORMATION PROVIDED IS BASED ON SURVEYING AT THE SITE AND INFORMATION PROVIDED BY THE CONTRACTOR.

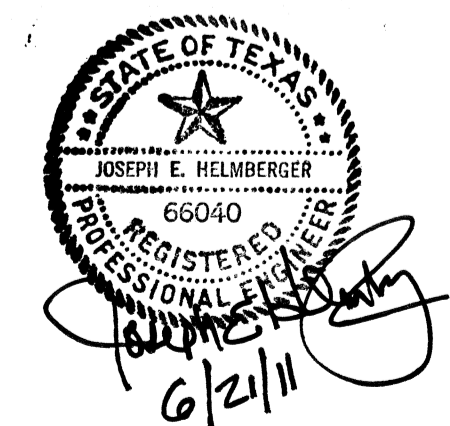

ENGINEER:

HELMBERGER ASSOCIATES, INC.
CIVIL AND ENVIRONMENTAL ENGINEERS
1525 BOZMAN ROAD, WYLIE TEXAS 75098 (972) 442-7459
MR. JOSEPH E. HELMBERGER, P.E.

TBPE
REGISTRATION
F-000756

Survey work provided by Mr. Jay Bedford, RPLS, A.J. Bedford Group, Inc., 301 North Alamo, Rockwall, Texas 75043. Phone: 972.722.0225.

A-built utilities, paving and drainage information obtained from record drawings on file with the City of Rockwall and information provided by Our Lady of the Lake Catholic Church.

REVISED TO REFLECT AS-BUILT CONDITION JUNE 21, 2011
REVISED PER CITY COMMENT JULY 28, 2009