

PBA EAST

DRAINAGE CALLS


- ① INSTALL 18 LF 18" RCP STORM DRAIN PIPE @ 18.70%. CONNECT TO EXISTING 42" STORM DRAIN PIPE. REMOVE AND REPLACE EXISTING CONCRETE PAVEMENT TO THE PANEL JOINTS. FL 18" = 541.57 , FL 42" = 540.57
- ② CONSTRUCT 10' CURB INLET. TC = 548.75, FL 18" = 544.90
- ③ REMOVE EXIST. WYE INLET & CONSTRUCT 3' x 3' JUNCTION BOX. CONNECT 12" ROOF DRAIN (SEE PLUMBING PLANS) TO JUNCTION BOX. FL 12" (IN) = 545.25 FL EXIST. 18" (OUT) = 541.14

PAVEMENT NOTE

1. REMOVE ALL EXISTING CONCRETE TO THE PANEL JOINTS WHEN INSTALLING NEW UNDERGROUND UTILITIES. MIN. 8" 3,600 PSI CONCRETE.

DISCLAIMER

TO THE BEST OF OUR KNOWLEDGE, THE WALLACE GROUP, INC. HEREBY STATES THAT THIS PLAN IS AS-BUILT/RECORD DRAWINGS. THE INFORMATION PROVIDED IS BASED ON SURVEYING CONDUCTED AT THE SITE AND INFORMATION PROVIDED BY THE CONTRACTOR.

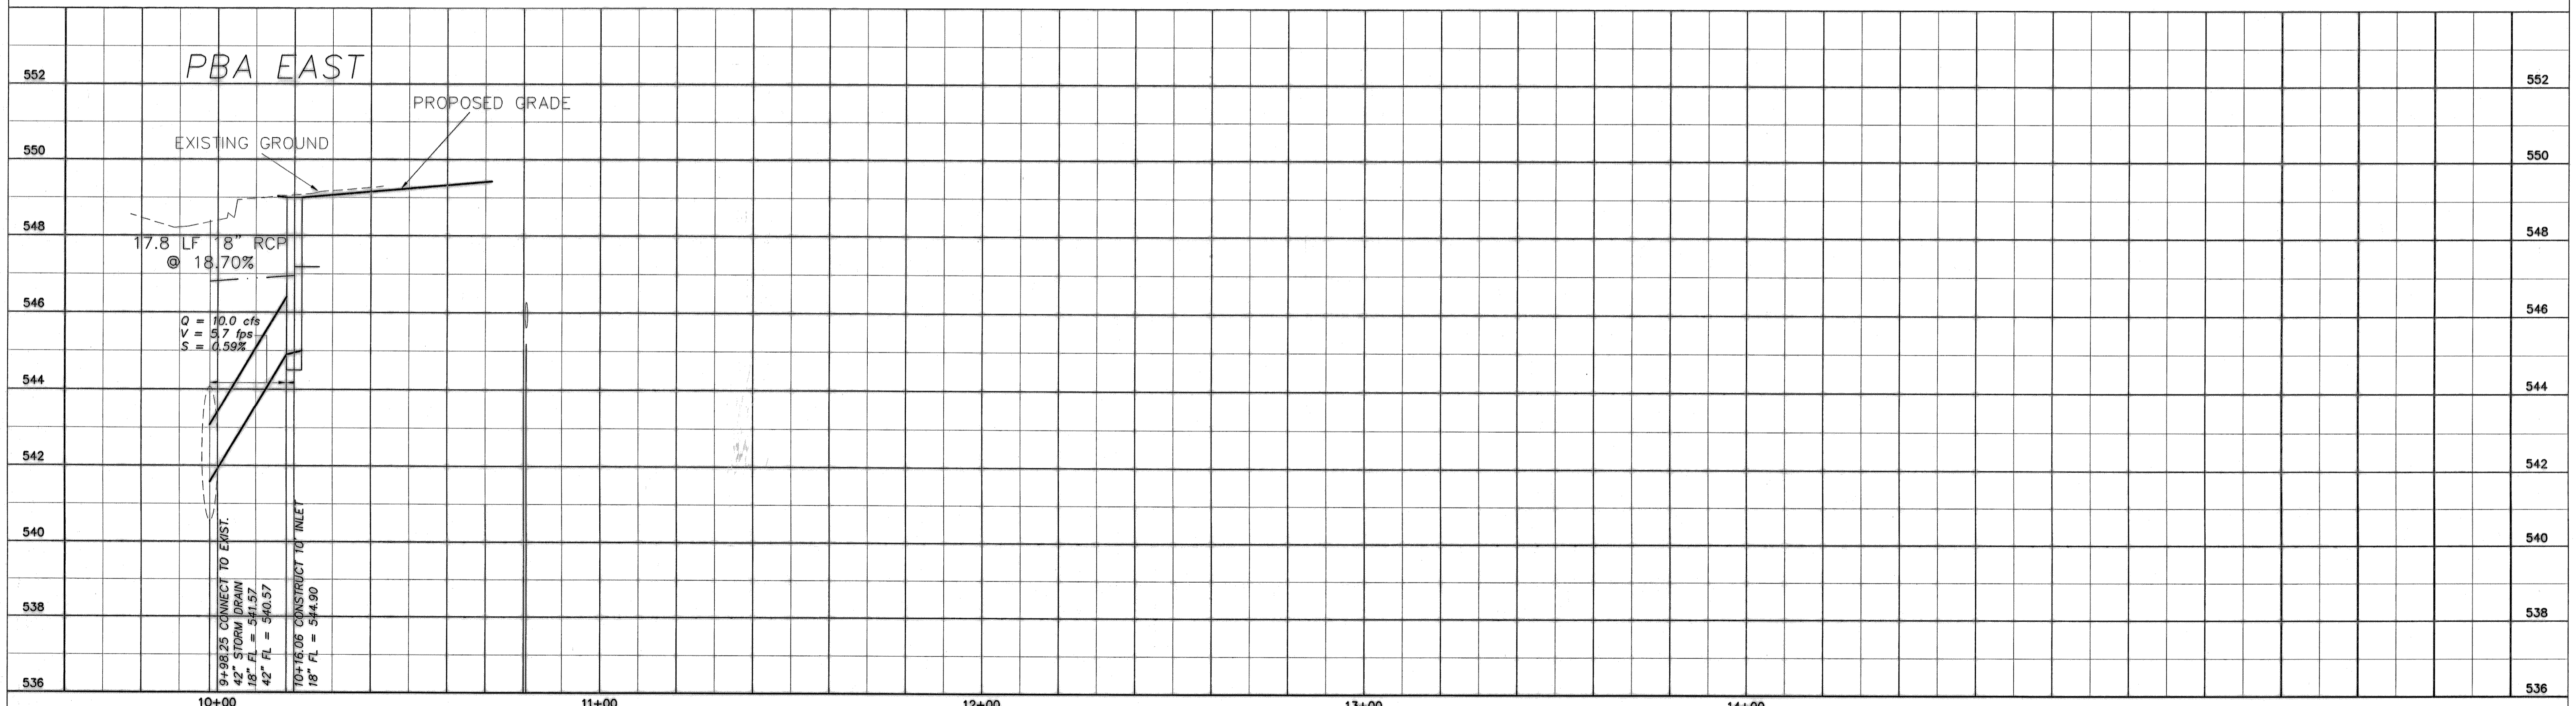

<table border="1" style="width: 100%; border-collapse: collapse;"> <tr> <th>REV</th> <th>DATE</th> <th>BY</th> <th>DESCRIPTION</th> </tr> <tr> <td> </td> <td> </td> <td> </td> <td> </td> </tr> </table>	REV	DATE	BY	DESCRIPTION							DESIGNED: DPS DRAWN: SRM CHECKED: DPS		"THE SEAL APPEARING ON THIS DOCUMENT WAS AUTHORIZED BY ON THE DATE SHOWN ON THE DATESTAMP. ALTERATION OF A SEALED DOCUMENT WITHOUT PROPER NOTIFICATION TO THE RESPONSIBLE ENGINEER IS AN OFFENSE UNDER THE TEXAS ENGINEERING PRACTICE ACT"		PBA WEST RETAIL BUILDING ROCKWALL CROSSING STORM DRAINAGE PLAN & PROFILE PBA EAST	SHEET 13 OF 1 SHEETS
REV	DATE	BY	DESCRIPTION													

G:\Projects\18816\dwg\AS-BUILT_5-12-08\18816_AB_PBA-EAST_SHT13_STORM-P.P.dwg DRAIN PROFILES 2 5/19/2008 9:06:16 AM 1:1