
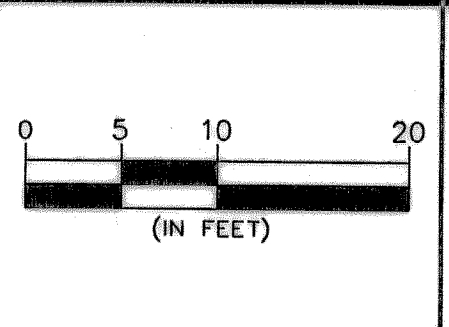



NOTES
 ① SAWCUT AND REMOVE 45 LF OF CONCRETE CURB.

DISCLAIMER
 TO THE BEST OF OUR KNOWLEDGE, THE WALLACE GROUP, INC. HEREBY STATES THAT THIS PLAN IS AS-BUILT/RECORD DRAWINGS. THE INFORMATION PROVIDED IS BASED ON SURVEYING CONDUCTED AT THE SITE AND INFORMATION PROVIDED BY THE CONTRACTOR.

REV	DATE	BY	DESCRIPTION

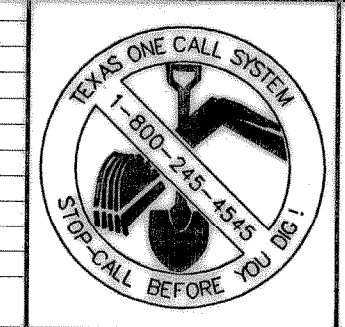

DESIGNED: DPS
 DRAWN: SRM
 CHECKED: DPS

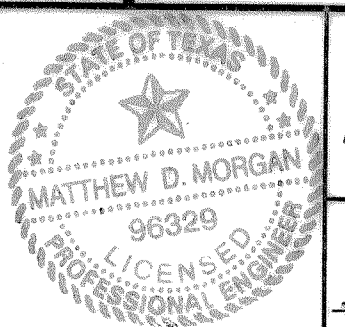

"THE SEAL APPEARING ON THIS DOCUMENT WAS AUTHORIZED BY MATTHEW D. MORGAN ON THE DATE SHOWN ON THE SEAL/STAMP. ALTERATION OF A SEALED DOCUMENT WITHOUT PROPER NOTIFICATION TO THE RESPONSIBLE ENGINEER IS AN OFFENSE UNDER THE TEXAS ENGINEERING PRACTICE ACT"

5/17/2018 *Matthew D. Morgan*

ENGINEERS ARCHITECTS PLANNERS
THE WALLACE GROUP INC.

PBA WEST RETAIL BUILDING
 ROCKWALL CROSSING
PBA EAST SURVEY & DEMOLITION PLAN