

LEGEND

- EXISTING CONCRETE PAVEMENT
- 5" STANDARD DUTY CONCRETE PAVEMENT
- 8" HEAVY DUTY CONCRETE PAVEMENT AT DUMPSTER PAD
- 5" STANDARD DUTY CONCRETE PAVEMENT (PAINTED BLACK), REFER TO GENERAL NOTES FOR SPECIFICATIONS.

NOTE:

1. ALL DIMENSIONS ARE TO FACE OF CURB UNLESS OTHERWISE NOTED.
2. CONTRACTOR WILL BE RESPONSIBLE FOR COSTS TO RELOCATE ALL COMMUNICATION POLES, BOXES, METERS, VAULTS, AND ASSOCIATED LINES.
3. REFER TO NOTE #2 OF PAVING NOTES ON SHEET C-1 FOR PAVEMENT REQUIREMENTS.

PAVING NOTES SCHEDULE


- 1 4" WHITE TRAFFIC STRIPING
- 2 PROPOSED 6" CONCRETE CURB AND GUTTER
- 3 PROPOSED HC RAMP. SEE CONSTRUCTION DETAILS.
- 4 PROPOSED CONCRETE FLATWORK. REFER TO ARCH. SITE PLAN FOR DETAILS.
- 5 PROPOSED WHITE PAINT (TYP.) STRIPING @ 45" SPACED 2.0' O.C. REFER TO CONSTRUCTION DETAILS FOR HC SPACE SPECIFICATIONS
- 6 PROPOSED STOP BAR. SEE CONSTRUCTION DETAILS
- 7 CONNECT TO EXISTING CONCRETE CURB AND GUTTER
- 8 PROPOSED CONCRETE WHEEL STOPS. SEE CONSTRUCTION DETAILS.
- 9 PROPOSED 2" FLUME. SEE CONSTRUCTION DETAILS.
- 10 PROPOSED DIRECTIONAL ARROWS. SEE CONSTRUCTION DETAILS.
- 11 PROPOSED DUMPSTER PAD AND TRASH ENCLOSURE. SEE ARCH. PLANS FOR DETAILS.

RECORD DRAWING
T. Jason Bannister, P.E.
DATE: 06-14-2006
THIS RECORD DRAWING HEREIN REFLECTS TO THE BEST OF THE DESIGN ENGINEER'S KNOWLEDGE BASED ON A FIELD VERIFICATION SURVEY DIRECTED BY THE ENGINEER, THE LOCATION OF THE CONSTRUCTED WORK, USING INFORMATION AS PROVIDED BY THE CONTRACTOR, FIELD VISITS AND THE REFERENCED SURVEY.

BENCHMARKS
"X" found for corner in the southwest line of F.M. Road No. 3097, a 100 foot right-of-way at this point, said point being at the southeasterly corner of a 7.5 foot strip of land dedicated for widening of said F.M. Road No. 3097 as shown by plat of Lot 1, Block A of Mr. M. Addition

No.	Date	Revisions	App.

Kimley-Horn and Associates, Inc.
Tel. No. (817) 335-8511
Fax No. (817) 335-8070
801 Cherry Street, Unit 11, Suite 1025
Fort Worth, Texas 76102

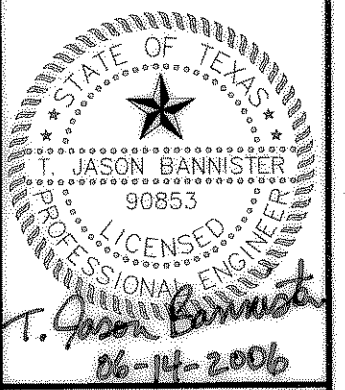

**PANDA EXPRESS
LOT 20, BLOCK A
HORIZON RIDGE ADDITION
ROCKWALL, TEXAS**

**DIMENSION CONTROL
AND PAVING PLAN**

Scale: AS SHOWN
Designed by: TJB
Drawn by: MAS
Checked by: JML
Date: JUNE 2006
Project No. 066081015

SHEET
C-2
OF 6