



CAUTION: EXISTING UNDERGROUND UTILITIES. CONTRACTOR TO FIELD VERIFY THE LOCATION OF ALL EXISTING UTILITIES PRIOR TO EXCAVATION.

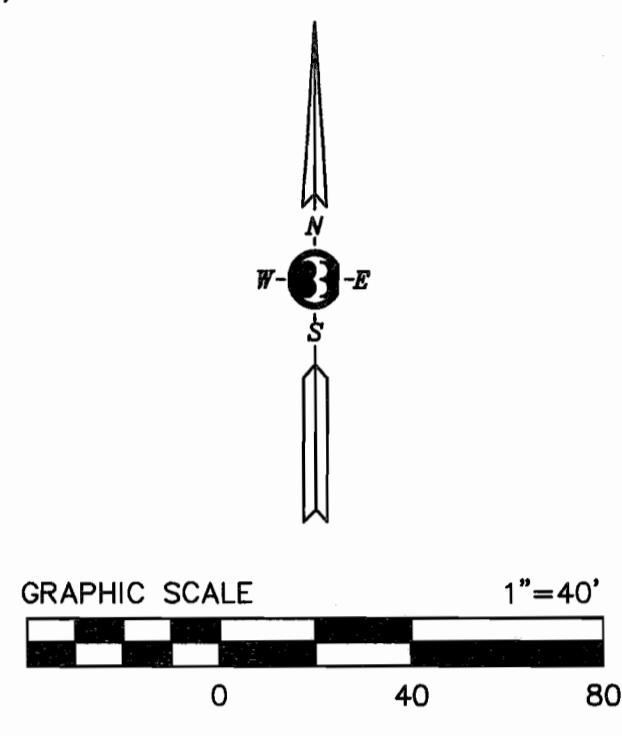

LEGEND

- 550 --- EX. CONTOUR INTERVAL
- 550 --- PROP. MAJOR CONTOUR
- 550 --- PROP. MINOR CONTOUR
- 500.0 --- PROP. FINISHED GRADE
- >--- PROP. STORM DRAINAGE FLOW
- >--- PROP. DRAINAGE FLOW DIRECTION
- >--- PROPOSED STORM INLET
- EX 531.3 EXISTING GRADE
- TC 541.8 TOP OF CURB GRADE

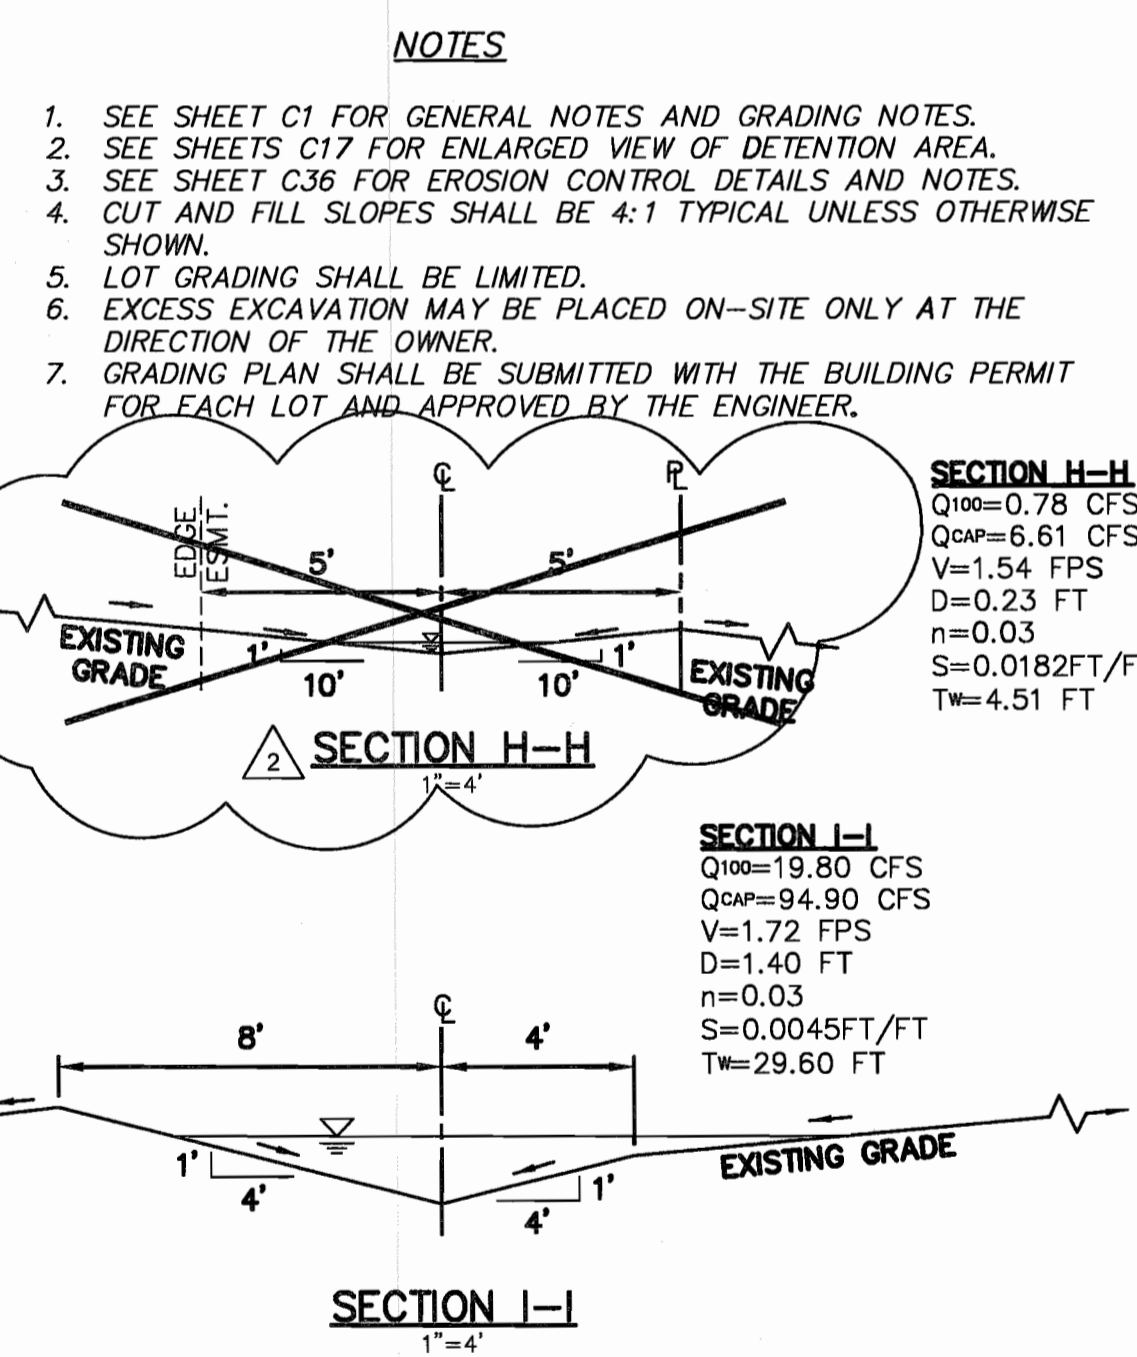

CONSTRUCTION RECORDS
 DATE: 10.10.2019 BY: [Signature]
 THIS DRAWING INDICATES THE WORK COMPLETED PER INFORMATION SUPPLIED BY THE CONTRACTOR. THE ACCURACY AND COMPLETENESS OF THE INFORMATION HAS NOT BEEN VERIFIED. ACTUAL ON THE GROUND SURVEY VERIFICATION WAS NOT PERFORMED EXCEPT AS SPECIFICALLY NOTED. TOMDEN ENGINEERING, L.L.P. SHALL NOT BE RESPONSIBLE FOR ANY ERRORS OR OMISSIONS THAT MAY BE INCORPORATED AS A RESULT OF ERRONEOUS INFORMATION PROVIDED BY OTHERS.

BENCHMARKS

- 1. TM ON THE SOUTH EDGE OF PAVEMENT OF WASHINGTON STREET AT THE INTERSECTION OF ALUMINUM PLANT ROAD. ELEVATION = 542.91'
- 2. TM ON THE EAST EDGE OF PAVEMENT OF RENFRO STREET APPROXIMATELY 340' SOUTH OF THE INTERSECTION ON HARTMAN. ELEVATION = 535.43'

DESIGNED BY: TPJ
 DRAWN BY: ADC
 CHECKED BY: TPJ
 JOB NO.: 10.04.2019
 DATE: 10.04.2019
 SCALE: AS SHOWN

TOMDEN ENGINEERING, L.L.P.
 5815 MEADOWCREST
 DALLAS, TX 75230
 (214) 679-1679
 tjones@tomden.com
 FIRM No. 19744

PARK PLACE WEST - PHASE III
 R. BALLARD SURVEY ABSTRACT NO. 29
 ROCKWALL, ROCKWALL COUNTY, TEXAS

GRADING PLAN AREA III

Sheet No: **C11.1** OF 38