

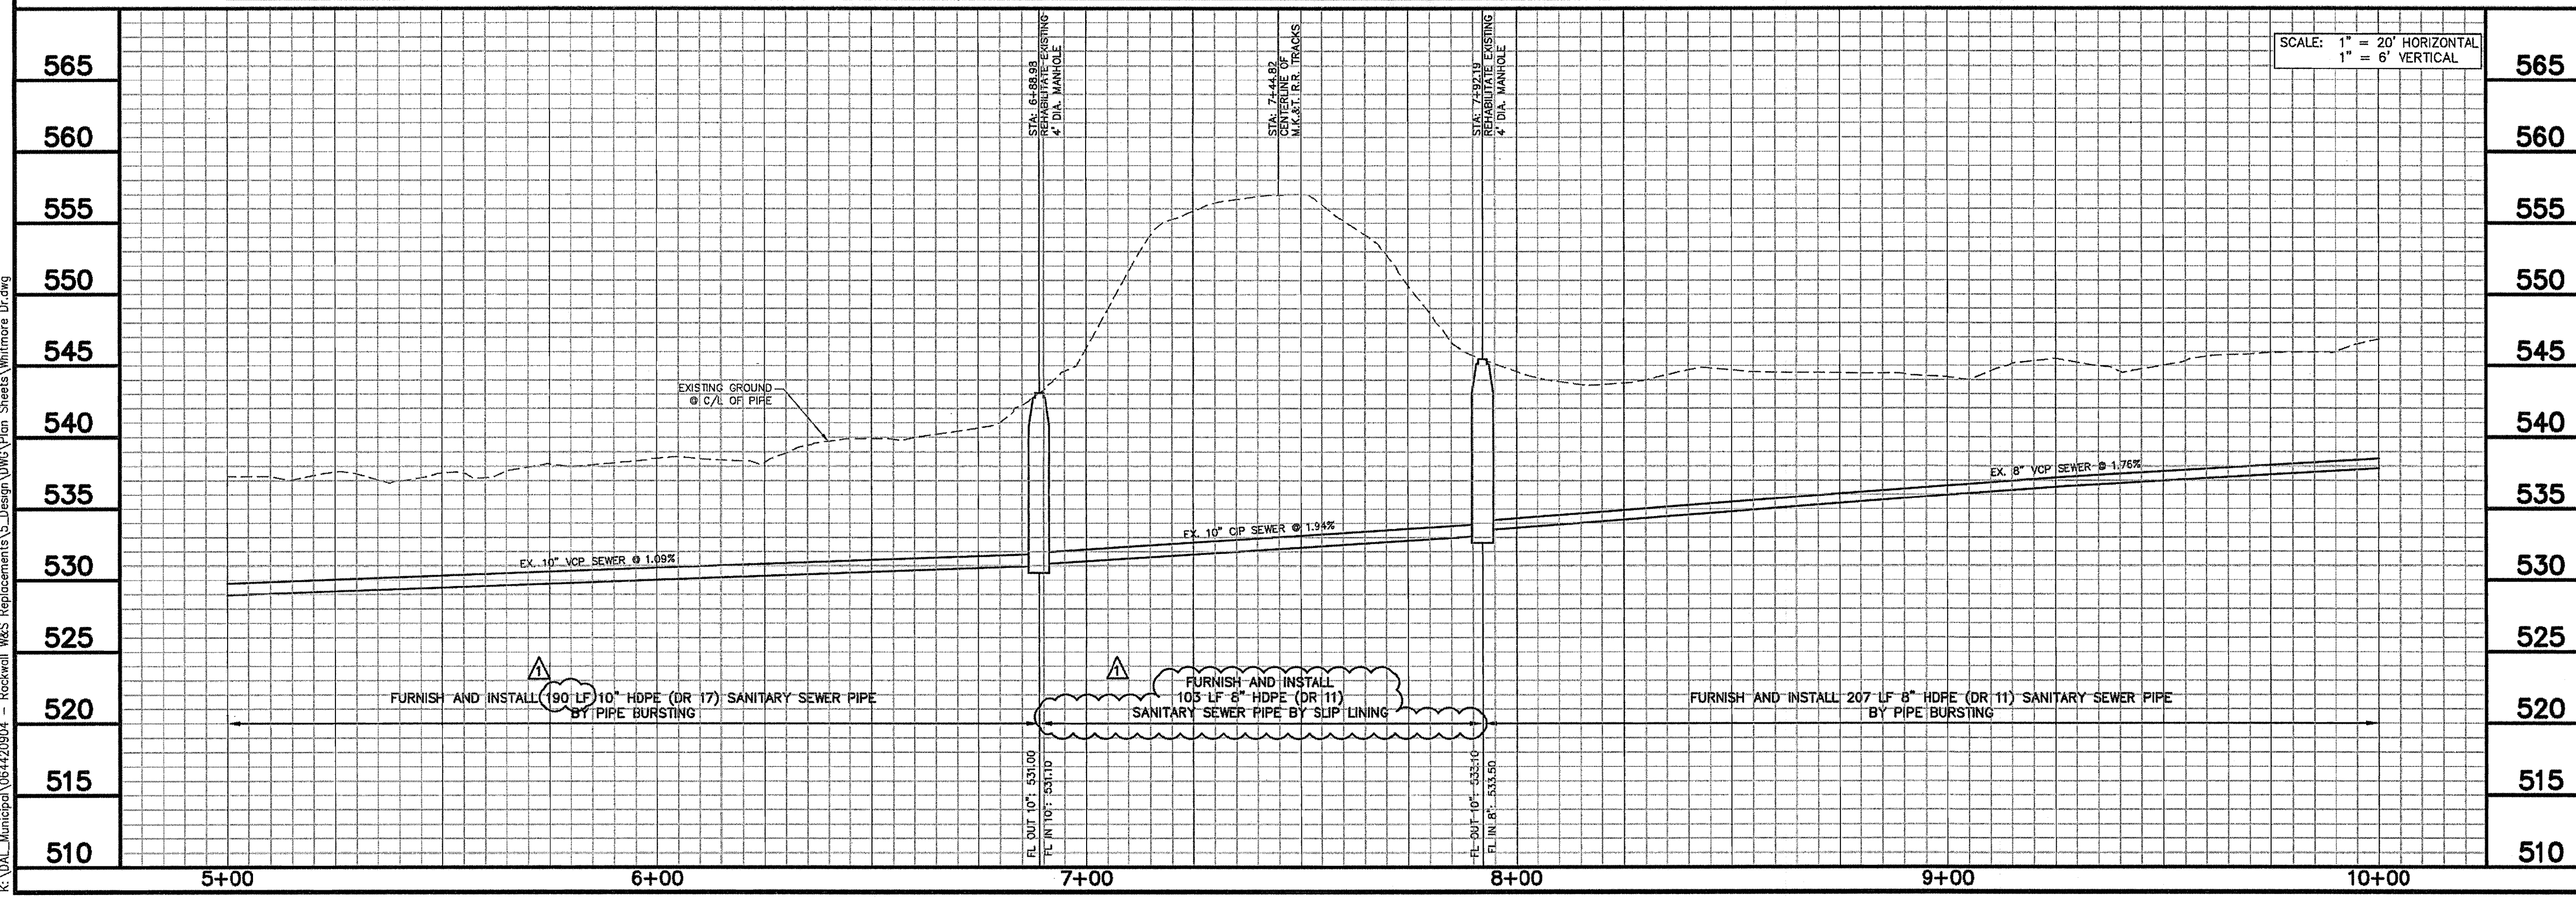


N:\B013054 - Brecker\054 CAD Files\054-MS--PRO.dwg-Existing 10" Sewer (2) Plotted May 30, 2016 at 3:52pm by jltzgerod | Last Saved by: jltzgerod

K:\DAL_Municipal\064429004 - Rockwell W&S Replacements\5_Design\DWG\Plan Sheets\Whitmore Dr.dwg

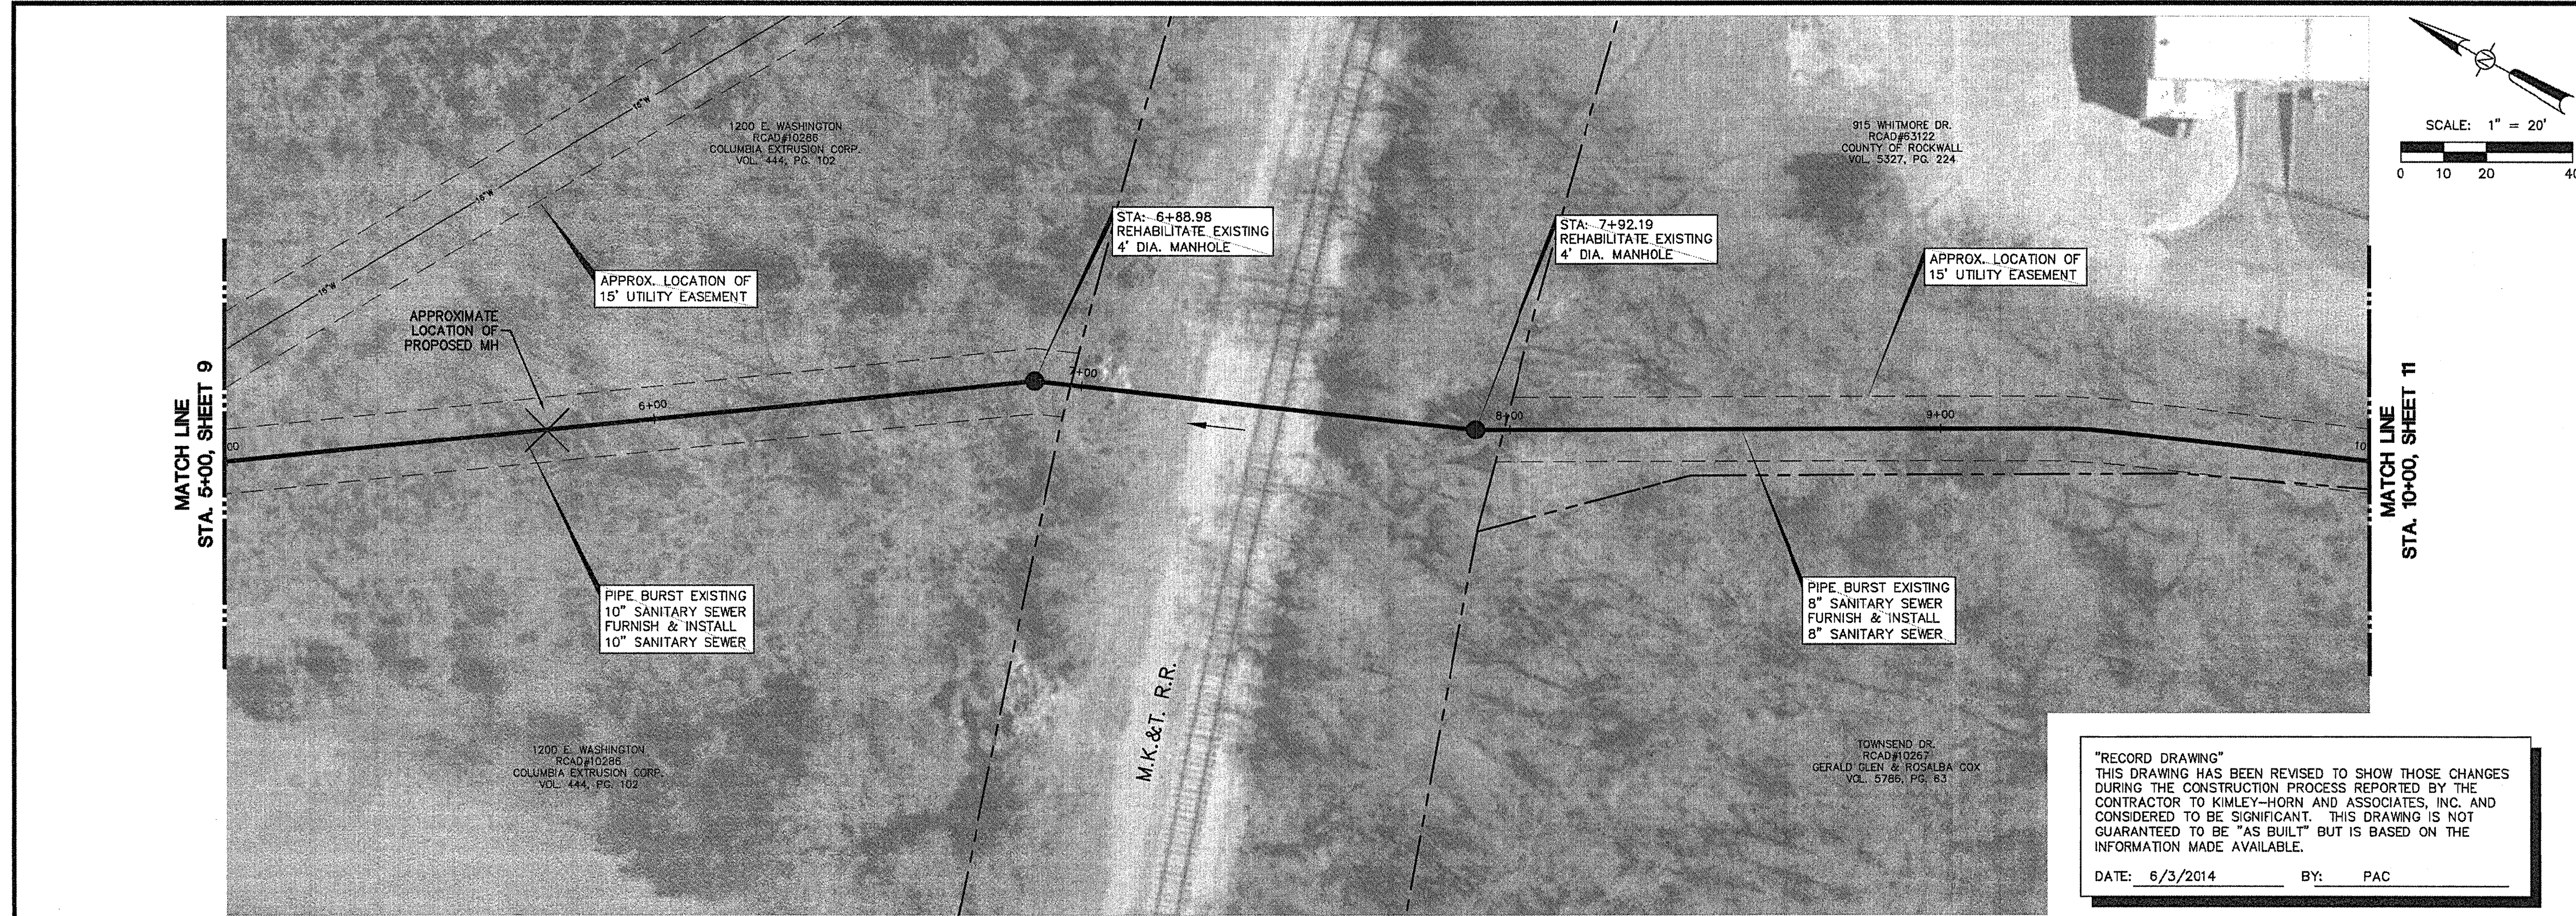

Kimley-Horn and Associates, Inc.
Professional Seal
No. 1
Revision
RECORD DRAWINGS
By: PAC
Date: 6/3/14

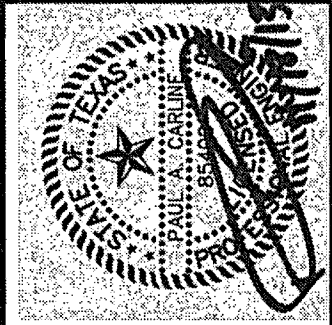

**City of Rockwall
Trenchless Sewer
Rehabilitation**

**WHITMORE DRIVE TO
RENFRO STREET
SEWER
PLAN & PROFILE**

DATE:	NOVEMBER 2013
DESIGN:	PAC
DRAWN:	JAS
CHECKED:	MSP
SHA. NO.:	064429004

SHEET
10

REF2
FOR REFERENCE ONLY