

PAVING, GRADING, DRAINAGE & UTILITIES

FOR

PARK PLACE WEST - PHASE TWO

IN THE

CITY OF ROCKWALL

ROCKWALL COUNTY, TEXAS

INDEX

COVER

B1-B2 BOUNDARY SURVEY

T1 TOPOGRAPHIC SURVEY

P1-P4 FINAL PLAT - PHASE II

1 TYPICAL SECTIONS, GENERAL NOTES & DETAILS

2 OVERALL PLAN

3 PLAN & PROFILE - ALUMINUM PLANT RD. AND WASHINGTON ST.

△ 3A WASHINGTON STREET PLAN & PROFILE

4 PLAN & PROFILE - PARK PLACE & ST. THOMAS

5 PLAN & PROFILE - PARK PLACE & ST. CHARLES

6 PLAN & PROFILE - IVY LANE

7 PLAN & PROFILE - JORDAN FARM CIRCLE

8 ALLEY PROFILES

9 DRAINAGE AREA MAP

10 POND "A" DETENTION DETAILS

11 POND "B" DETENTION DETAILS

12 STORM SEWER PLAN & PROFILE LINES "A", "B" & "C"

13 STORM SEWER PLAN & PROFILE LINES "D" & "E"

14 STORM SEWER PLAN & PROFILE LINES "F", "G" & "H"

15 OVERALL UTILITY PLAN

16 WATER & SANITARY SEWER PLAN - AREA I

17 WATER & SANITARY SEWER PLAN - AREA II

18 WATER & SANITARY SEWER PLAN - AREA III

19 OFFSITE WATER PLAN & PROFILE

20 SANITARY SEWER PROFILES LINES "A" & "B"

21 SANITARY SEWER PROFILES LINES "B-1", "B-2" & "C"

22 SANITARY SEWER PROFILES LINES "C-1", "D" & "D-1"

23 LOT GRADING PLAN - AREA I

24 LOT GRADING PLAN - AREA II

25 LOT GRADING PLAN - AREA III

26 CHANNEL DETAILS

27 EROSION CONTROL PLAN

28 EROSION CONTROL DETAILS & NOTES

29 DETENTION CALCULATIONS

△ 30 ALUMINUM PLANT ROAD & WASHINGTON STREET TRAFFIC CONTROL PLAN

△ 31 SLEEVING PLAN


L1 TREESCAPE PLANS - AREA I

L2 TREESCAPE PLANS - AREA II

L3 TREESCAPE PLANS - AREA III

OWNER:
 COLUMBIA EXTRUSION CORP.
 1200 E. WASHINGTON
 ROCKWALL, TEXAS 75087
 PH: (972) 771-7109


PLANNER:
 RAMSAY-IVY COMPANY
 2235 RIDGE ROAD #104
 ROCKWALL, TEXAS 75087

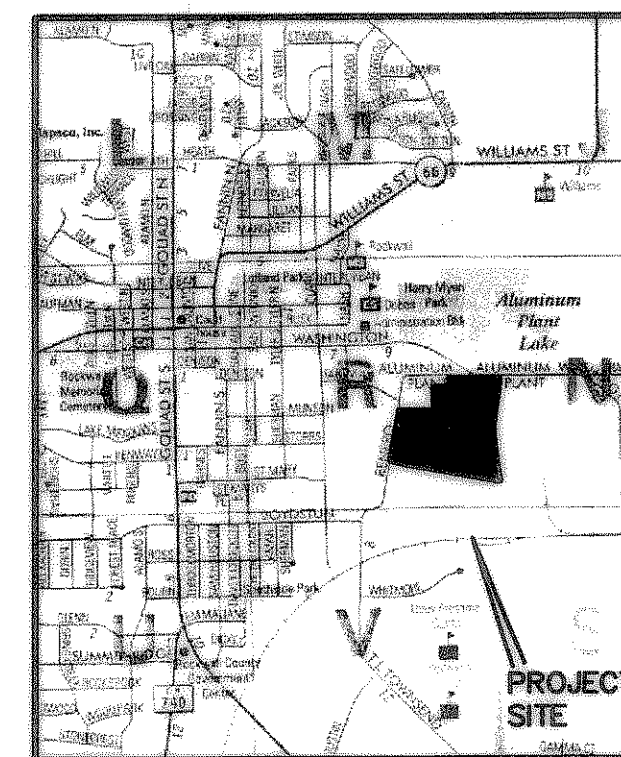

LOCATION MAP
 N.T.S.
 MAPSCO 20C-R

CONSTRUCTION RECORDS
 DATE: 11/2/06 BY: TJS
 THIS DRAWING INDICATES THE WORK COMPLETED PER INFORMATION SUPPLIED BY THE CONTRACTOR. ACTUAL ON THE GROUND SURVEY VERIFICATION WAS NOT PERFORMED EXCEPT AS SPECIFICALLY NOTED. ALL LOT AND RIGHT-OF-WAY CORNERS HAVE BEEN MARKED WITH 1/2 INCH IRON RODS.

THE SEAL APPEARING ON THIS DOCUMENT WAS AUTHORIZED BY THOMAS P. JONES, P.E. 58887, ON 10/01/04

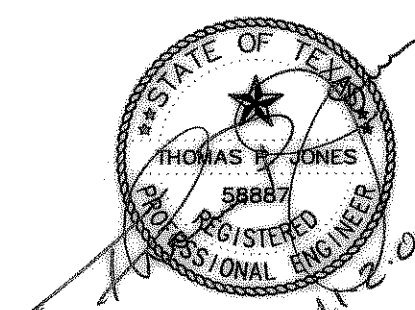

DATE: 11/02/06 CONSTRUCTION RECORDS
 DATE: 06/27/05 CONSTRUCTION ISSUE
 DATE: 06/16/05 5th SUBMITTAL
 DATE: 05/19/05 4th SUBMITTAL
 DATE: 04/07/05 3rd SUBMITTAL
 DATE: 02/25/05 2nd SUBMITTAL
 DATE: 01/10/05 1st SUBMITTAL

TOMDEN ENGINEERING, L.L.P.
 12655 N. Central Expwy., Suite 1016
 Dallas, Texas 75243
 Ph: 972.386.6446 Fax: 972.386.6409
 mail@tomden.com