

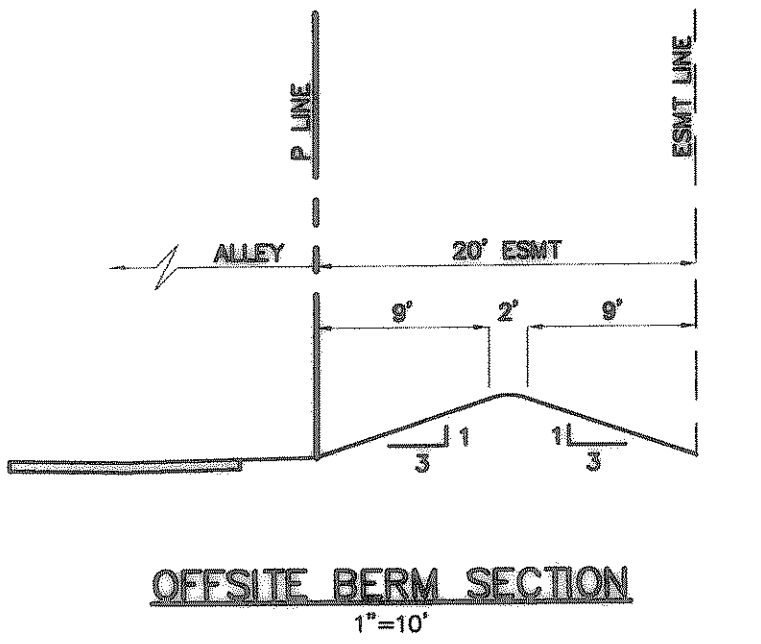


S:\Land Projects 2004\295-07.dwg\01C02A11.dwg 6/10/2005 9:23:03 AM CST

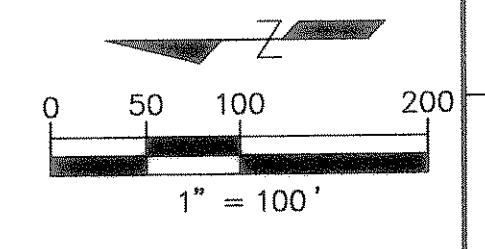

No.	Date	Revisions	App.

THE SEAL APPEARING ON THIS DOCUMENT WAS AUTHORIZED BY THOMAS P. JONES, P.E. 5887, ON 07/29/05.

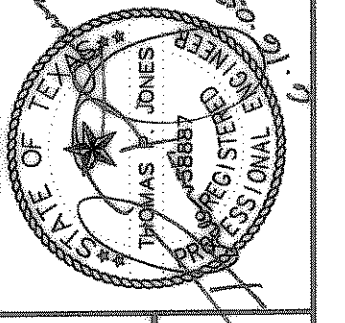

**PARK PLACE - WEST PHASE II**  
 OWNER:  
 COLUMBIA EXTRUSION CORP.  
 200 WASHINGTON  
 ROCKWALL, TX 75087  
 872.771-7108

**OVERALL PLAN**

Scale: 1" = 100'  
 Designed by T.P.J.  
 Drawn by R.V.A.  
 Checked by T.P.J.  
 /dwg/293-02/01C02PAVING.dwg  
 Date: 06/10/05 09:23

**CONSTRUCTION RECORDS**  
 DATE: 11/2/05 BY: T.P.J.  
 THIS DRAWING INDICATES THE WORK COMPLETED PER INFORMATION SUPPLIED BY THE CONTRACTOR. ACTUAL ON THE GROUND SURVEY VERIFICATION WAS NOT PERFORMED EXCEPT AS SPECIFICALLY NOTED. ALL LOT AND RIGHT-OF-WAY CORNERS HAVE BEEN MARKED WITH 1/2" HIGH IRON RODS.

SHEET  
**2**  
 OF

TOMDEN ENGINEERING, L.L.P.  
 12655 N. Central Expwy., Suite 1016  
 Dallas, Texas 75243  
 Ph: 972.386.6446 Fax: 972.386.6409  
 mail@tomden.com