

- 100-YEAR
- A. TOTAL BYPASS AREA (B4&D4) = 6.78 AC
- B. DISCHARGE (BYPASS) =  $CA = (0.90)(3.90)9.80 = 34.40$  CFS
- C. DISCHARGE (BYPASS) =  $CA = (0.35)(2.88)8.3 = 8.37$  CFS
- D. TOTAL ON-SITE AREA = 28.67 AC
- E. DISCHARGE (ON-SITE) =  $CA = (0.35)(28.67)8.3 = 83.29$  CFS
- F. TOTAL ON-SITE BYPASS AREA (K1) = 1.28 AC
- G. DISCHARGE (ON-SITE BYPASS) =  $CA = (0.90)(1.28)9.8 = 8.32$  CFS
- H. ALLOWABLE ON-SITE DISCHARGE =  $83.29 - 8.32 = 76.97$  CFS
- I. ALLOWABLE DISCHARGE FROM POND =  $(B+C+H) = 34.40 + 8.37 + 76.97 = 119.74$  CFS

Determine  $Q_p$  for developed off-site areas (Bypass) 3.90 ac

Tc	A	C	I	Qp
10	3.90	0.90	9.80	34.40
20	3.90	0.90	8.30	29.13
30	3.90	0.90	6.90	24.22
40	3.90	0.90	5.80	20.38
50	3.90	0.90	5.00	17.55
60	3.90	0.90	4.50	15.80
70	3.90	0.90	4.00	14.04
80	3.90	0.90	3.75	13.16

Determine Storage Volume Required for developed Bypass Areas

$Q_a = 34.40$

$T_c = 10$

Time	Inflow = $T_c Q_p^{60}$	Outflow = $0.5(T_c + 10) Q_a^{60}$	Storage
10	28360	28360	0
20	34960	30960	4000
30	43994	41260	2314
40	48859	51600	-2741
50	52850	61920	-9270
60	56862	72240	-15378
70	58863	82560	-23592
80	63180	92880	-29700

Determine  $Q_p$  for undeveloped off-site areas (Bypass) 2.88 ac

Tc	A	C	I	Qp
10	2.88	0.35	8.30	8.37
20	2.88	0.35	6.90	6.96
30	2.88	0.35	5.80	5.85
40	2.88	0.35	5.00	5.04
50	2.88	0.35	4.50	4.54
60	2.88	0.35	4.00	4.03
70	2.88	0.35	3.75	3.78
80	2.88	0.35	3.75	3.78

Determine Storage Volume Required for undeveloped Bypass Areas

$Q_a = 8.37$

$T_c = 10$

Time	Inflow = $T_c Q_p^{60}$	Outflow = $0.5(T_c + 10) Q_a^{60}$	Storage
10	10040	7533	2507
20	12519	10044	2475
30	14831	12555	1476
40	15120	15066	54
50	16330	17577	-1247
60	16934	20088	-3154
70	18144	22599	-4455
80			

Determine  $Q_p$  for On-Site Areas (Excludes area K1 - bypass)

Tc	A	C	I	Qp
10	27.38	0.47	9.80	127.05
20	27.38	0.47	8.30	107.60
30	27.38	0.47	6.90	89.45
40	27.38	0.47	5.80	75.19
50	27.38	0.47	5.00	64.82
60	27.38	0.47	4.50	58.34
70	27.38	0.47	4.00	51.86
80	27.38	0.47	3.75	48.62

Determine Storage Volume Required for On-Site Areas

$Q_a = 76.97$  (Reduced rate to account for Area K1)

$T_c = 10$

Time	Inflow = $T_c Q_p^{60}$	Outflow = $0.5(T_c + 10) Q_a^{60}$	Storage
10	76231	46182	30049
20	129126	69273	59853
30	181018	92364	68654
40	180485	115455	65010
50	194466	138546	55920
60	210024	161637	43867
70	217802	184728	33074
80	233380	207819	25541

Total Combined Storage Required at 30 min. = 73,443 CF

Determine Water Surface Elev.

Pond Overflow Elevation =	527.00					
Layer	Surface	Average	Layer	Cumulative	100-year	100-year
Elevation	Area (sf)	Area (sf)	Volume (cf)	Volume (cf)	Volume (cf)	WSEL
527.00	28406					
526.00	24093	28251	26251	81489	73443	526.35
525.00	19032	21563	21563	55216		
524.00	13882	16457	16457	38656		
523.00	8993	11738	11738	17199		
522.00	997	5295	5295	5461		
521.50	0	332	166	166		

Orifice Calculation - 100YR

Flowline Elevation	521.30	feet
Orifice size "L"	44.13	inches
Orifice size "H"	36.00	inches
100-yr WSEL	526.35	feet
Exit Coefficient "C"	0.60	
Area of Opening	11.03	square feet
$Q = CA(2gh)^{1/2}$	100.08	cfs

Flowline Elevation	525.41	feet
Orifice size "L"	93.00	inches
Orifice size "H"	8.88	inches
50-yr WSEL	526.15	feet
Area of Opening	5.55	square feet
$Q = 3.087LH^{3/2}$	14.74	cfs

Flowline Elevation	526.15	feet
Orifice size "L"	103.00	inches
Orifice size "H"	2.40	inches
100-yr WSEL	526.35	feet
Area of Opening	1.72	square feet
$Q = 3.087LH^{3/2}$	4.74	cfs
Total 100yr	119.55	cfs

DISCHARGE FROM POND

EVENT	TOTAL ALLOW. RELEASE FROM POND "A" (CFS)	ACTUAL RELEASE FROM POND (CFS)
10-YEAR	85.78	85.81
25-YEAR	97.76	105.92
50-YEAR	107.50	111.96
100-YEAR	119.74	119.55

**POND "A"**  
 PURPOSE OF POND "A" IS TO DETAIN ON-SITE AREAS A1, B1-B3, B5, C1-2, D1-3, E1-3, F1-2, J1-J3 & K1 AND ALLOW OFF-SITE AREAS B4 & D4 TO PASS-THRU.

**EXISTING CONDITIONS**

- OFFSITE (PASS-THRU) DRAINAGE
- AREAS B4 & D4 = 6.78 ACRES
- C = 0.90 FOR DEVELOPED & 0.35 FOR UNDEVELOPED
- Tc = 10 MIN. (DEV.) & 20 MIN. (UNDEV.)




**ONSITE DRAINAGE**

- AREAS A1, B1-B3, B5, C1-2, D1-3, E1-3, F1-2, J1-J3 & K1 (Bypass) = 28.67 ACRES
- C = 0.35
- Tc = 20 MINUTES

**PROPOSED CONDITIONS**

- ONSITE DRAINAGE (EXCLUDES AREA K1 WHICH IS A FREE BYPASS)
- SF AREA = 22.58 ACRES
- OPEN SPACE AREA = 4.80 ACRES
- CA = 12.97
- Tc = 10 MINUTES

SEE SHEET 29 FOR 10, 25 & 50-YEAR POND CALCULATIONS

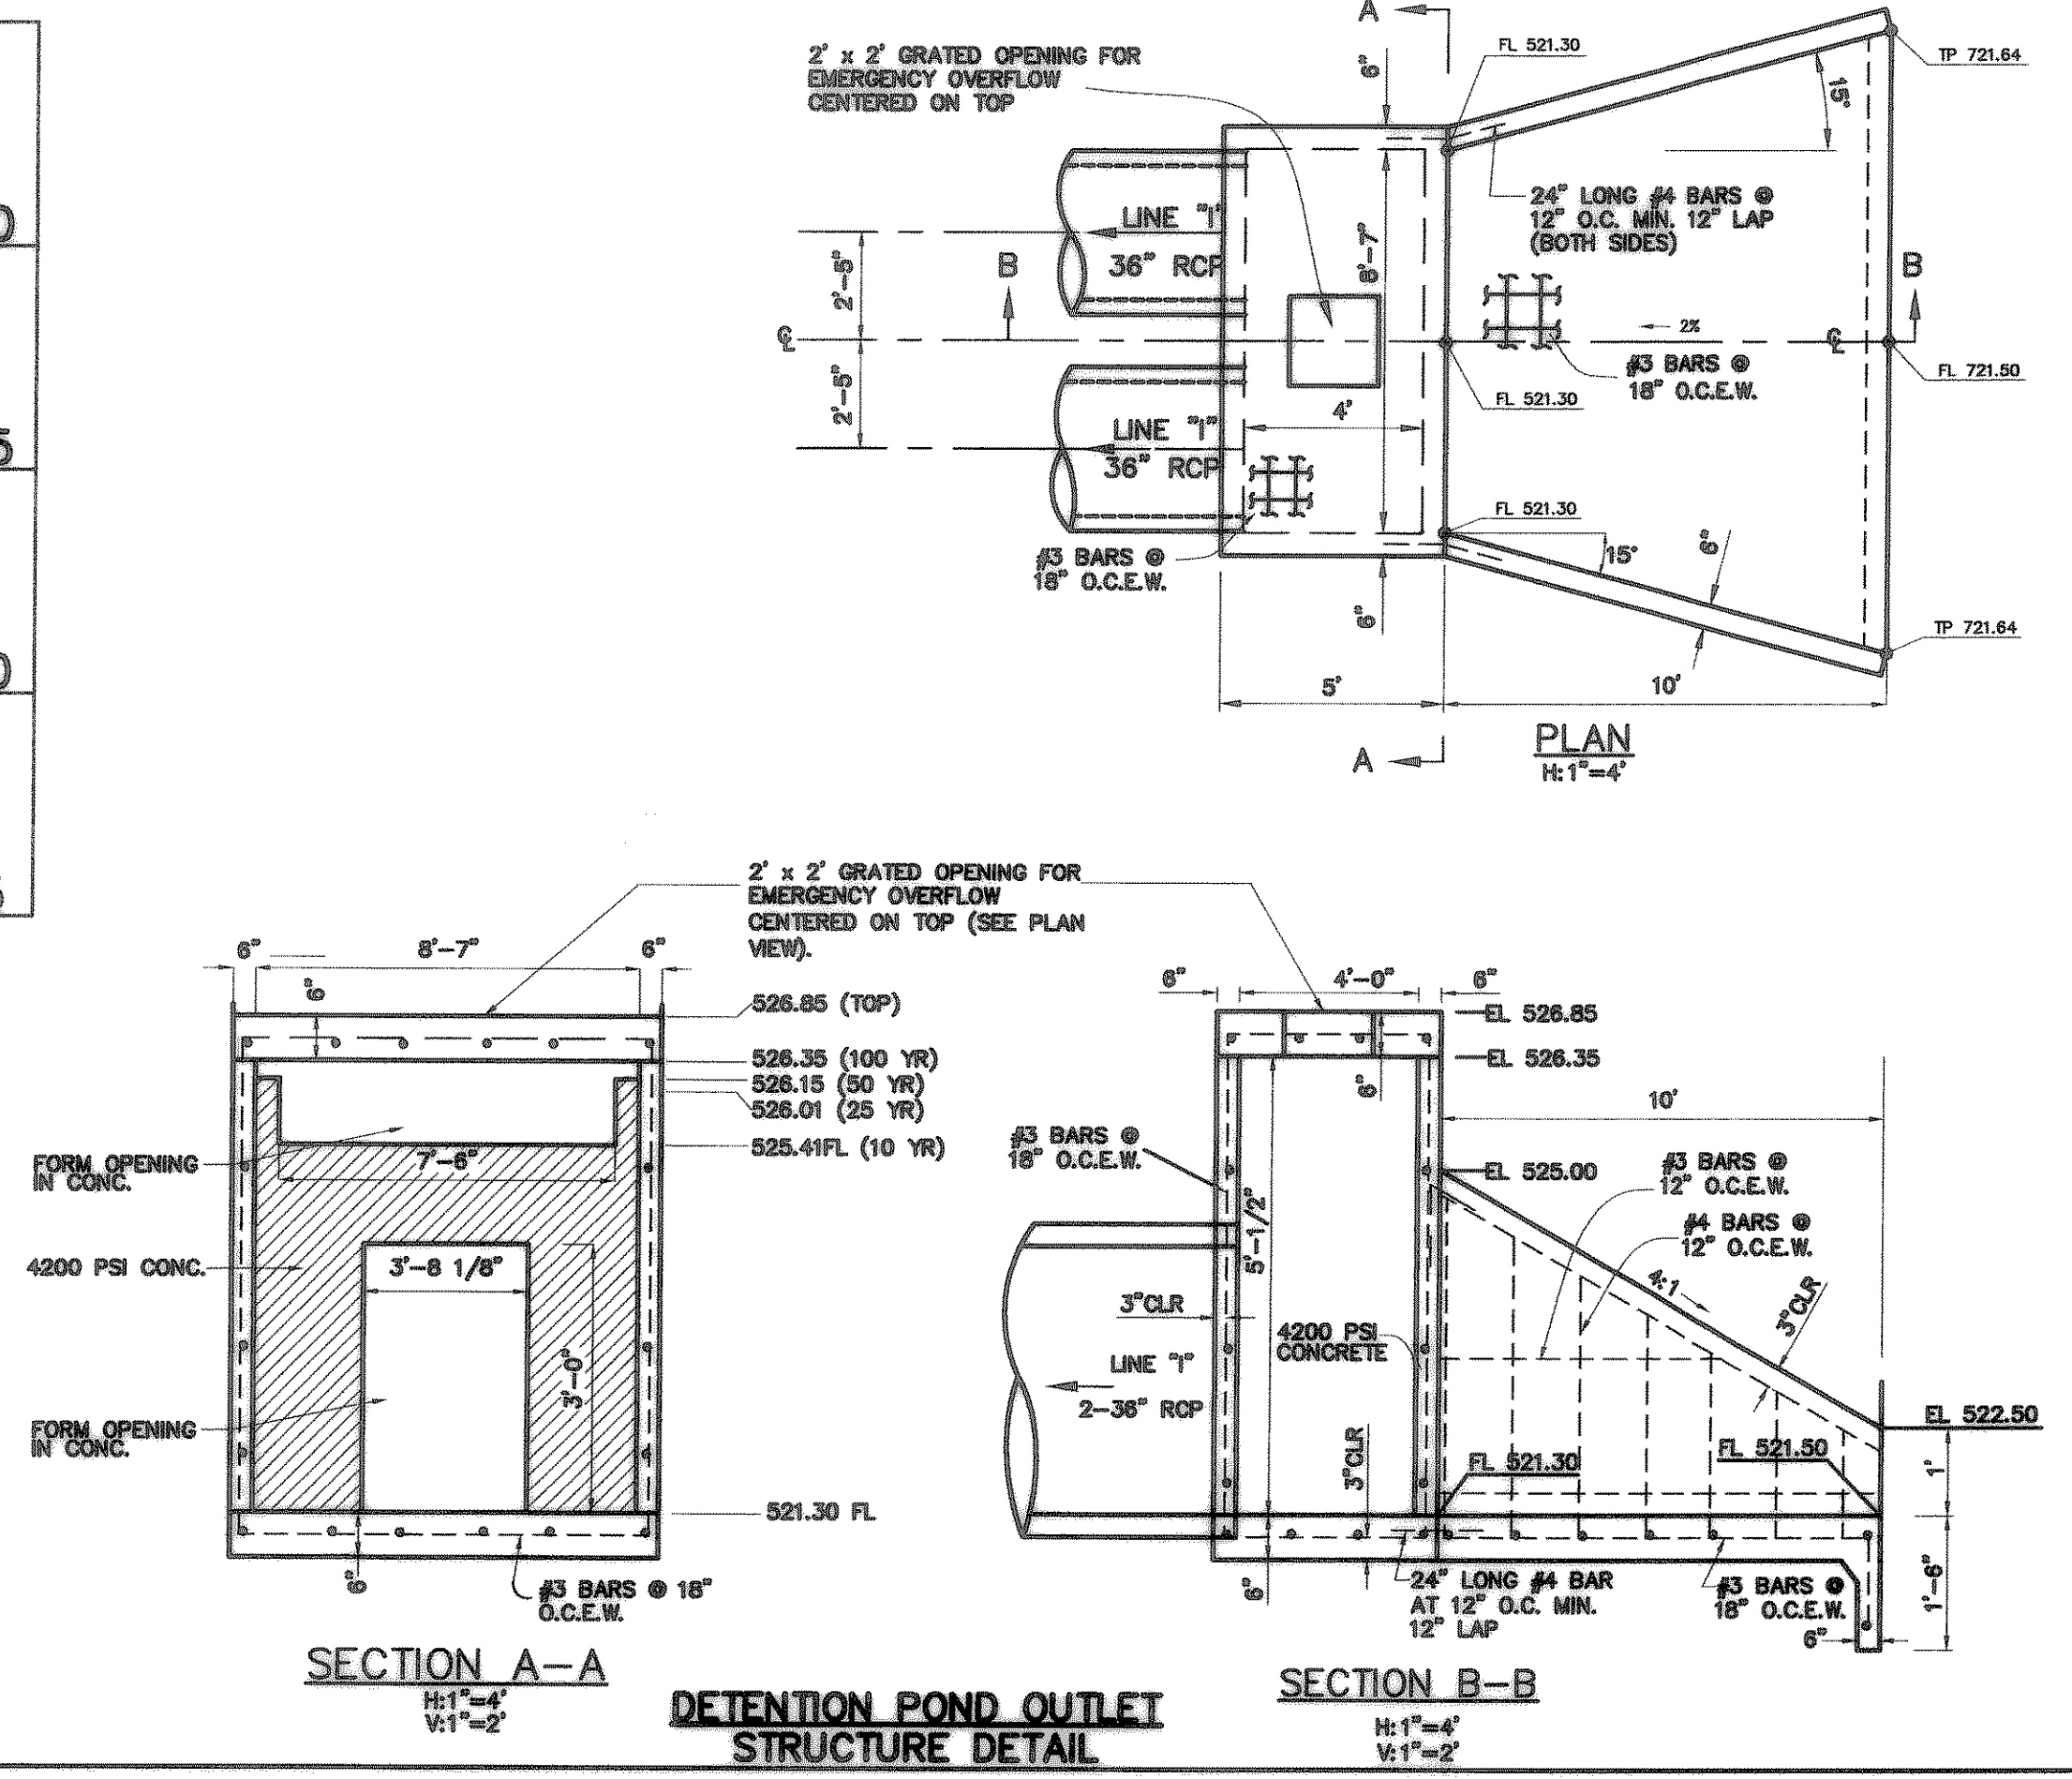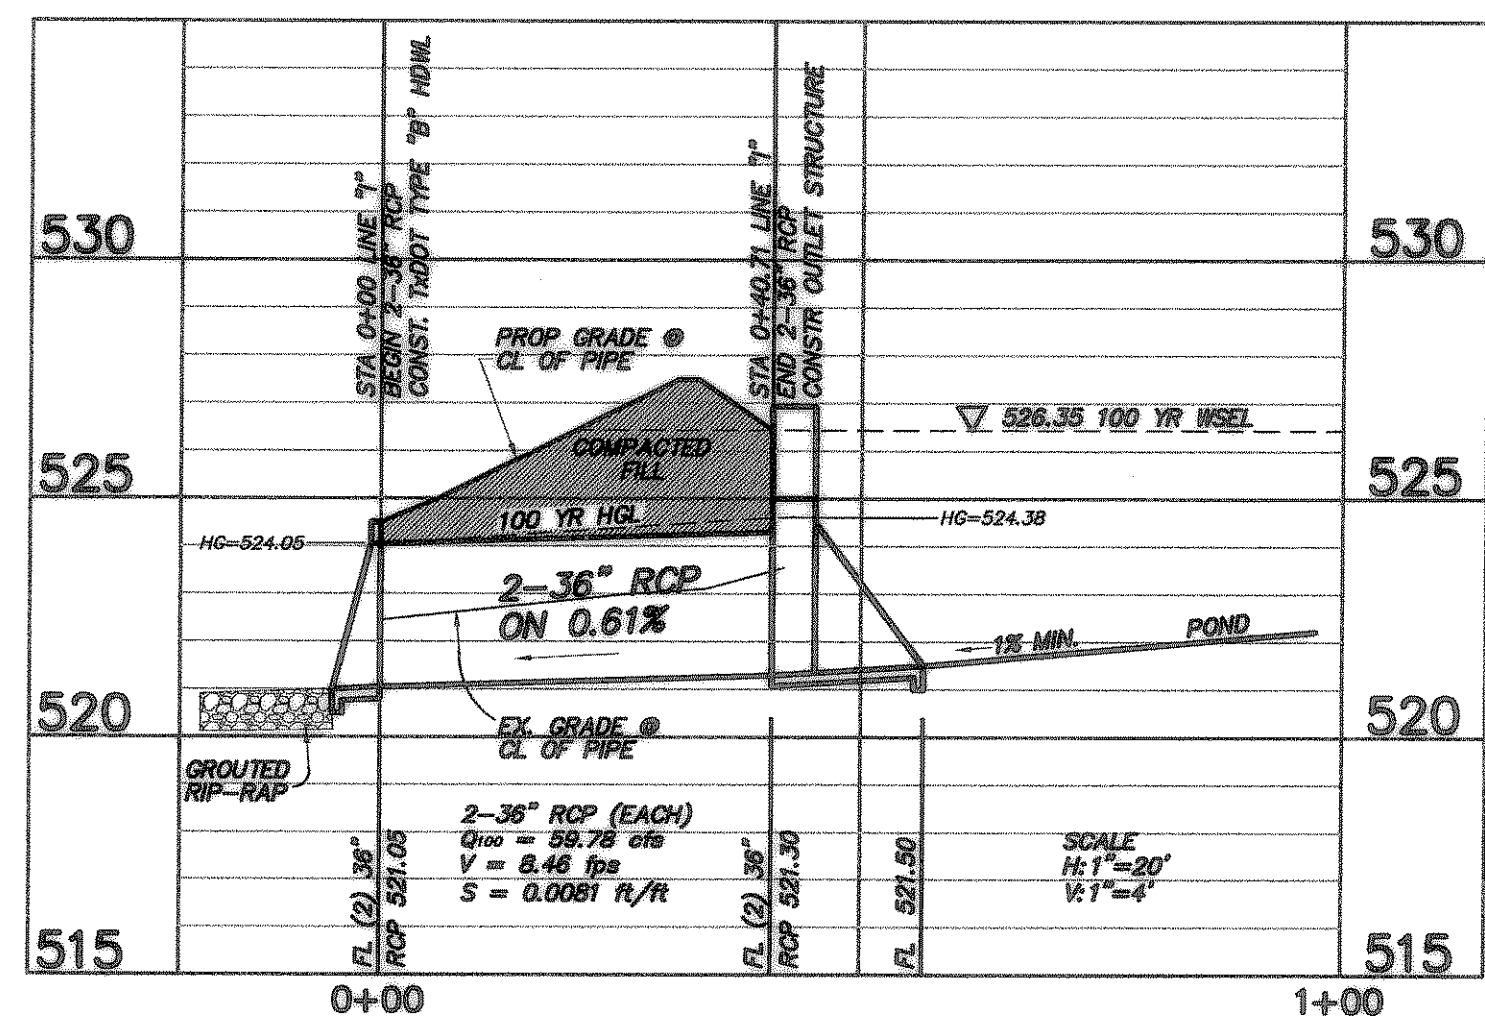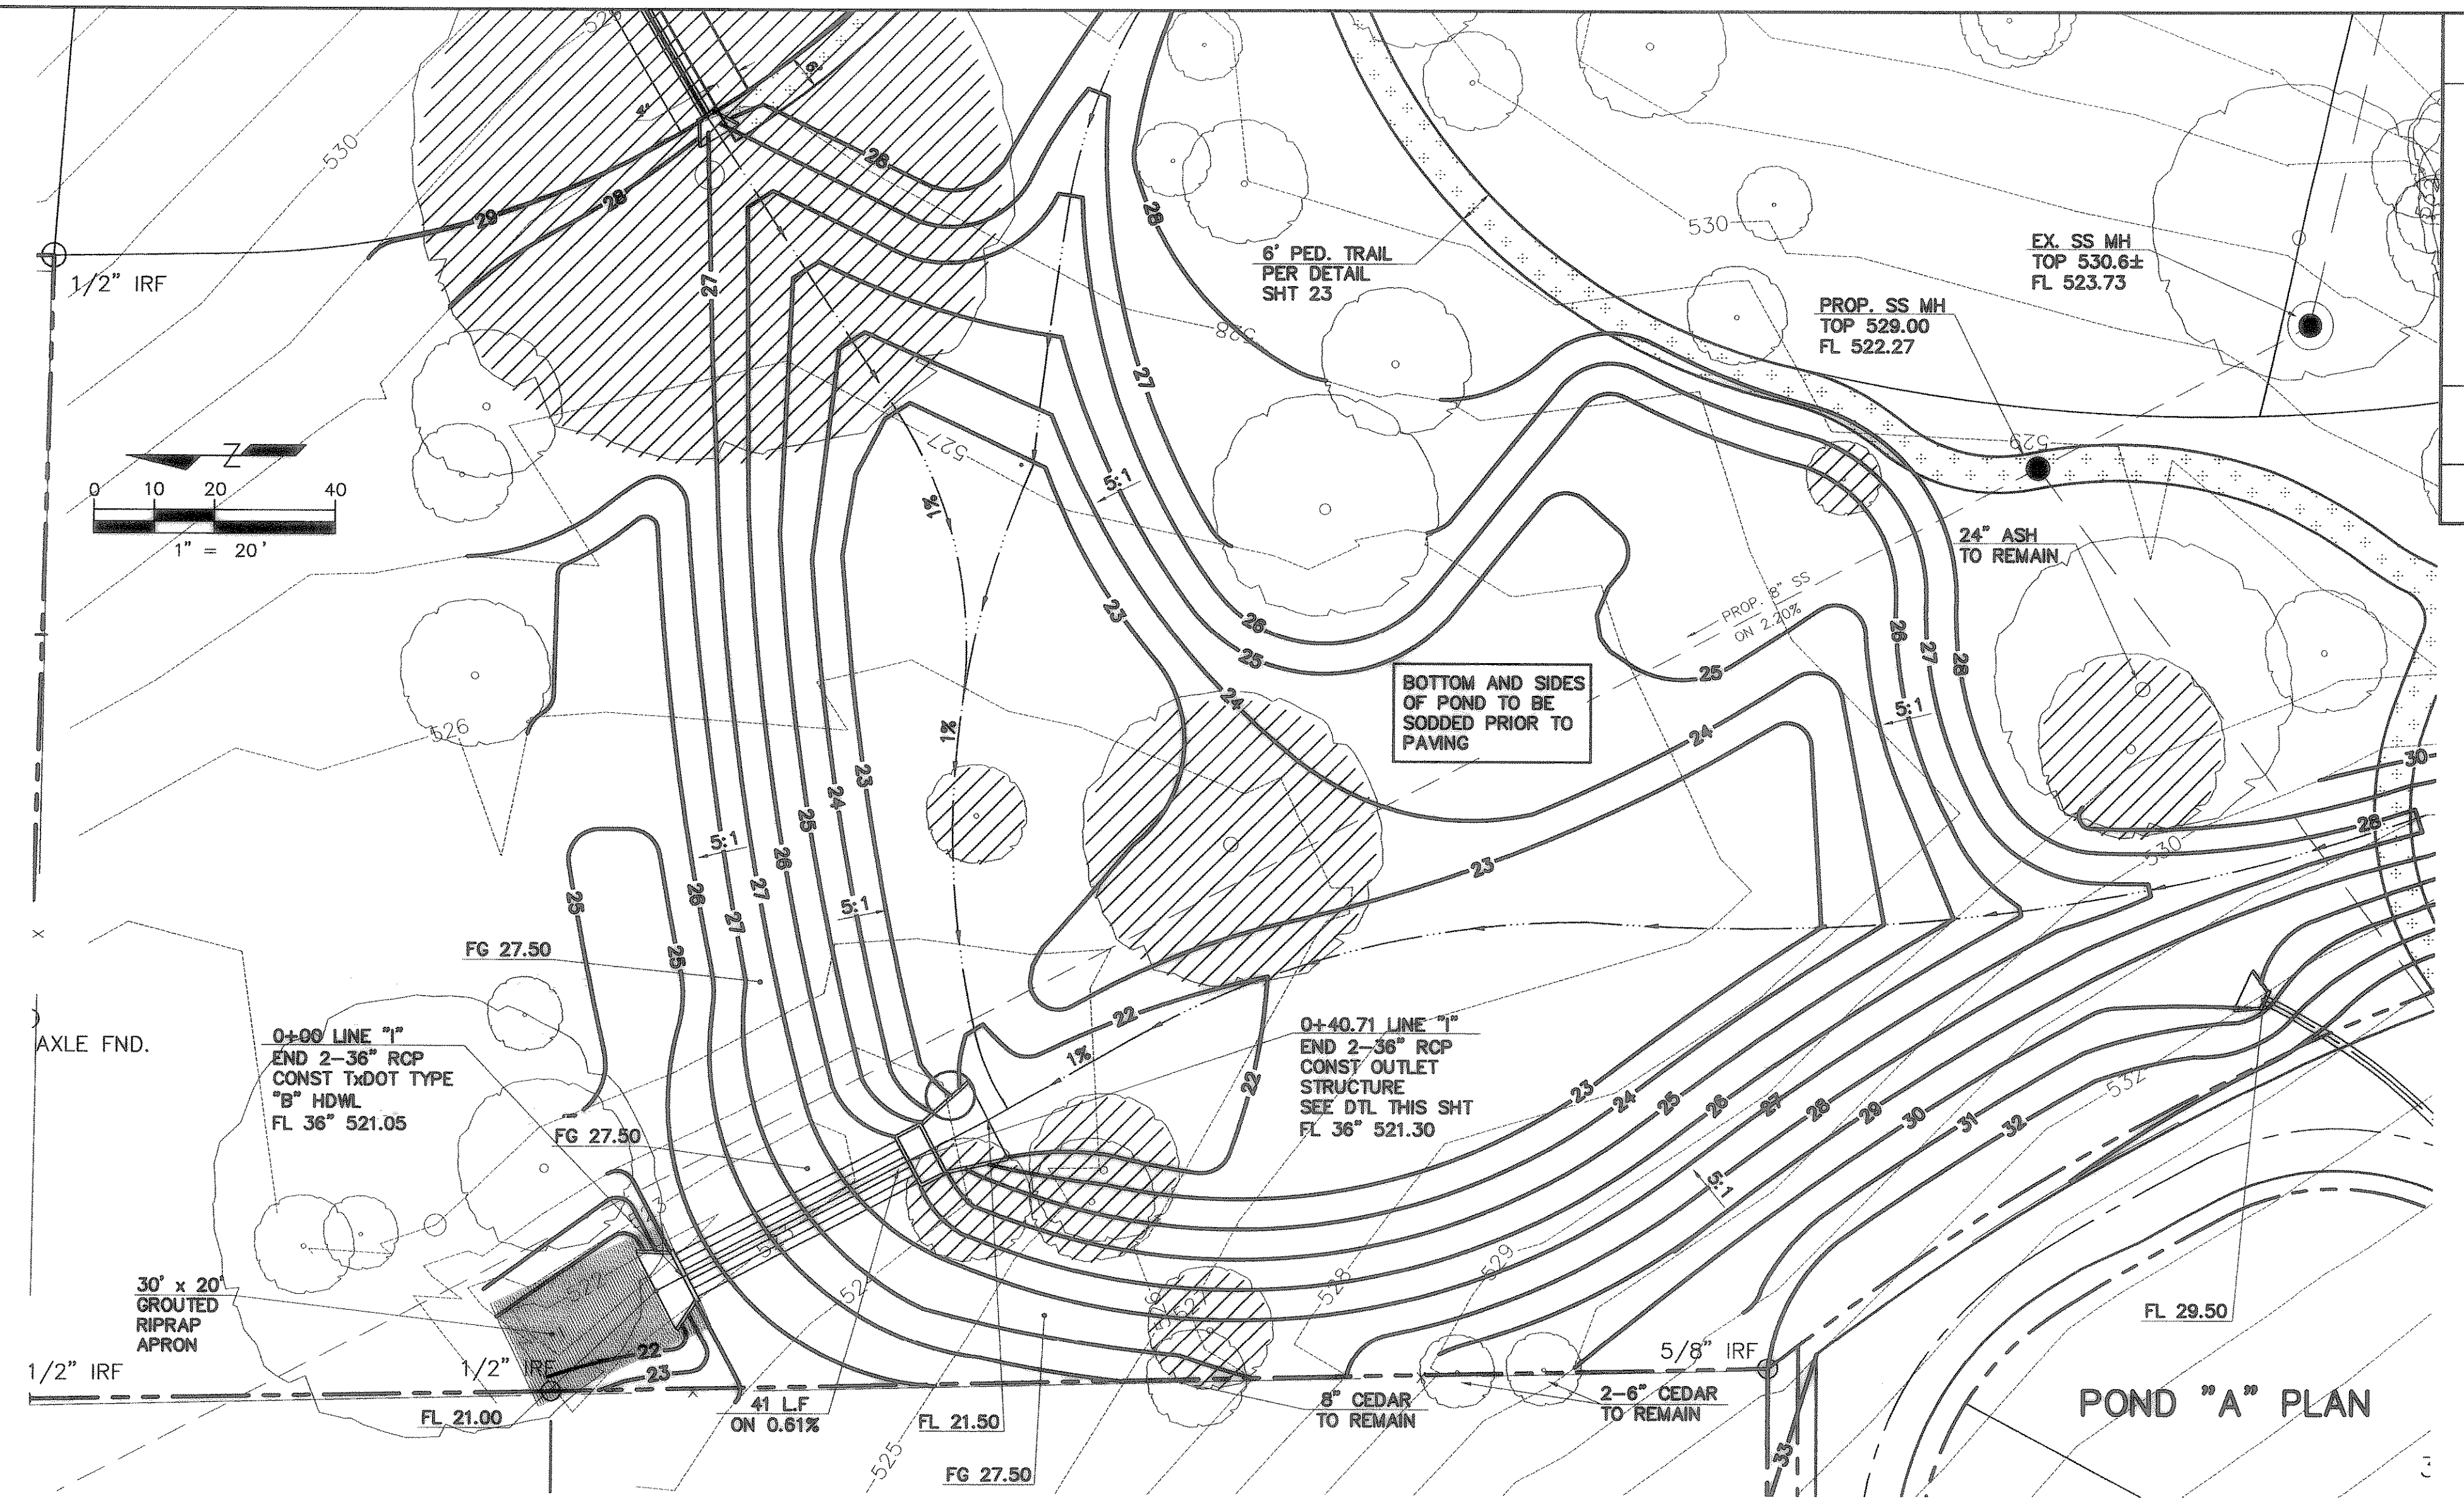

**CONSTRUCTION RECORDS**  
 DATE: 11/2/06 BY: TP  
 THIS DRAWING INDICATES THE WORK COMPLETED PER INFORMATION SUPPLIED BY THE CONTRACTOR. ACTUAL ON THE GROUND SURVEY VERIFICATION WAS NOT PERFORMED EXCEPT AS SPECIFICALLY NOTED. ALL LOT AND RIGHT-OF-WAY CORNERS HAVE BEEN MARKED WITH 1/2-INCH IRON RODS.

No.	Date	Revisions	App.

**TOMDEN ENGINEERING, L.L.P.**  
 12665 N. Central Expwy., Suite 1016  
 Dallas, Texas 75243  
 Ph: 972.386.6448 Fax: 972.386.6409  
 mail@tomden.com

**PARK PLACE - WEST PHASE II**

OWNER:  
 COLUMBIA EXTRUSION CORP.  
 ROCKWALL, TX 75087  
 972.771-7109

**POND "A" DETENTION DETAILS**

Scale: 1" = 20'  
 Designed by: T.P.J.  
 Drawn by: R.V.A.  
 Checked by: T.P.J.  
 /dwg/293-07/01C10POND.A.dwg  
 Date: 06/10/05 10:21

SHEET 10 OF