



S:\Land Projects\2004\293-07.dwg\01C16SSPRO.dwg 5/18/2005 1:38:57 PM CST

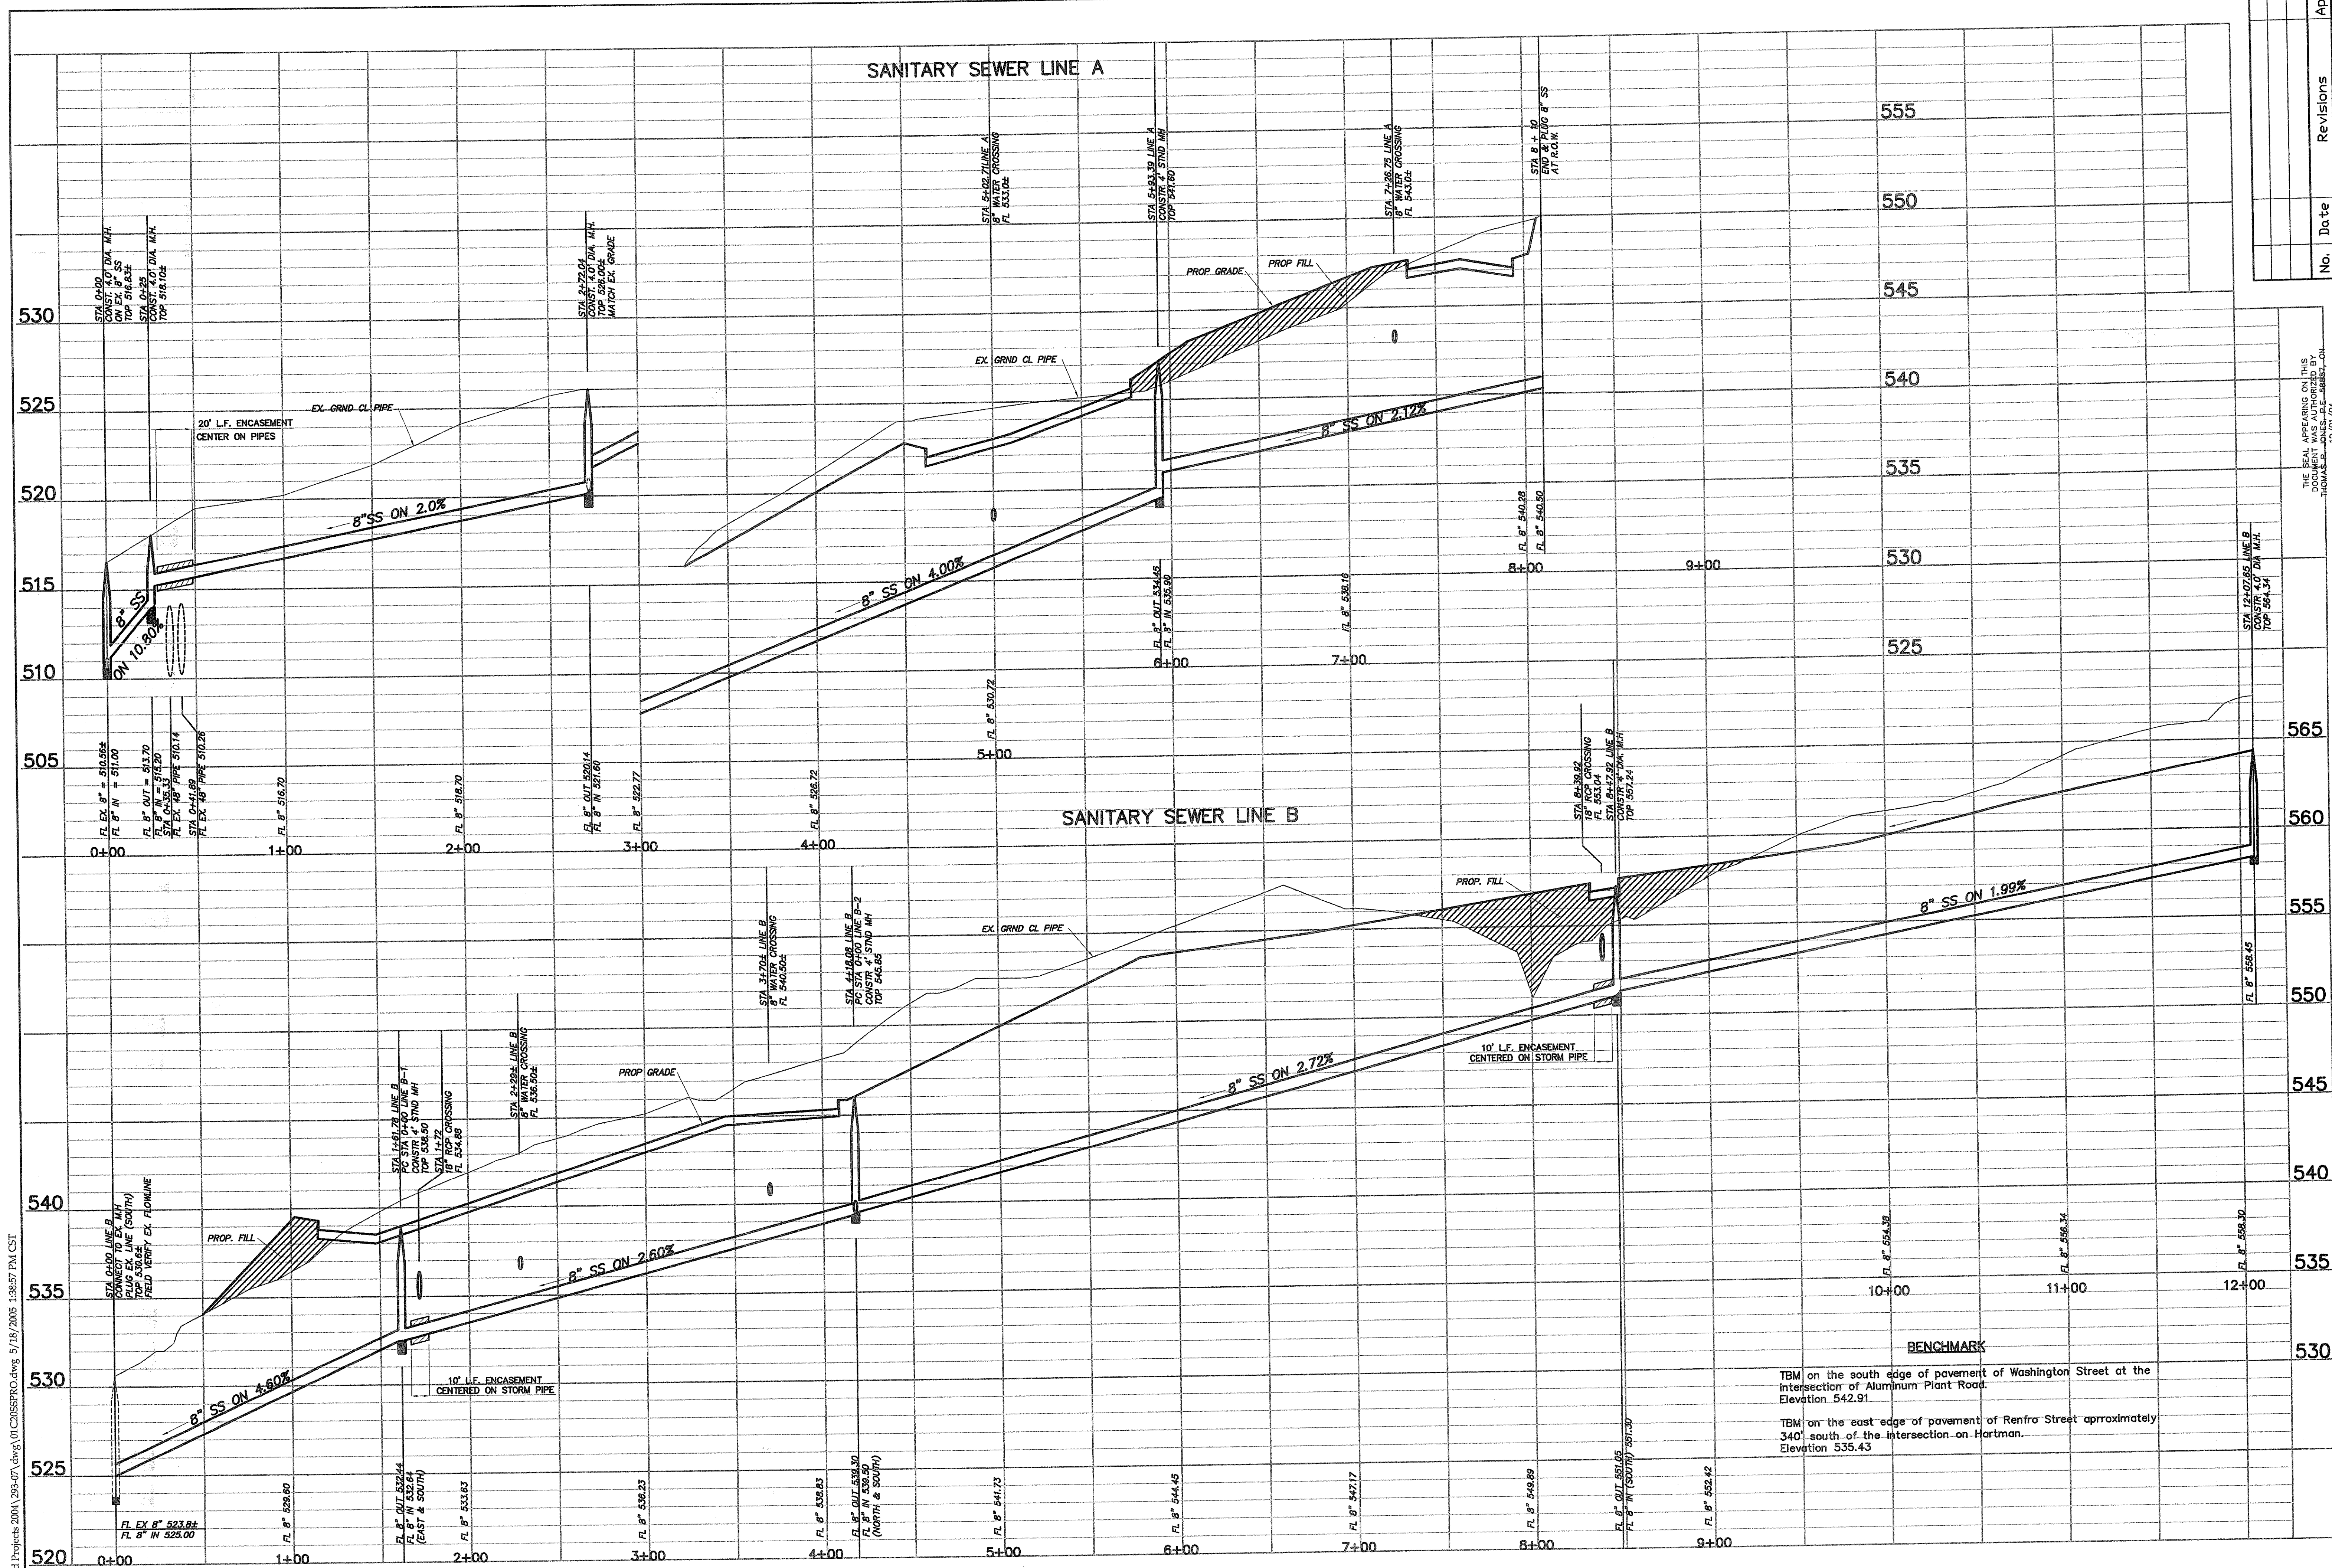

BENCHMARK
 TBM on the south edge of pavement of Washington Street at the intersection of Aluminum Plant Road. Elevation 542.91
 TBM on the east edge of pavement of Renfro Street approximately 340' south of the intersection on Hartman. Elevation 535.43

No.	Date	Revisions	App.

TOMDEN ENGINEERING, L.L.P.
 12655 N. Central Expwy., Suite 1016
 Dallas, Texas 75243
 Ph: 972.386.6446 Fax: 972.386.6409
 mail@tomden.com

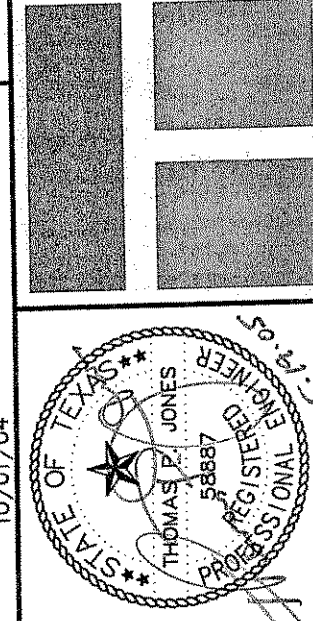

**PARK PLACE - WEST
 PHASE II**
 OWNER: HANSON CORP.
 1200 E. WASHINGTON
 ROCKWALL, TX 75087
 972.771-7109

**SANITARY SEWER
 PROFILES
 LINES "A" & "B"**

Scale: 1" = 40' H, 1" = 4' V
 Designed by: T.P.J.
 Drawn by: R.W.A.
 Checked by: T.P.J.
 /dwg/293-02/01C16SSPRO.dwg
 Date: 05/18/05 13:38